


GEORGE T. DUNHAM
SURVEYING & SUBDIVIDING
DELAVER, WISCONSIN

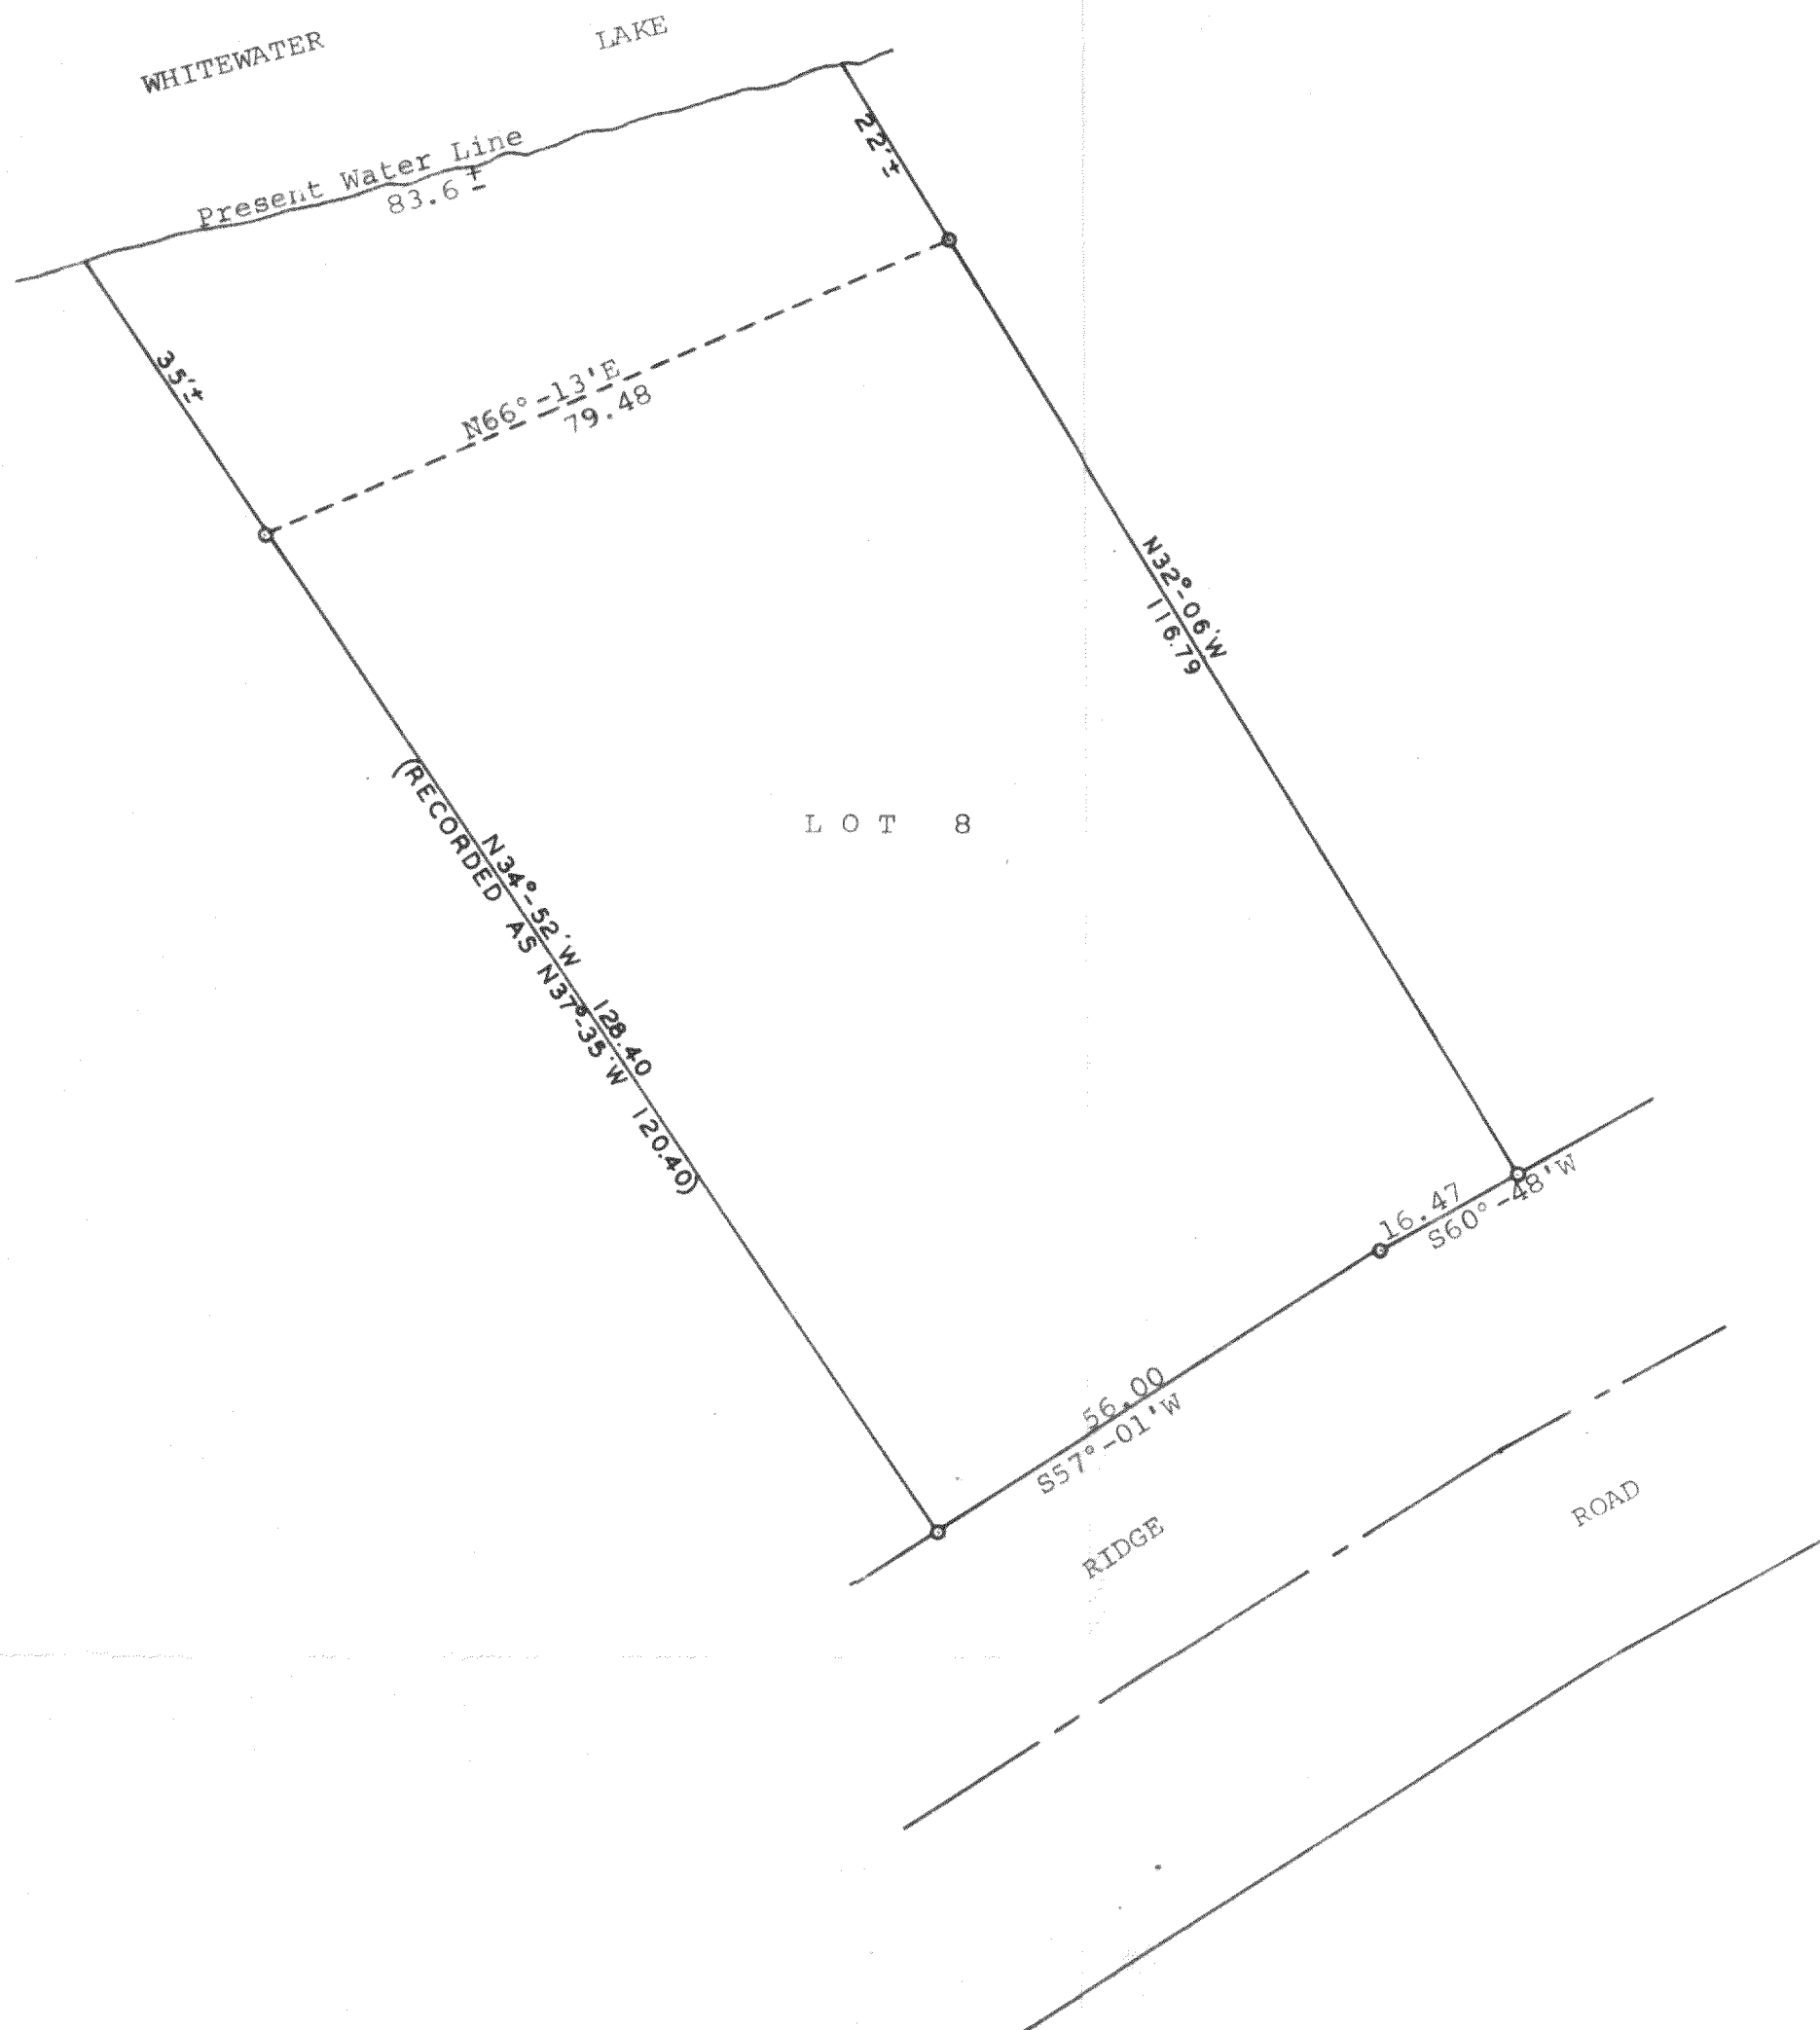


N

Scale - 1" = 20'
O = Iron Pipe

Plat of survey of Lot 8 in Block 4 of Moraine Heights, a subdivision located in Sections 26 and 35, T4N, R15E, Walworth County, Wisconsin.
August 8, 1972

George T. Dunham
George T. Dunham, Surveyor

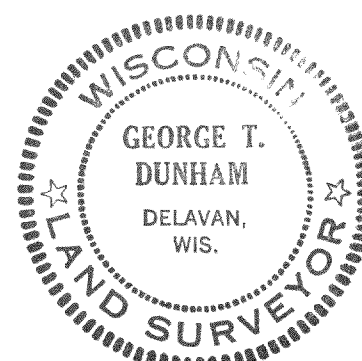

MH-91

415-120