

DT-H-19

- - IRON PIPE FOUND
- - IRON PIPE SET IN TREE STUMP
- △ - UTILITY POLE
- - OVERHEAD UTILITY LINES
- - GUY WIRE
- - UTILITY PED
- () - RECORDED AS

LEGEND

SCALE 1" = 20'



N

NOTE: BEARINGS ARE REFERENCED TO THE RECORDED SUBDIVISION PLAT.

LOT 19 OF THORNE HEIGHTS, LOCATED IN THE SOUTHEAST 1/4 AND IN THE SOUTHWEST 1/4 OF SECTION 35, T4N, R15E, WALWORTH COUNTY, WISCONSIN.


PLAT OF SURVEY OF

CERTIFIED SURVEY NO. 78

TAX PARCEL DW-35-49

ABELL
SURVEYING & MAPPING
1140 SEQUOIA STREET • DELAWARE, WISCONSIN 53115
262-728-6737

WATER LAKE

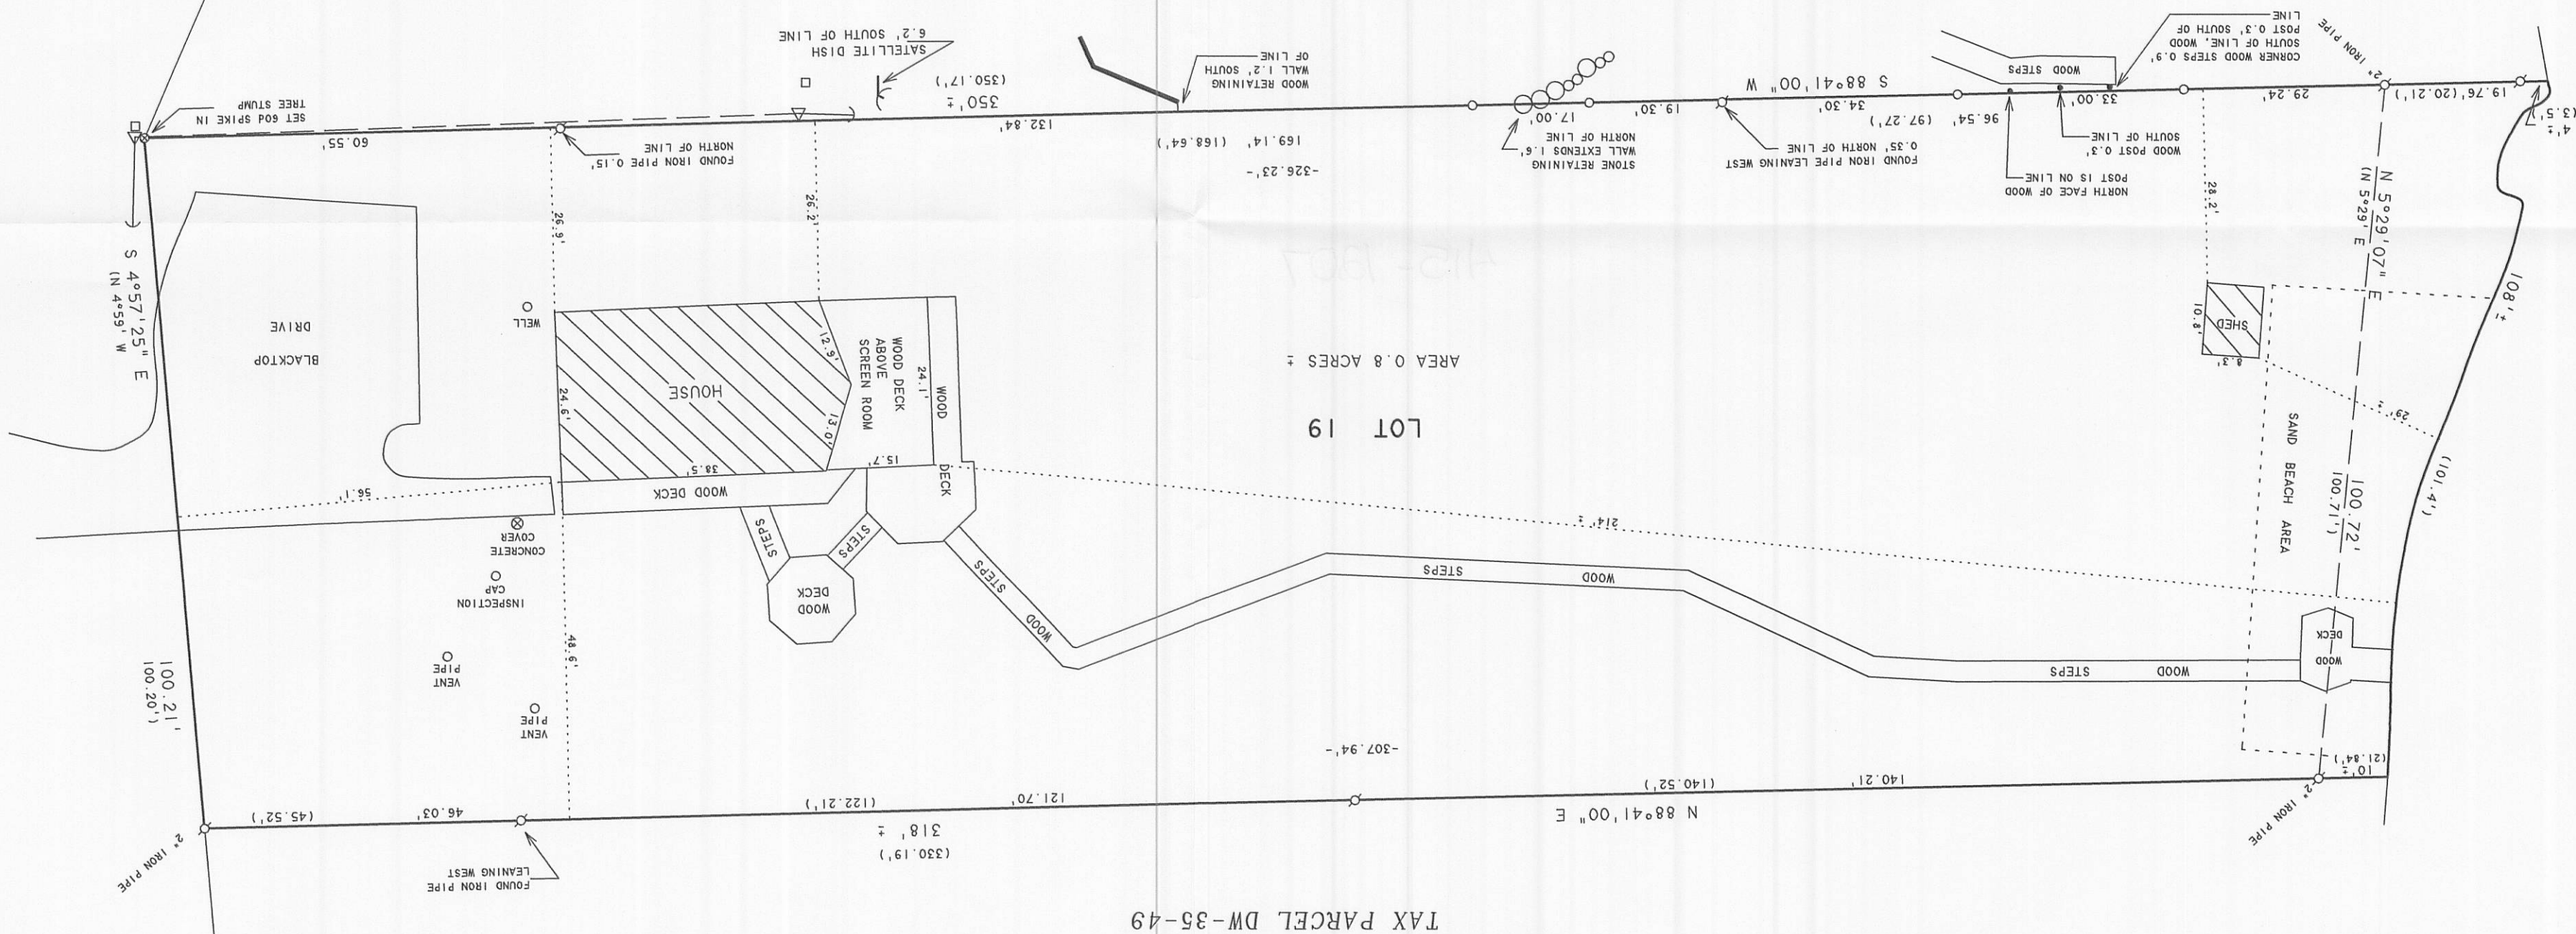

EAST SHORE DRIVE


I HEREBY CERTIFY THAT I HAVE SURVEYED THE ABOVE DESCRIBED PROPERTY AND THAT THE ABOVE MAP IS A TRUE REPRESENTATION THEREOF AND SHOWS THE SIZE AND LOCATION OF THE PROPERTY, ITS EXTERIOR BOUNDARIES, THE LOCATION OF ALL VISIBLE STRUCTURES AND DIMENSIONS OF ALL PRINCIPAL BUILDINGS THEREON, BOUNDARY FENCES, APPARENT EASEMENTS, ROADWAYS AND VISIBLE ENCROACHMENTS, IF ANY, TO THE BEST OF MY KNOWLEDGE AND BELIEF.

THIS SURVEY IS MADE FOR THE USE OF THE PRESENT OWNERS OF THE PROPERTY, AND ALSO THOSE WHO PURCHASE, MORTGAGE, OR GUARANTEE THE TITLE THERETO WITHIN ONE (1) YEAR FROM DATE HEREON.

DAVID F. ABELL
WISCONSIN REGISTERED LAND SURVEYOR, S-1596

March 22, 2010

DATE: THIS IS NOT A CERTIFIED COPY UNLESS SEALED.
JOB NUMBER - 10006A

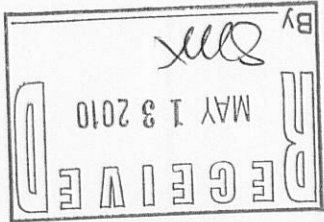

REVISOR: APRIL 6, 2010 TO SHOW THE WOOD WALK AND WOOD POSTS HAVE BEEN MOVED AND TO SHOW THE ADDITIONAL IRON PIPES THAT WERE SET ALONG THE SOUTH LINE.

ORDERED BY: ANDY SZYMANKUJ
KEEFE REAL ESTATE
1040 N. WISCONSIN ST.
ELKHORN, WI 53121