

FARRIS, HANSEN & ASSOCIATES, INC.

ENGINEERING — ARCHITECTURE — SURVEYING
7 RIDGWAY COURT — P.O. BOX 437 — ELKHORN, WISCONSIN 53121
PHONE: (262) 723-2098 FAX: (262) 723-5886


PLAT OF SURVEY

LEGAL DESCRIPTION


Lot 5, Block 2, Moraine Heights, located in the SW ¼ of the SE ¼ Section 26, and the SE ¼ of the SW ¼, Section 26, and the NW ¼ Section 35 and the NE ¼ Section 35, and the SW ¼ of Section 35, T4N, R15E, Town of Whitewater, Walworth County, Wisconsin.

Tax Key No. DMH 00039

— WORK ORDERED BY —
KEEFE REAL ESTATE
751 GENEVA PARKWAY
LAKE GENEVA, WI. 53147

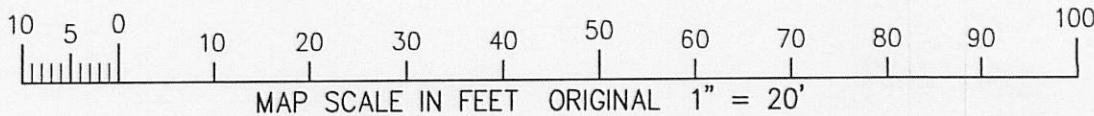

ASSIGNED THE NORTH LINE OF LOT 5
S 80°45'20" E

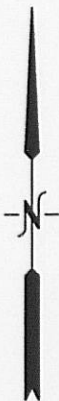

WHITENATER

LAKE

PIER

DECK

DECK

STAIRWAY

DECK

PATIO

BUILDINGS

PAVED DRIVEWAY

ASPHALT
DRIVEWAY

RIDGE ROAD

LOT 5
16,445 SQ. FT.


LOT 4

LOT 6

LEGEND

- = FOUND IRON PIPE STAKE
- = FOUND IRON REBAR STAKE
- ⊕ = UTILITY POLE
- (XXX) = RECORDED AS

SURVEYORS NOTE:
TITLE COMMITMENT FILE 67884, PREPARED BY SOUTHEASTERN WISCONSIN TITLE
COMPANY HAS EXCEPTIONS FOR DOC. NO.S 345228, AND 431093 WHICH AFFECT
LOTS 21, 22, AND 23 OF THE SUBJECT SUBDIVISION, WHICH DO NOT AFFECT
THE SUBJECT LOT.

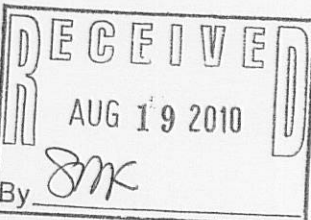

NOTE: COPIES OF THIS MAP TO WHICH THE FOLLOWING CERTIFICATE WILL APPLY SHOW
SURVEYOR'S ORIGINAL SEAL AND SIGNATURE IN RED INK. COPIES BY ANY OTHER MEANS
MAY HAVE ALTERATIONS WHICH DO NOT REPRESENT THE SURVEYOR'S WORK PRODUCT.

I HEREBY CERTIFY THAT THE ABOVE DESCRIBED PROPERTY HAS BEEN SURVEYED UNDER MY
DIRECTION AND THAT THE ABOVE MAP IS A TRUE REPRESENTATION THEREOF AND SHOWS THE
SIZE AND LOCATION OF THE PROPERTY, ITS EXTERIOR BOUNDARIES, THE LOCATION OF ALL
VISIBLE STRUCTURES, AND DIMENSIONS OF ALL PRINCIPLE BUILDINGS THEREON, BOUNDARY
FENCES, APPARENT EASEMENTS, ROADWAYS, AND VISIBLE ENCROACHMENTS, IF ANY. THIS
SURVEY IS MADE FOR THE USE OF THE PRESENT OWNERS OF THE PROPERTY, AND ALSO THOSE
WHO PURCHASE, MORTGAGE, OR GUARANTEE THE TITLE THERETO WITHIN ONE YEAR FROM THE
DATE HEREOF.

DATED: AUGUST 11, 2010

PETER S. GORDON R.L.S. 2101

AUG 11 2010