



Plat of Survey

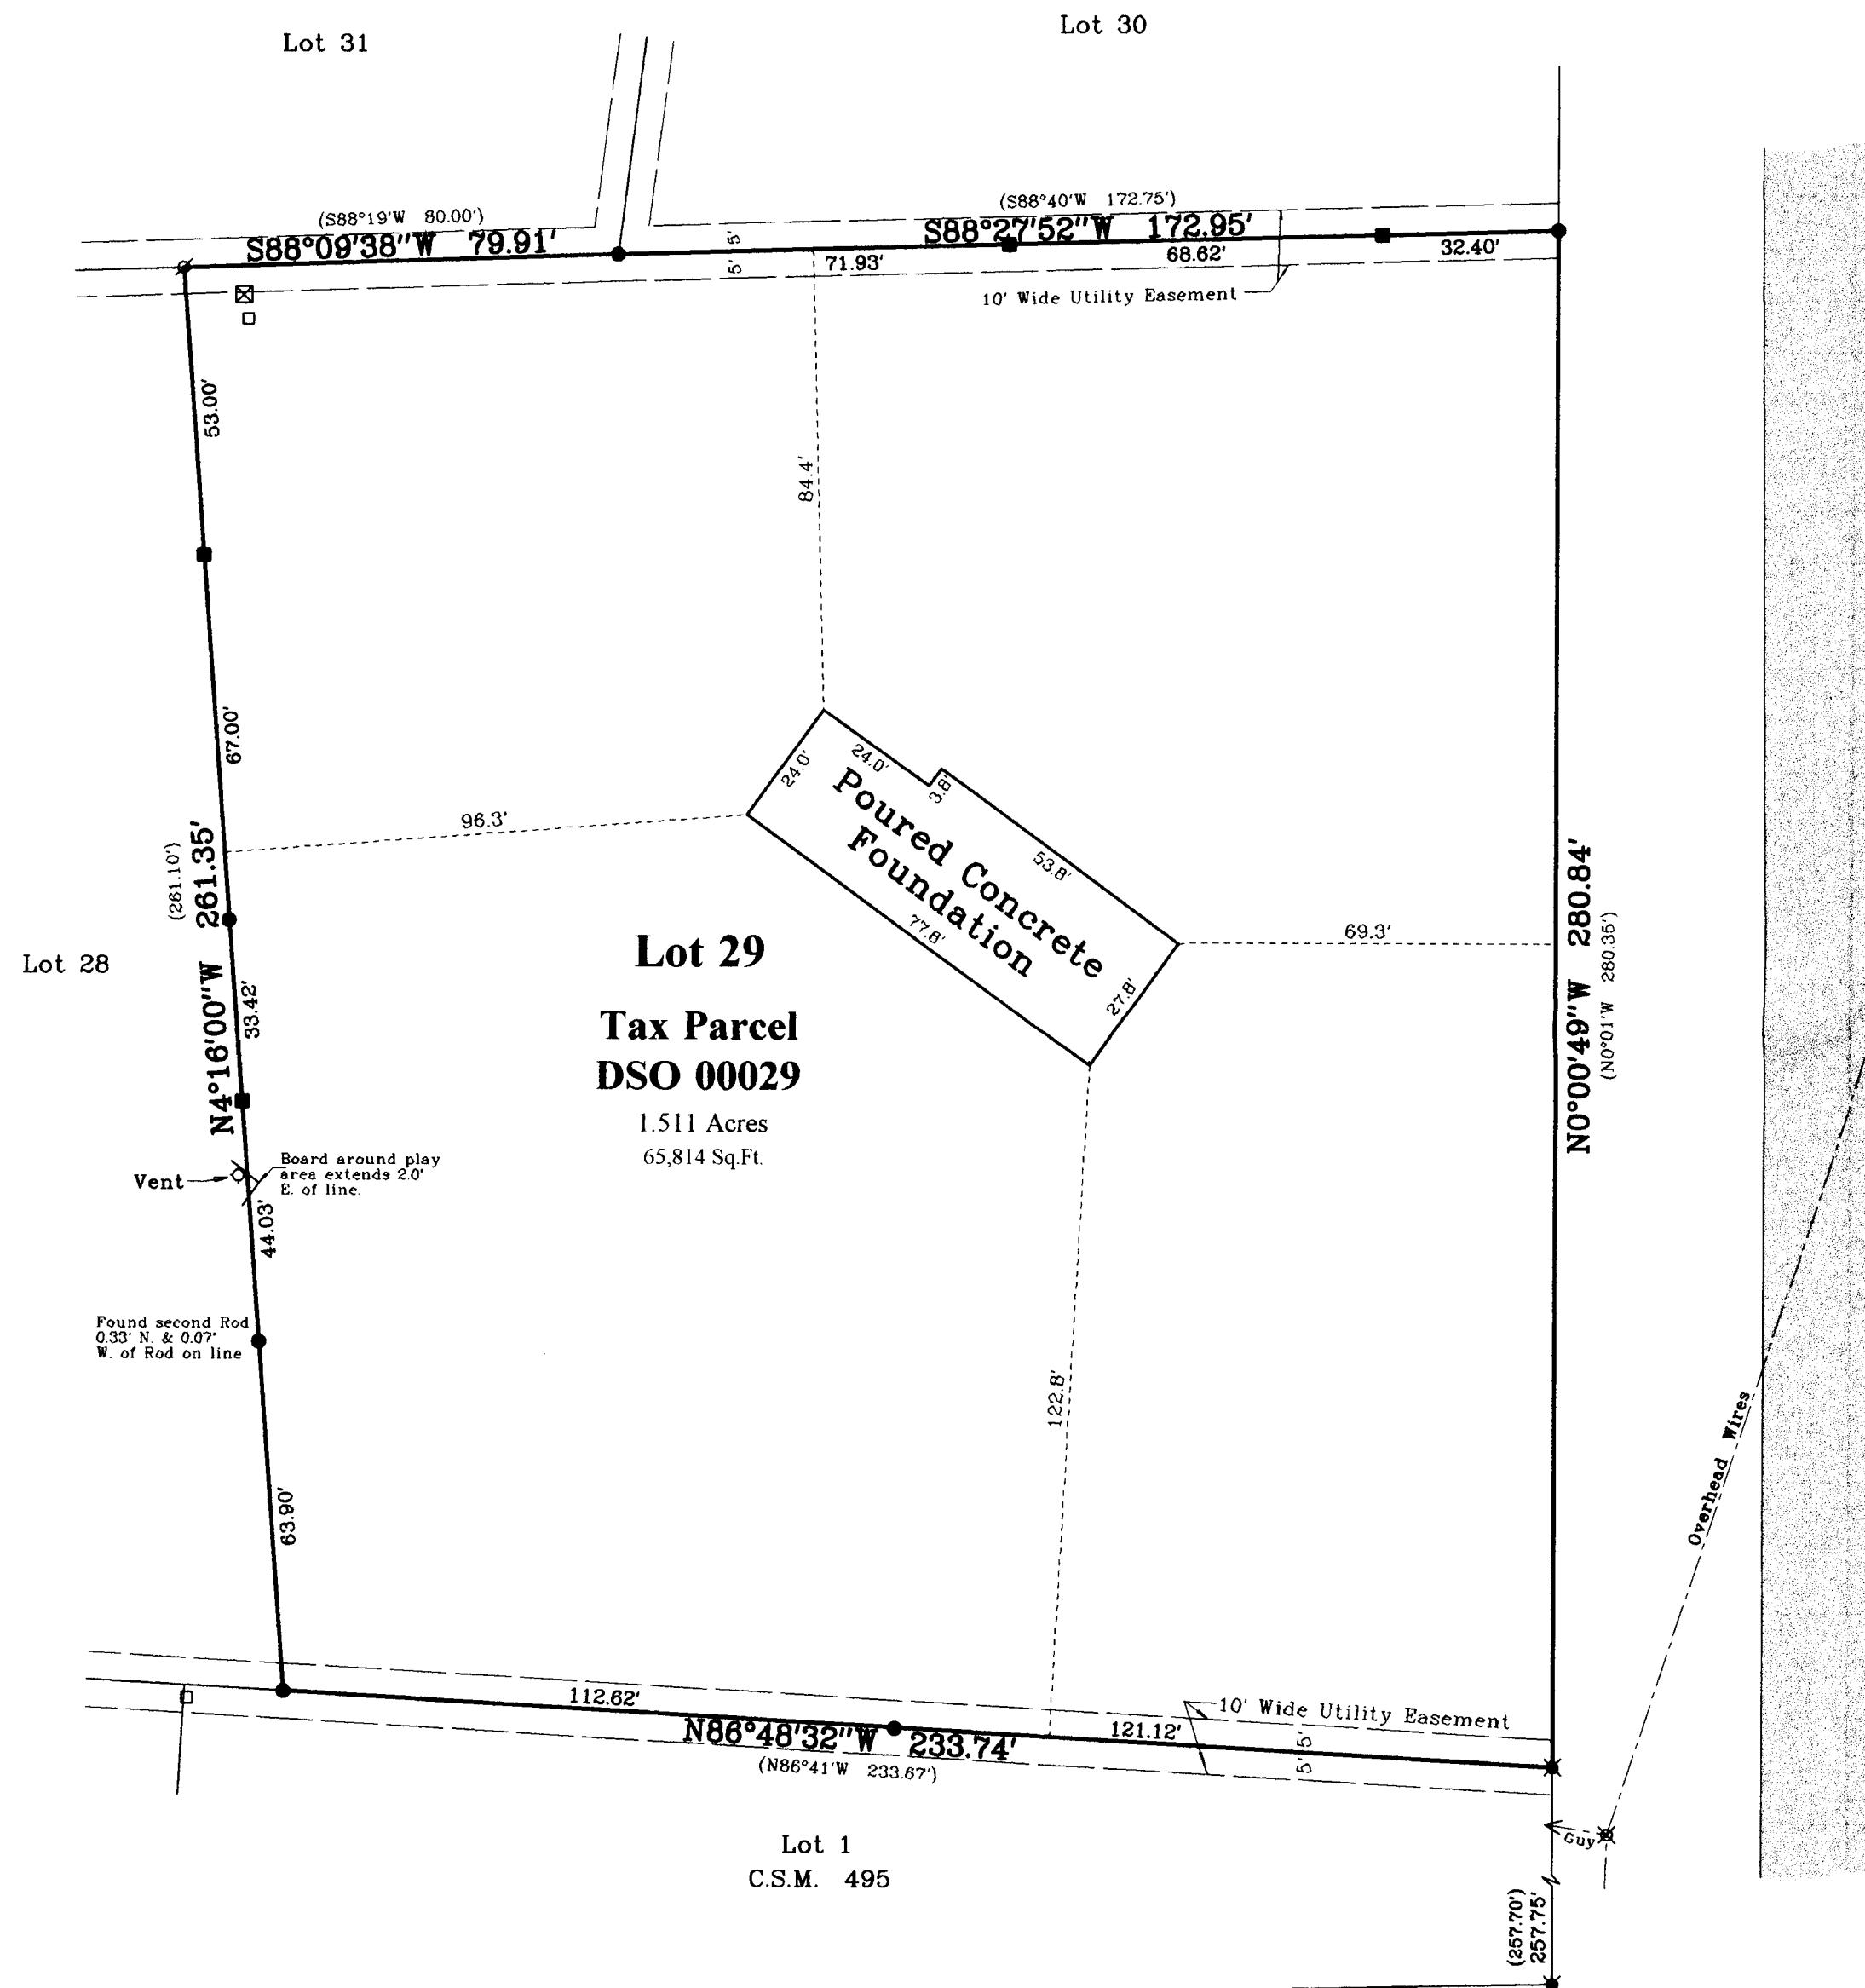

Surveyed for: **Kevin & Corey Salverson**
N7331 County Road P
Whitewater, Wisconsin 53190

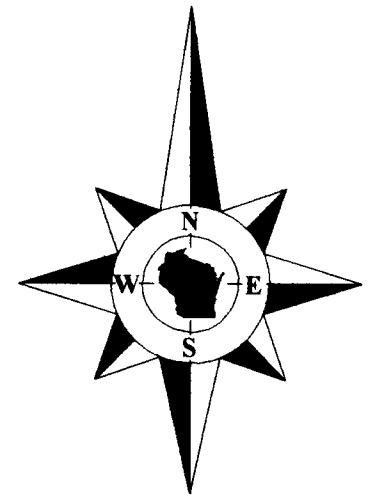


Bearings referenced to the plat of Scattered Oaks.



Notes:

- 1) This survey plat is not certified unless signed and sealed in red ink.
- 2) This survey is subject to Wisconsin lien laws. This Plat of Survey is the notice of intent to file lien. Lien waiver required.

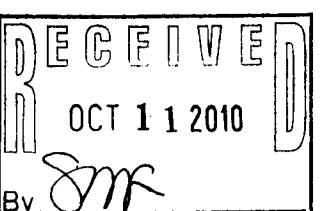

Copyright 2000 by Jensen & Olson Land Surveying, LLC.

All rights reserved. No part of this survey plat may be reproduced or transmitted in any form by any means - graphic, electronic, or mechanical, including photocopying, tracing, or information storage and retrieval systems - without permission in writing from Douglas G. Olson, Jensen & Olson Land Surveying, LLC.

I, Douglas G. Olson, Wisconsin Registered Land Surveyor, do hereby certify that this survey was performed by me, or under my direction in full compliance with the owner's/agent's instructions and Chapter A-E 7 of the Wisconsin Administrative Code "Minimum Standards for Property Surveys"; and that this map is an accurate representation thereof to the best of my knowledge and belief.

Douglas G. Olson
Wisconsin Registered Land Surveyor - 2093

415-1225

Survey Date: August 2, 2000.
Revisions: No. 1 - Points on line

Jensen & Olson Land Surveying, LLC
45 South Wisconsin Street * P.O. Box 322 * Elkhorn, Wisconsin 53121
Telephone: (262) 723-3434 * Facsimile: (262) 723-8044
Email: jensen.olson@elknet.net

Legend

■ Found Iron Rod, 1 3/16" dia.
● Found Iron Rod, 3/4" dia.
□ Found Iron Pipe ■ Set Iron Rod
○ Recorded Information
✖ Utility Pole
□ Utility Pedestal
■ Utility Box

2010.078