


PLAT OF SURVEY

LOT 3 OF LORWOOD ACRES, A SUBDIVISION
LOCATED IN PART OF SECTION 35, TOWN 4 NORTH, RANGE 15 EAST,
WALWORTH COUNTY, WISCONSIN

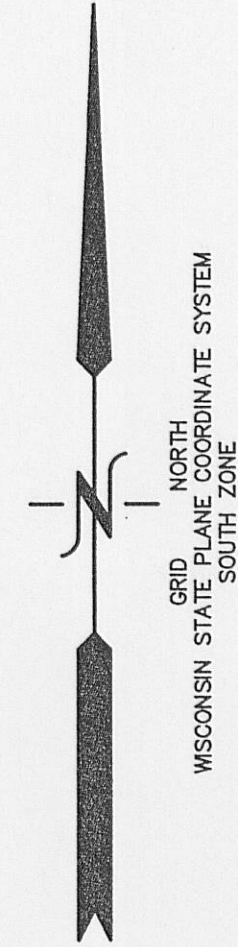

LEGEND
● = FOUND IRON REBAR STAKE
(XXX) = RECORDED AS

MAP SCALE IN FEET ORIGINAL 1" = 20'




NOTE: COPIES OF THIS MAP TO WHICH THE FOLLOWING CERTIFICATE WILL APPLY SHOW THE SURVEYOR'S ORIGINAL SEAL AND SIGNATURE IN RED INK. COPIES BY ANY OTHER MEANS MAY HAVE ALTERATIONS WHICH DO NOT REPRESENT THE SURVEYOR'S WORK PRODUCT.

I HEREBY CERTIFY THAT THE ABOVE DESCRIBED PROPERTY HAS BEEN SURVEYED UNDER MY DIRECTION AND THAT THE ABOVE MAP IS A TRUE REPRESENTATION THEREOF AND SHOWS THE SIZE AND LOCATION OF THE PROPERTY AND ITS EXTERIOR BOUNDARIES. THIS SURVEY IS MADE FOR THE USE OF THE PRESENT OWNERS OF THE PROPERTY, AND ALSO THOSE WHO PURCHASE, MORTGAGE, OR GUARANTEE THE TITLE THERETO WITHIN ONE YEAR FROM THE DATE HEREOF.

DATED: JUNE 4, 2004

PETER S. GORDON
PETER S. GORDON R.L.S. 2101

7/1/2011-KB
TO SHOW SIZE & LOCATION OF AS-BUILT
RESIDENCE & PROPOSED DECK ADDITION

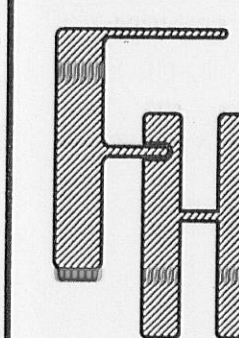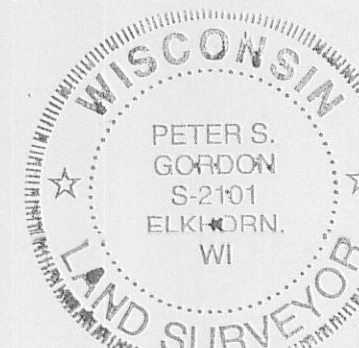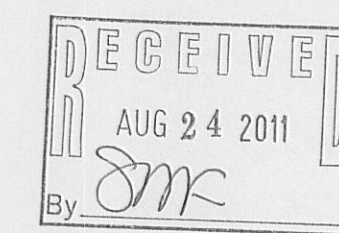

WORK ORDERED BY -
LEIF KNUDSEN
261 S. 4th ST.
WHITEWATER, WI 53190

FARRIS, HANSEN & ASSOCIATES, INC.
ENGINEERING - ARCHITECTURE - SURVEYING
7 RIDGWAY COURT P.O. BOX 437
ELKHORN, WISCONSIN 53121
OFFICE: (262) 723-2098 FAX: (262) 723-5686

REVISIONS

PROJECT NO.
5672.03
DATE
06/04/04
SHEET NO.
1 OF 1

7/1/2011 XL:\Projects\5672\WB_LOTS\Lot_3\ASBUILT_PEMIT2011

DLOR-3

415-1246