


of

a subdivision located in the Northwest 1/4 of Section 25, Town 4 North, Range 15 East, Town of Whitewater, Walworth County, Wisconsin.

Bearings reference to the
plat of Country Acres.

There shall be no vehicular ingress or egress from Lots 6, 7, 8, 9 and 10 to Kettle Moraine Drive.

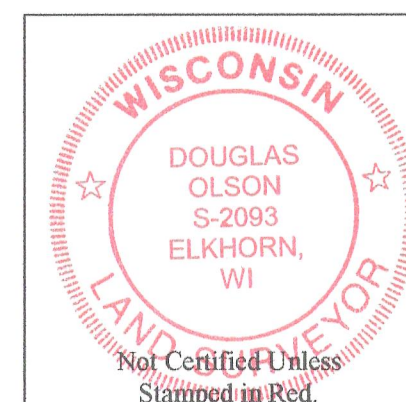

- 1) This survey plat is not certified unless signed and sealed in red ink.
- 2) This survey is subject to Wisconsin lien laws. This Plat of Survey is the notice of intent to file lien. Lien waiver required.

All rights reserved. No part of this survey plat may be reproduced or transmitted in any form by any means - graphic, electronic, or mechanical, including photocopying, tracing, or information storage and retrieval systems - without permission in writing from Douglas G. Olson, Jensen & Olson Land Surveying, LLC.

I hereby certify that I have surveyed the above described property and the map hereon is correct to the best of my professional knowledge and belief and shows the size and location of the property, its exterior boundaries, the location and dimensions of all visible structures thereon, boundary fences, apparent easements and roadways and visible encroachments, if any.

This survey is made for the exclusive use of the present owners of the property, and also those who purchase, mortgage or guarantee title thereto, within one year from the date hereof.

Douglas G. Olson
Wisconsin Registered Land Surveyor - 2093

Drawing Name: t4nr15e-2011074-2011074Plat.scj

2011.074

/ Found Iron Pipe
 □ Set Wood Lath
 () Recorded Information
 ✕ Utility Pole
 ⊠ Utility Box or Pedestal
 ◇ PVC Pipe
 ◊ Asphalt Surface



45 South Wisconsin Street * P.O. Box 322 * Elkhorn, Wisconsin. 53121

Telephone: (262) 723-3434 * Facsimile: (262) 723-8044

Email: jensen.olson@elknet.net

Scale in Feet
1" = 40'



Survey Date: August 1, 2011.

Revisions:

2011.074

4/15-1255