

LAND-MARK SURVEYING
Mark L. Miritz
Wisconsin Registered Land Surveyor S-2582



N9330 Knuteson Drive
Whitewater, WI 53190
Phone: (262) 495-3284
FAX: (262) 495-8421
LAND-MARKSURVEYING.COM

NORTH 1/4 CORNER SEC. 29-4-15

PLAT OF SURVEY

LOT 1 OF CERTIFIED SURVEY MAP NO. 629, LOCATED IN THE NORTHWEST 1/4
OF SECTION 29, TOWN 4 NORTH, RANGE 15 EAST, WHITEWATER TOWNSHIP,
WALWORTH COUNTY, WISCONSIN.

OWNER: ADRIENNE D. WRIGHT
N8073 STATE ROAD 89
WHITEWATER, WI 53190

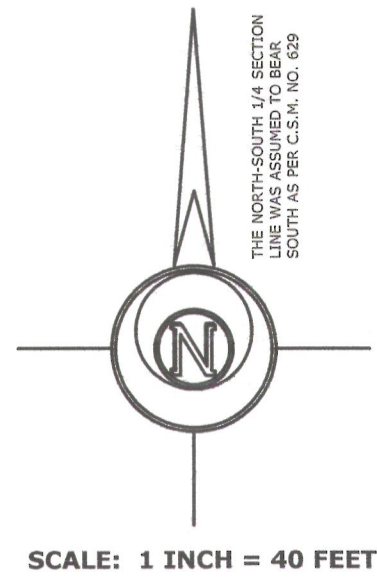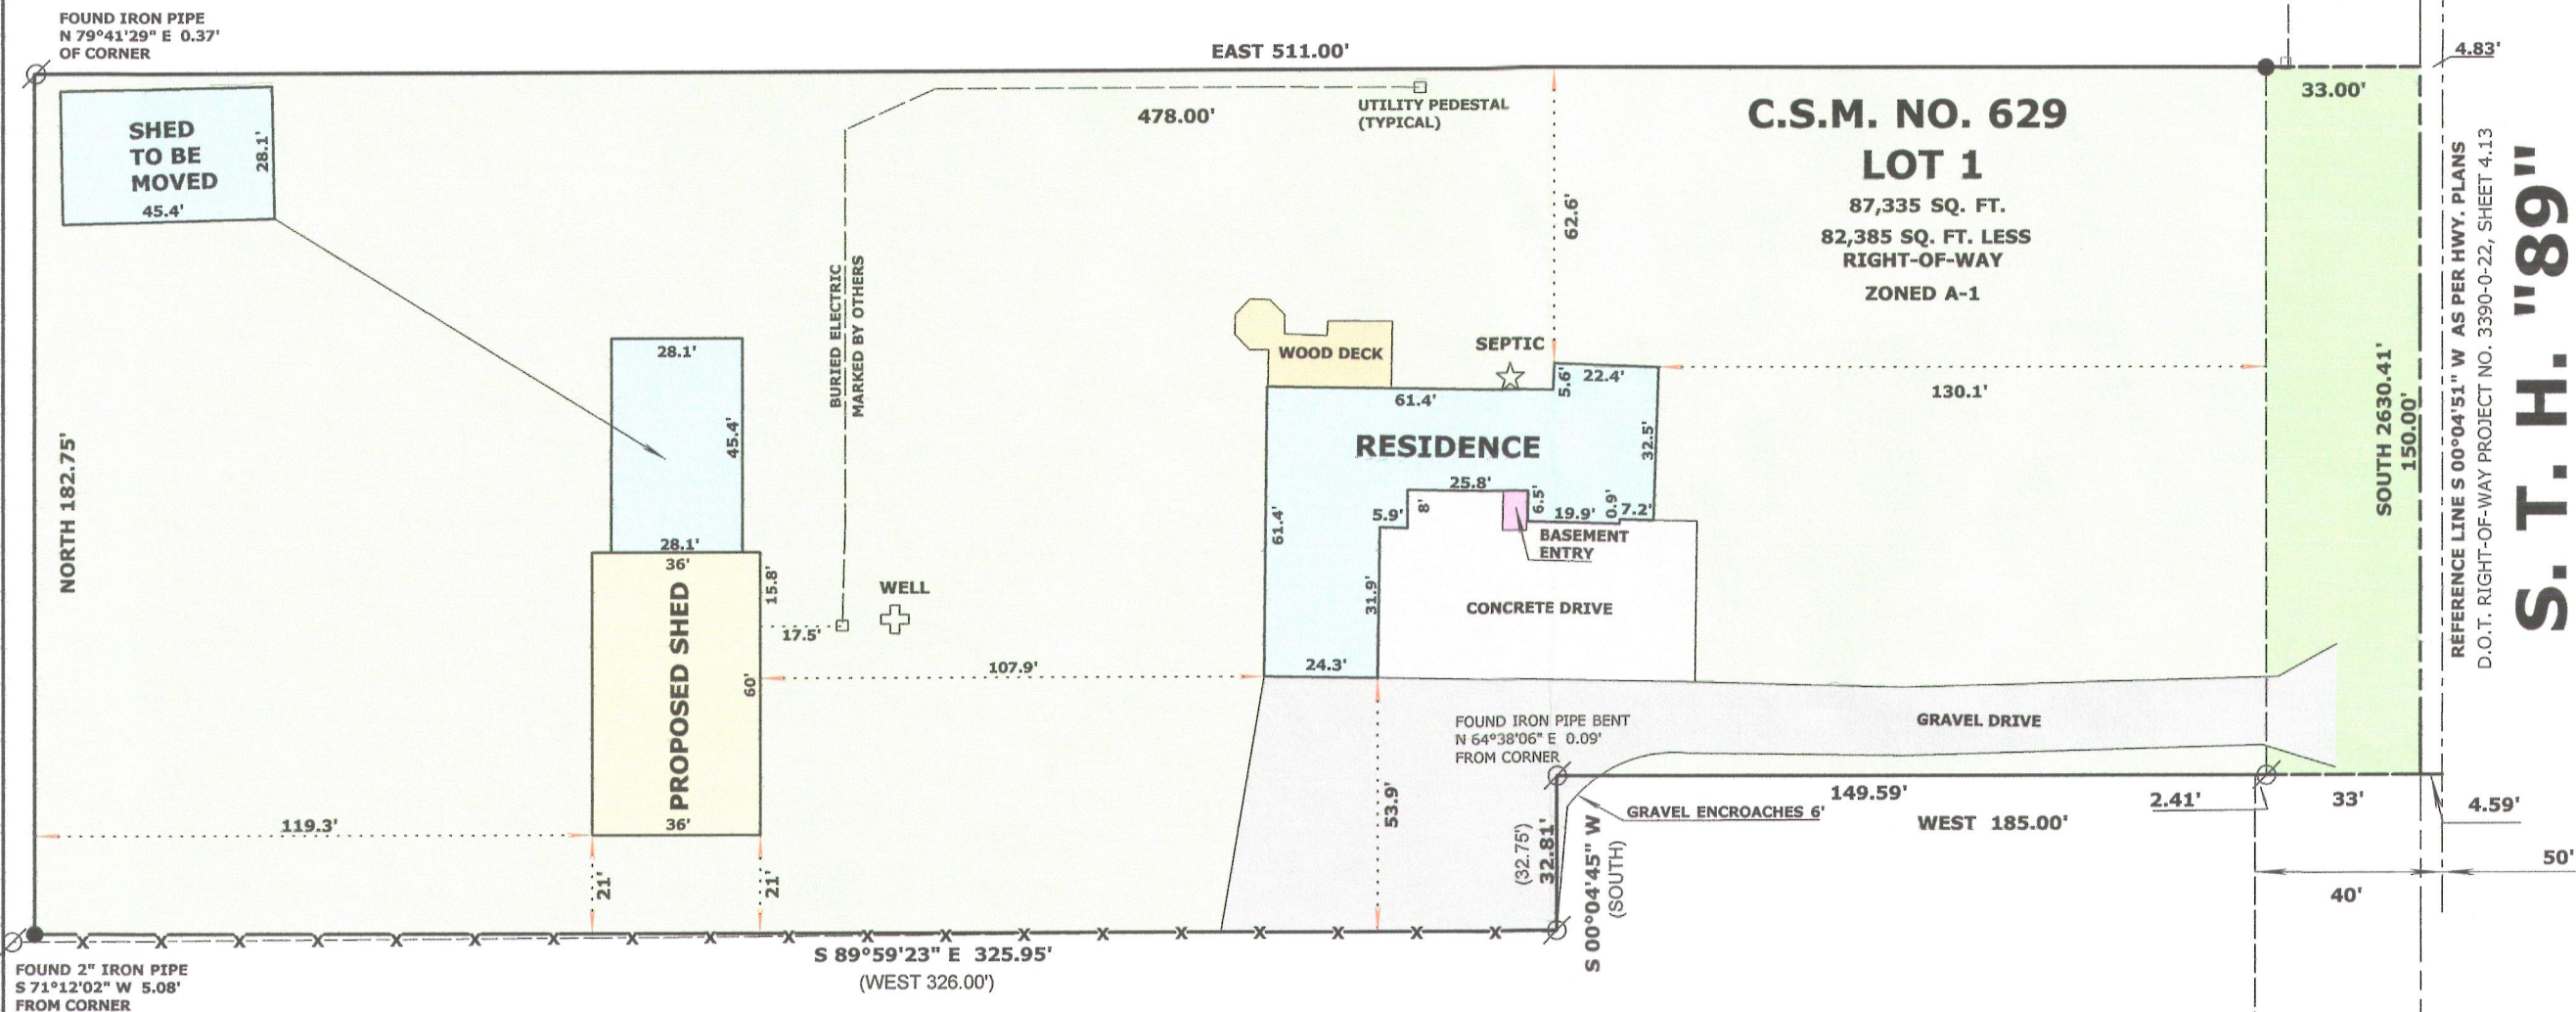

- LEGEND**
- FOUND IRON PIPE
 - FOUND COUNTY MONUMENT
 - SET IRON ROD, 24" LONG, WEIGHING 1.5 LBS./LINEAL FT., 3/4" DIA.
 - (x x) RECORDED AS DIMENSION
 - x - x - EXISTING FENCE

SURVEYOR'S NOTE:
THE IRON PIPE SET ON C.S.M. NO. 629 CALLED FOR 1" DIAMETER. AT THE TIME OF SAID C.S.M., IRON WERE MEASURED ON A INSIDE DIAMETER. TODAY THE IRON ARE MEASURED ON A OUTSIDE DIAMETER (OD). THEREFORE I BELIEVE THE 1.25" PIPE FOUND ARE ORIGINAL FROM SAID C.S.M. AND THE 2" FOUND AT THE SOUTHWEST CORNER OF PARCEL IS FROM UNKNOWN ORIGIN.

RECEIVED
NOV 12 2012
By _____



R.O.W. TAKING
AS PER VOL. 252,
PAGE 330, DOC.
NO. 58978

"I hereby certify that the above described property has been surveyed by me or under my direction in full compliance with the owner's/agent's instructions and Chapter A-E 7 of the Wisconsin Administrative Code "Minimum Standards for property surveys"; that the above map is correct to the best of my knowledge and belief."

Mark L. Miritz
MARK L. MIRITZ
WISCONSIN REGISTERED
LAND SURVEYOR S-2582

DATE: OCT. 4, 2012 JOB NO. 12.906

DA 62900001

415-1271

CENTER SECTION 29-4-15