


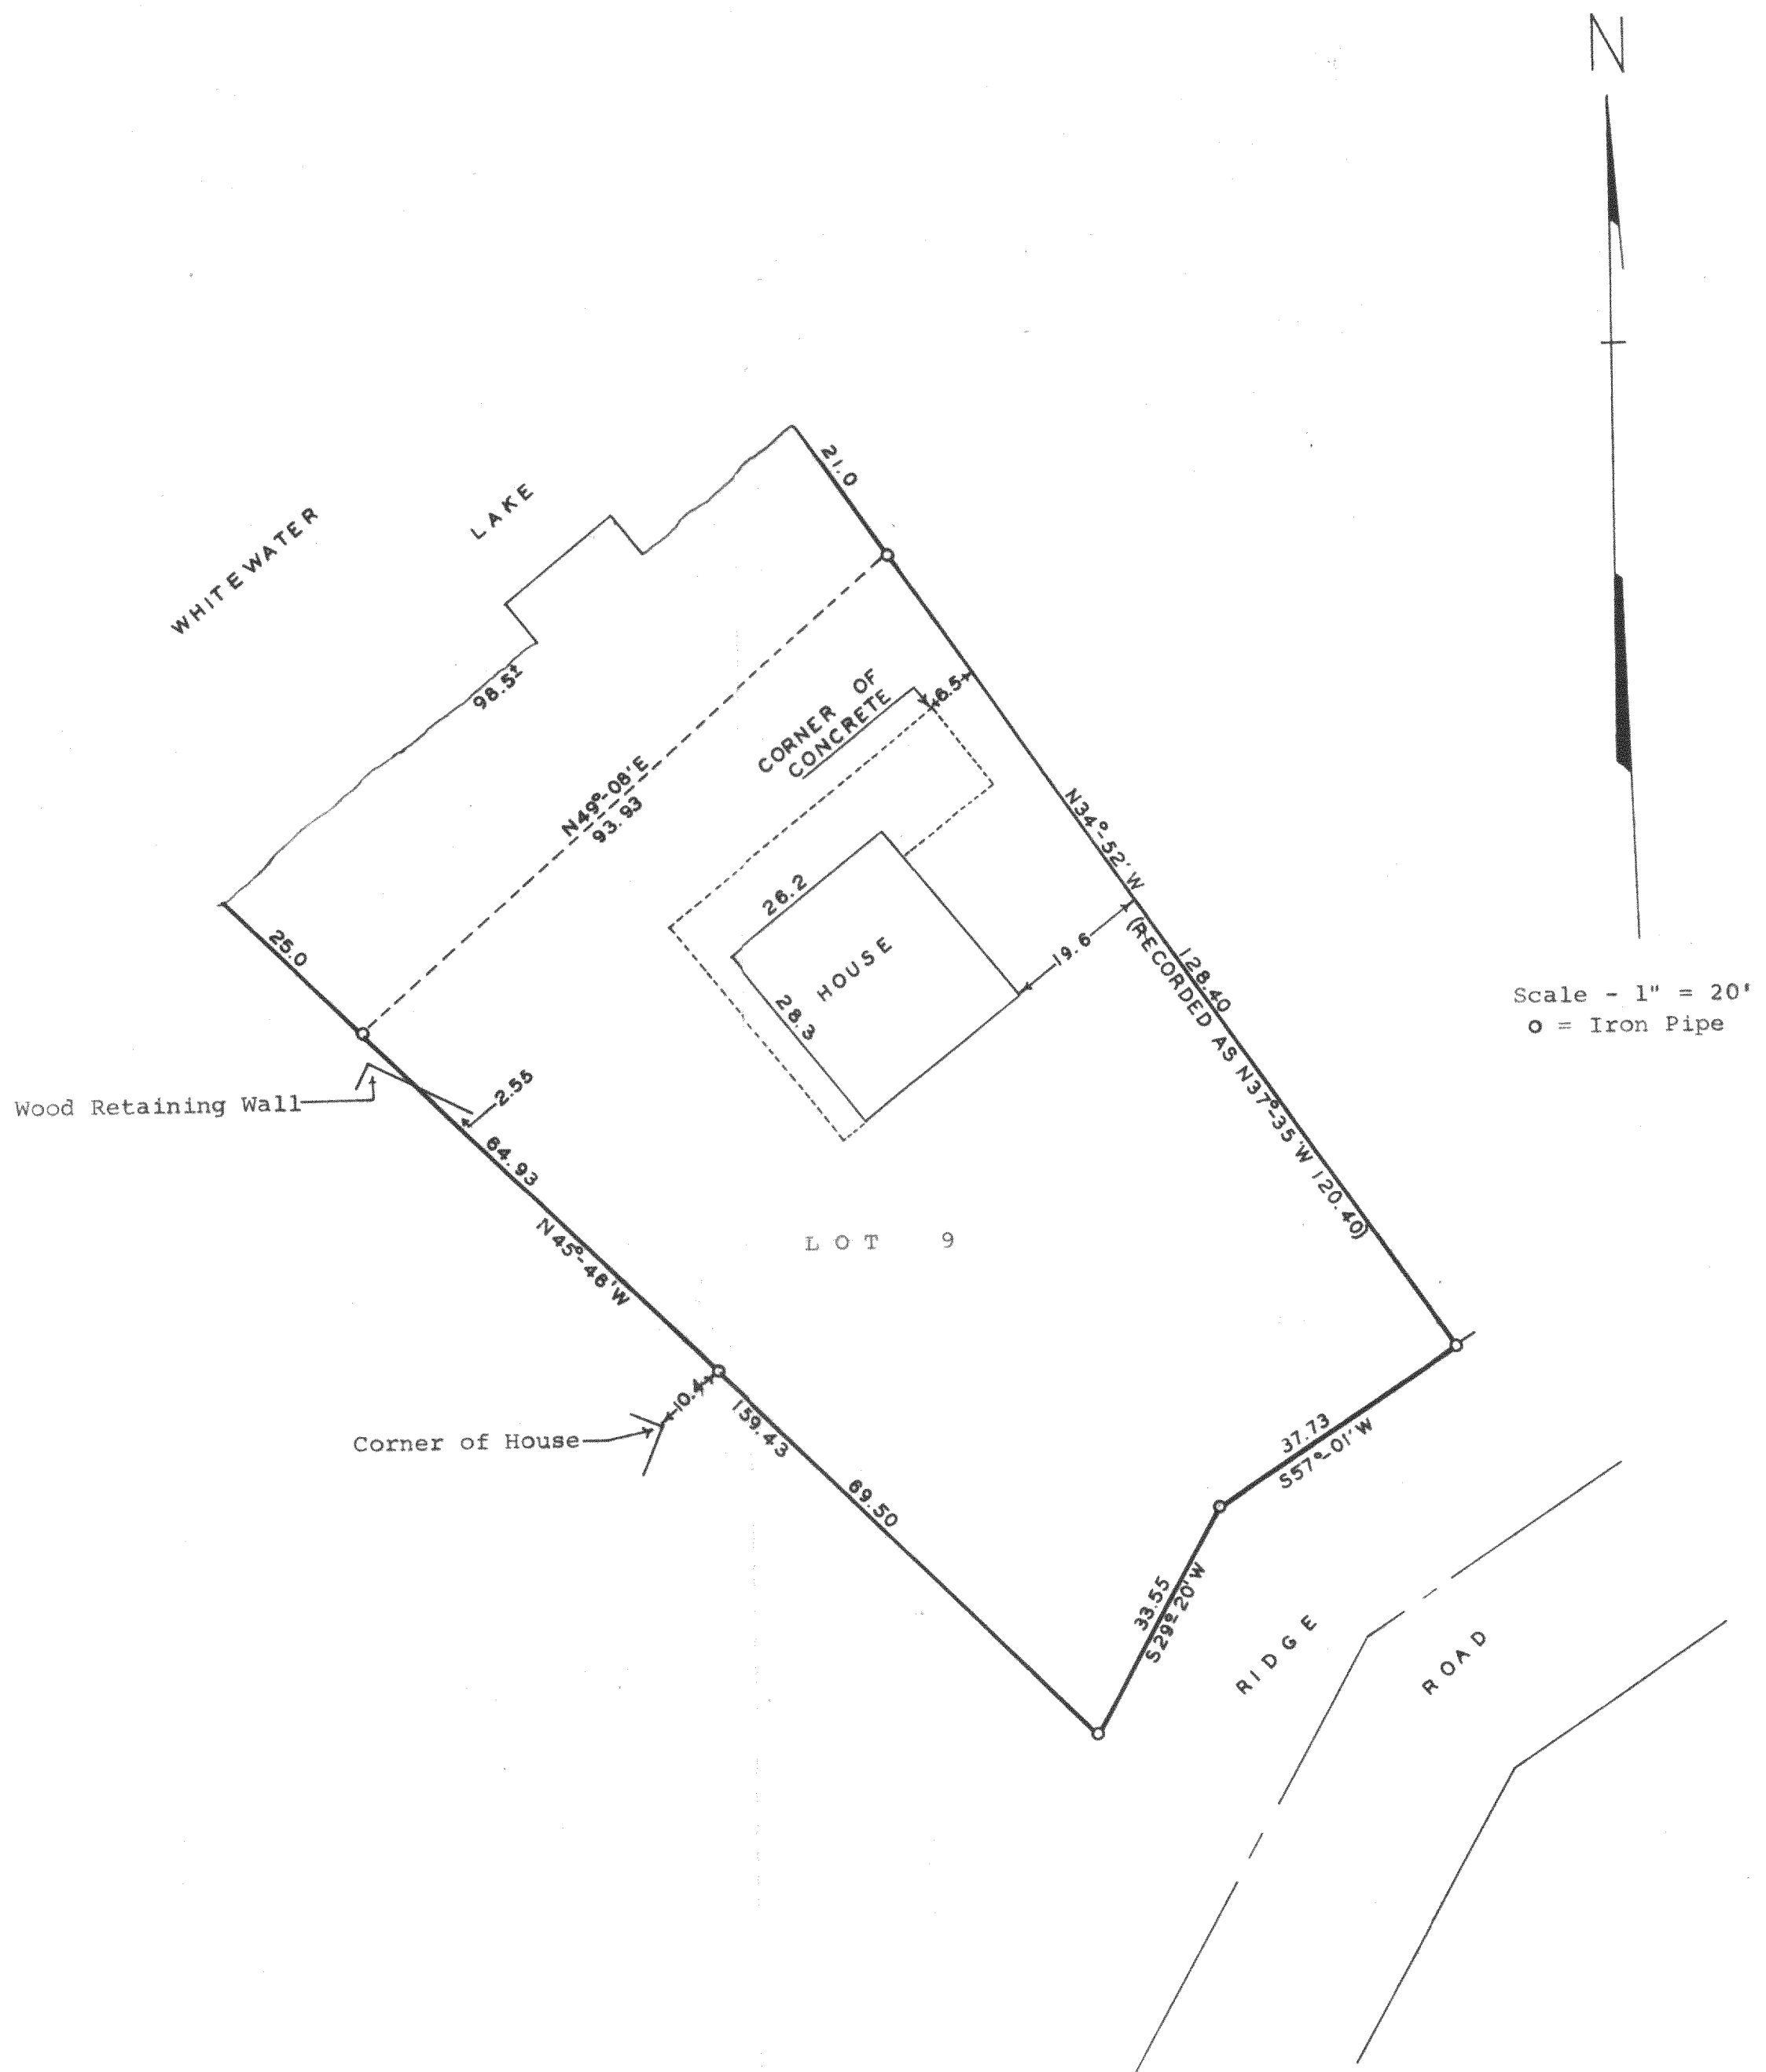

STATE OF WISCONSIN)
COUNTY OF WALWORTH) SS

I, George T. Dunham, Surveyor, certify that I have surveyed the property described as follows,
Lot 9 in Block 4 of Moraine Heights, a subdivision located in Sections 26 and 35, T 4 N, R 15 E, Walworth County, Wisconsin,
and that the above plat is an accurate survey and a true representation thereof and correctly shows the exterior boundary lines and the location of the house on said property and the correct measurements thereof.
June 21, 1973

George T. Dunham
George T. Dunham, Surveyor

