

PREPARED FOR
PAM ADAMS
936 RIDGE COURT
EVANSTON IL 60202



PLAT OF SURVEY

-OF-


LOT 16 PINE KNOLL SUBDIVISION, IN THE NORTHEAST 1/4
OF THE NORTHEAST 1/4 OF SECTION 34, TOWN 4 NORTH,
RANGE 15 EAST, TOWN OF WHITEWATER, WALWORTH
COUNTY, WISCONSIN.

KROTT SURVEYING INC.
N3705 WILLOW BEND LANE
LAKE GENEVA WI. 53147
PHONE # (262)248-3697
FAX # (262)249-0639

C.L.
PINE KNOLLS DRIVE
(66' WIDE)

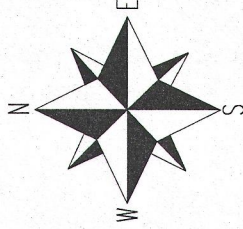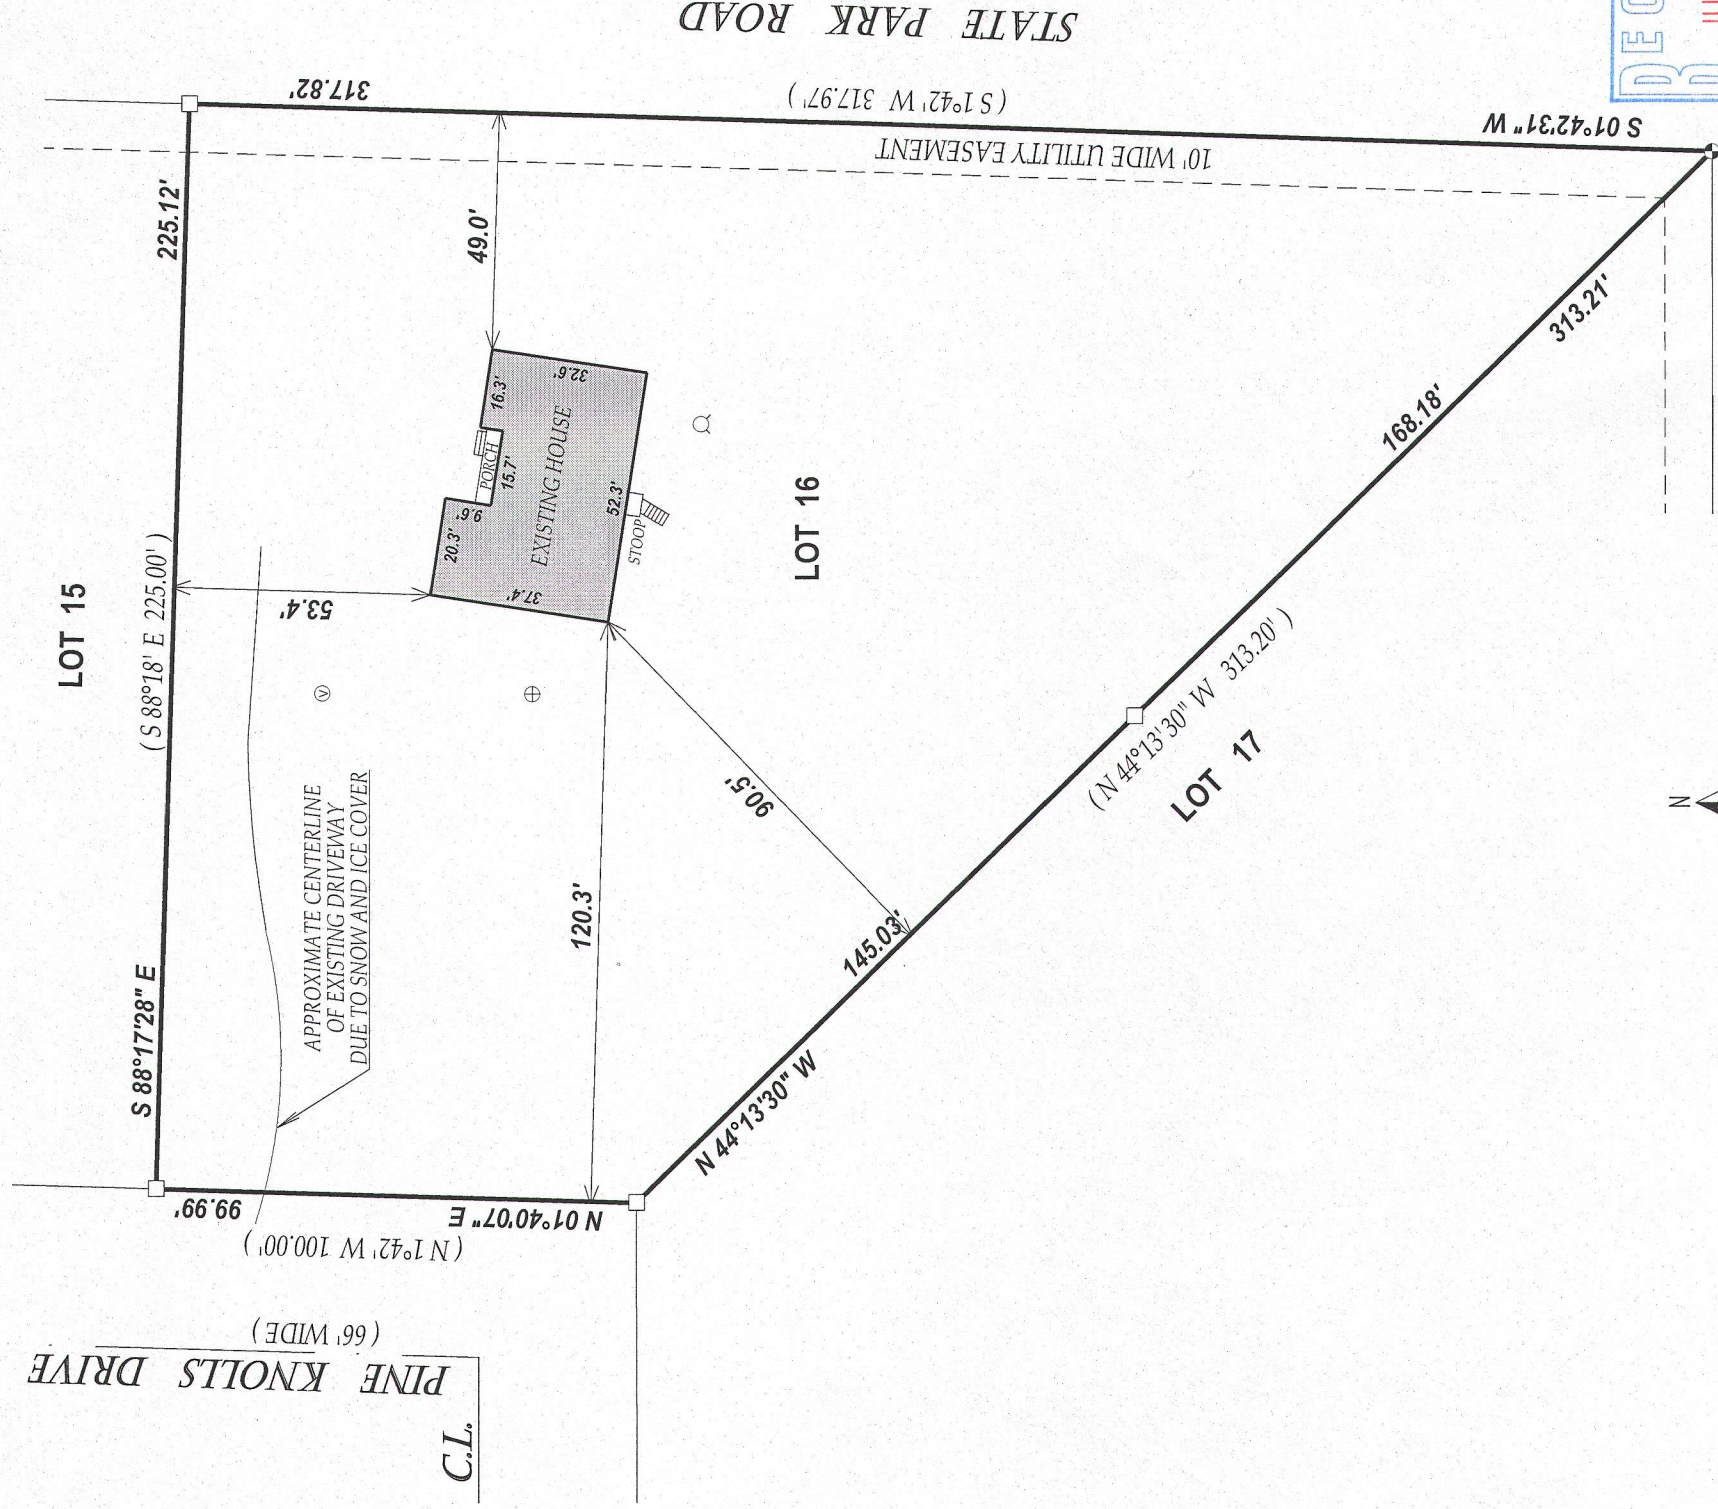

SCALE 1" = 40'

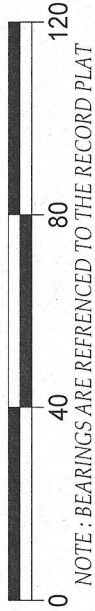

NOTE : BEARINGS ARE REFERENCED TO THE RECORD PLAT

I have surveyed the above-described property and the above map is a true representation thereof and shows the size and location of the property, its exterior boundaries, the location and dimensions of all structures thereon, fences apparent easements and roadways and visible encroachments, if any.

This survey is made for the exclusive use of the present owners of the property, and also those who purchase, mortgage, or insure the title thereto within one (1) year from date hereof; and as to them I warrant the accuracy of said survey map.


LEGEND

- FOUND IRON BAR
- COUNTY MONUMENT
- WELL
- ⊕ CONCRETE LID
- ⊙ VENT

(XX) RECORDED AS

TAX ID # DPK00016

JOB # 13-034

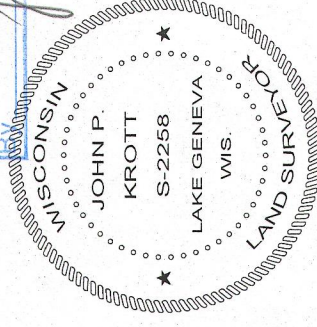

DATED THIS 25th DAY OF MARCH 2013

John P. Krott

JOHN KROTT S - 2258
Wisconsin Registered Land Surveyor
(original if signed in red)

415-1286