

PLAT OF SURVEY


WORK ORDERED BY -  
RICK LYNAM - LYNAM CUSTOM HOMES  
881 SAUGANASH DRIVE  
FONTANA, WI 53125

FARRIS, HANSEN & ASSOCIATES, INC.  
ENGINEERING - ARCHITECTURE - SURVEYING  
7 RIDGWAY COURT P.O. BOX 437  
ELKHORN, WISCONSIN 53121  
OFFICE: (262) 723-2098 FAX: (262) 723-5886

REVISIONS


PROJECT NO.  
8847  
DATE:  
07/18/2013  
SHEET NO.  
1 OF 1

PLAT OF SURVEY  
LOT 28, BLOCK 1, MORAINE PARK SUBDIVISION  
PART OF THE SE 1/4 OF THE NE 1/4 OF SECTION 34 AND THE SW 1/4  
OF THE NW 1/4 OF SECTION 35, ALL IN TOWN 4 NORTH, RANGE 15 EAST,  
WALWORTH COUNTY, WISCONSIN

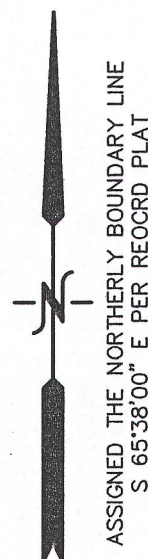



STATE PARK ROAD  
{66' WIDE R.O.W.}

WEST LAKE SHORE DRIVE  
{50' WIDE R.O.W.}

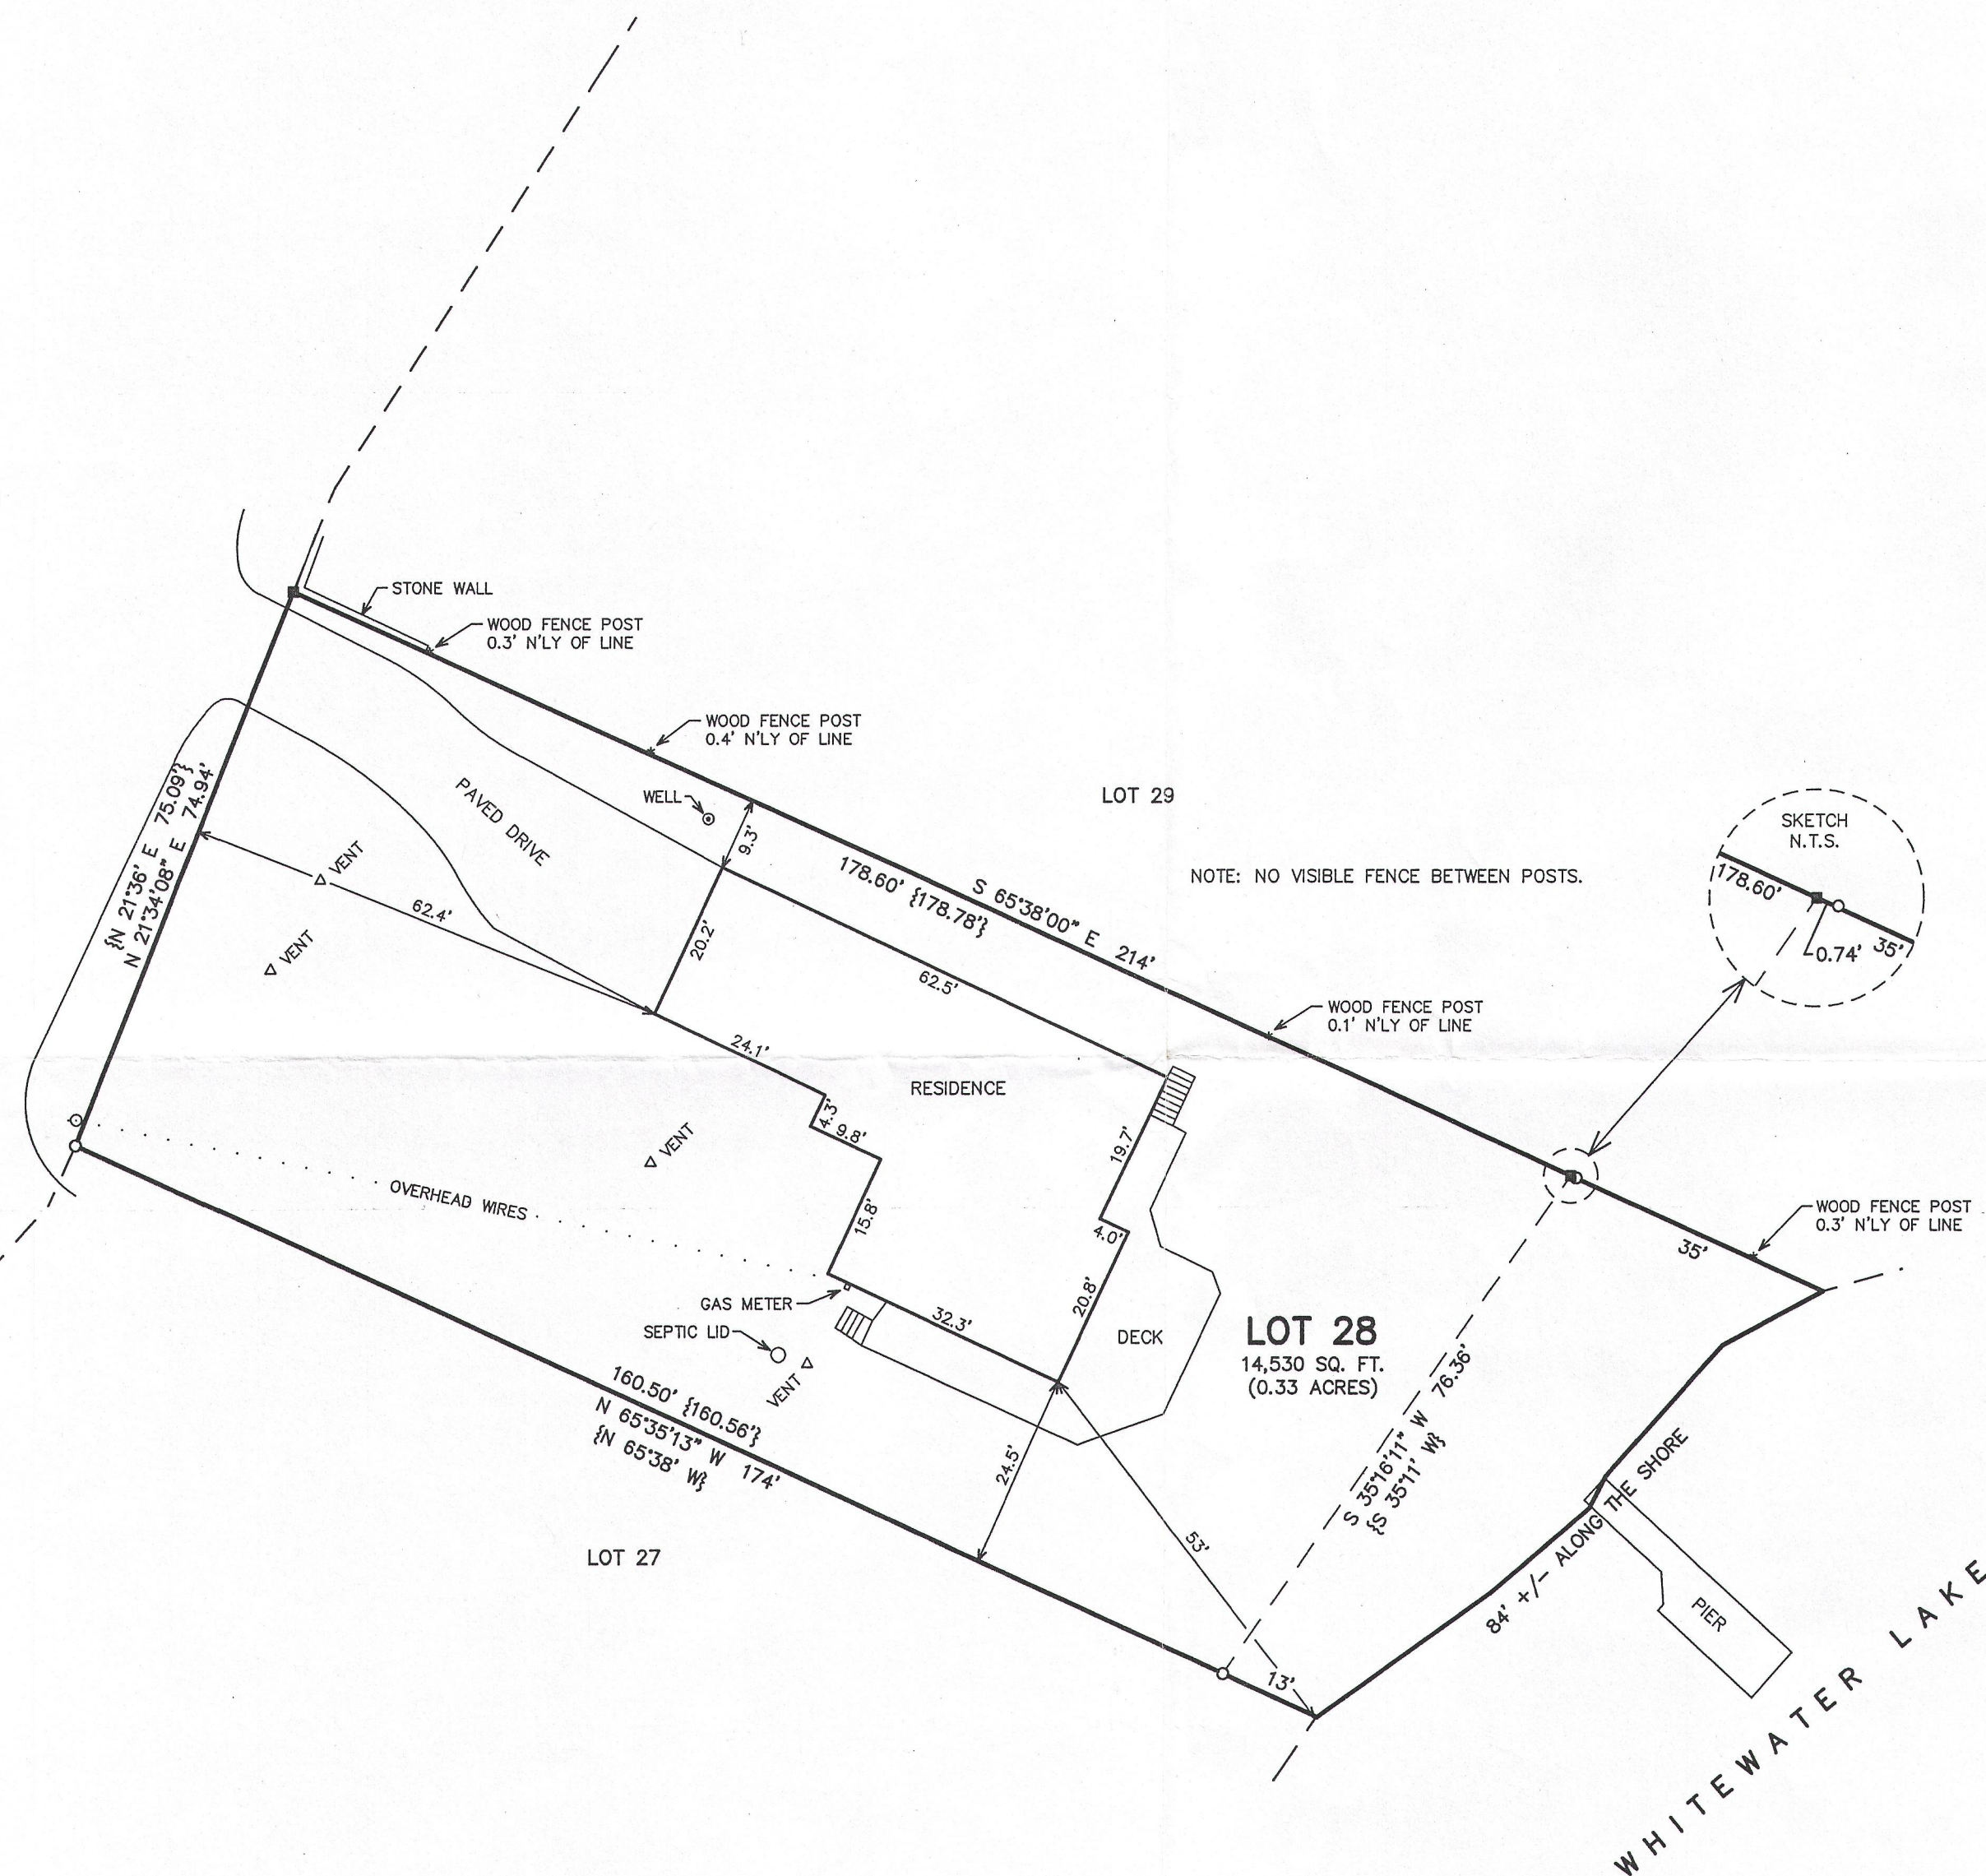

LEGEND

- = FOUND CONCRETE MONUMENT
- = FOUND IRON PIPE STAKE
- ◇ = UTILITY POLE LOCATED
- {XXX} = RECORDED AS

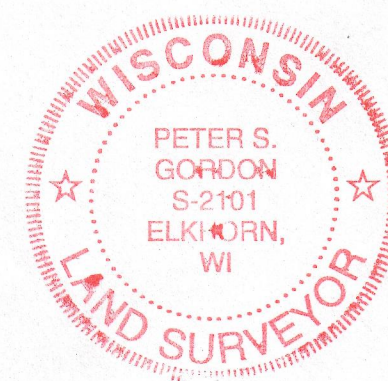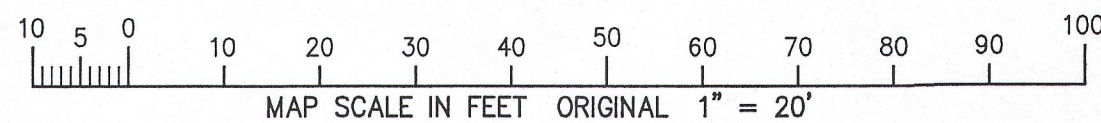

NOTE: COPIES OF THIS MAP TO WHICH THE FOLLOWING CERTIFICATE  
WILL APPLY SHOW THE SURVEYOR'S ORIGINAL SEAL AND SIGNATURE  
IN RED INK. COPIES BY ANY OTHER MEANS MAY HAVE ALTERATIONS  
WHICH DO NOT REPRESENT THE SURVEYOR'S WORK PRODUCT.

I HEREBY CERTIFY THAT THE ABOVE DESCRIBED PROPERTY HAS BEEN  
SURVEYED UNDER MY DIRECTION AND THAT THE ABOVE MAP IS A TRUE  
REPRESENTATION THEREOF AND SHOWS THE SIZE AND LOCATION OF  
THE PROPERTY AND ITS EXTERIOR BOUNDARIES. THIS SURVEY IS  
MADE FOR THE USE OF THE PRESENT OWNERS OF THE PROPERTY, AND  
ALSO THOSE WHO PURCHASE, MORTGAGE, OR GUARANTEE THE TITLE  
THERETO WITHIN ONE YEAR FROM THE DATE HEREOF.

DATED: 7/18/2013

PETER S. GORDON R.L.S. 2101

dmp - 26

415-1287