

LAND-MARK SURVEYING

Mark L. Miritz


Wisconsin Registered Land Surveyor S-2582

N9330 Knuteson Drive
Whitewater, WI 53190
Phone: (262) 495-3284
MARKMIRITZ@
LAND-MARKSURVEYING.COM


OWNERS: JAMES BATTEN
JANICE BATTEN
N7533 ENGEL ROAD
WHITEWATER, WI 53190

PLAT OF SURVEY

LOT 2 OF GLACIAL FOREST SUBDIVISION,
LOCATED IN PART OF THE SOUTH 1/2 OF
THE NORTHEAST 1/4 OF SECTION 33,
TOWN 4 NORTH, RANGE 15 EAST, WHITE-
WATER TOWNSHIP, WALWORTH COUNTY,
WISCONSIN.

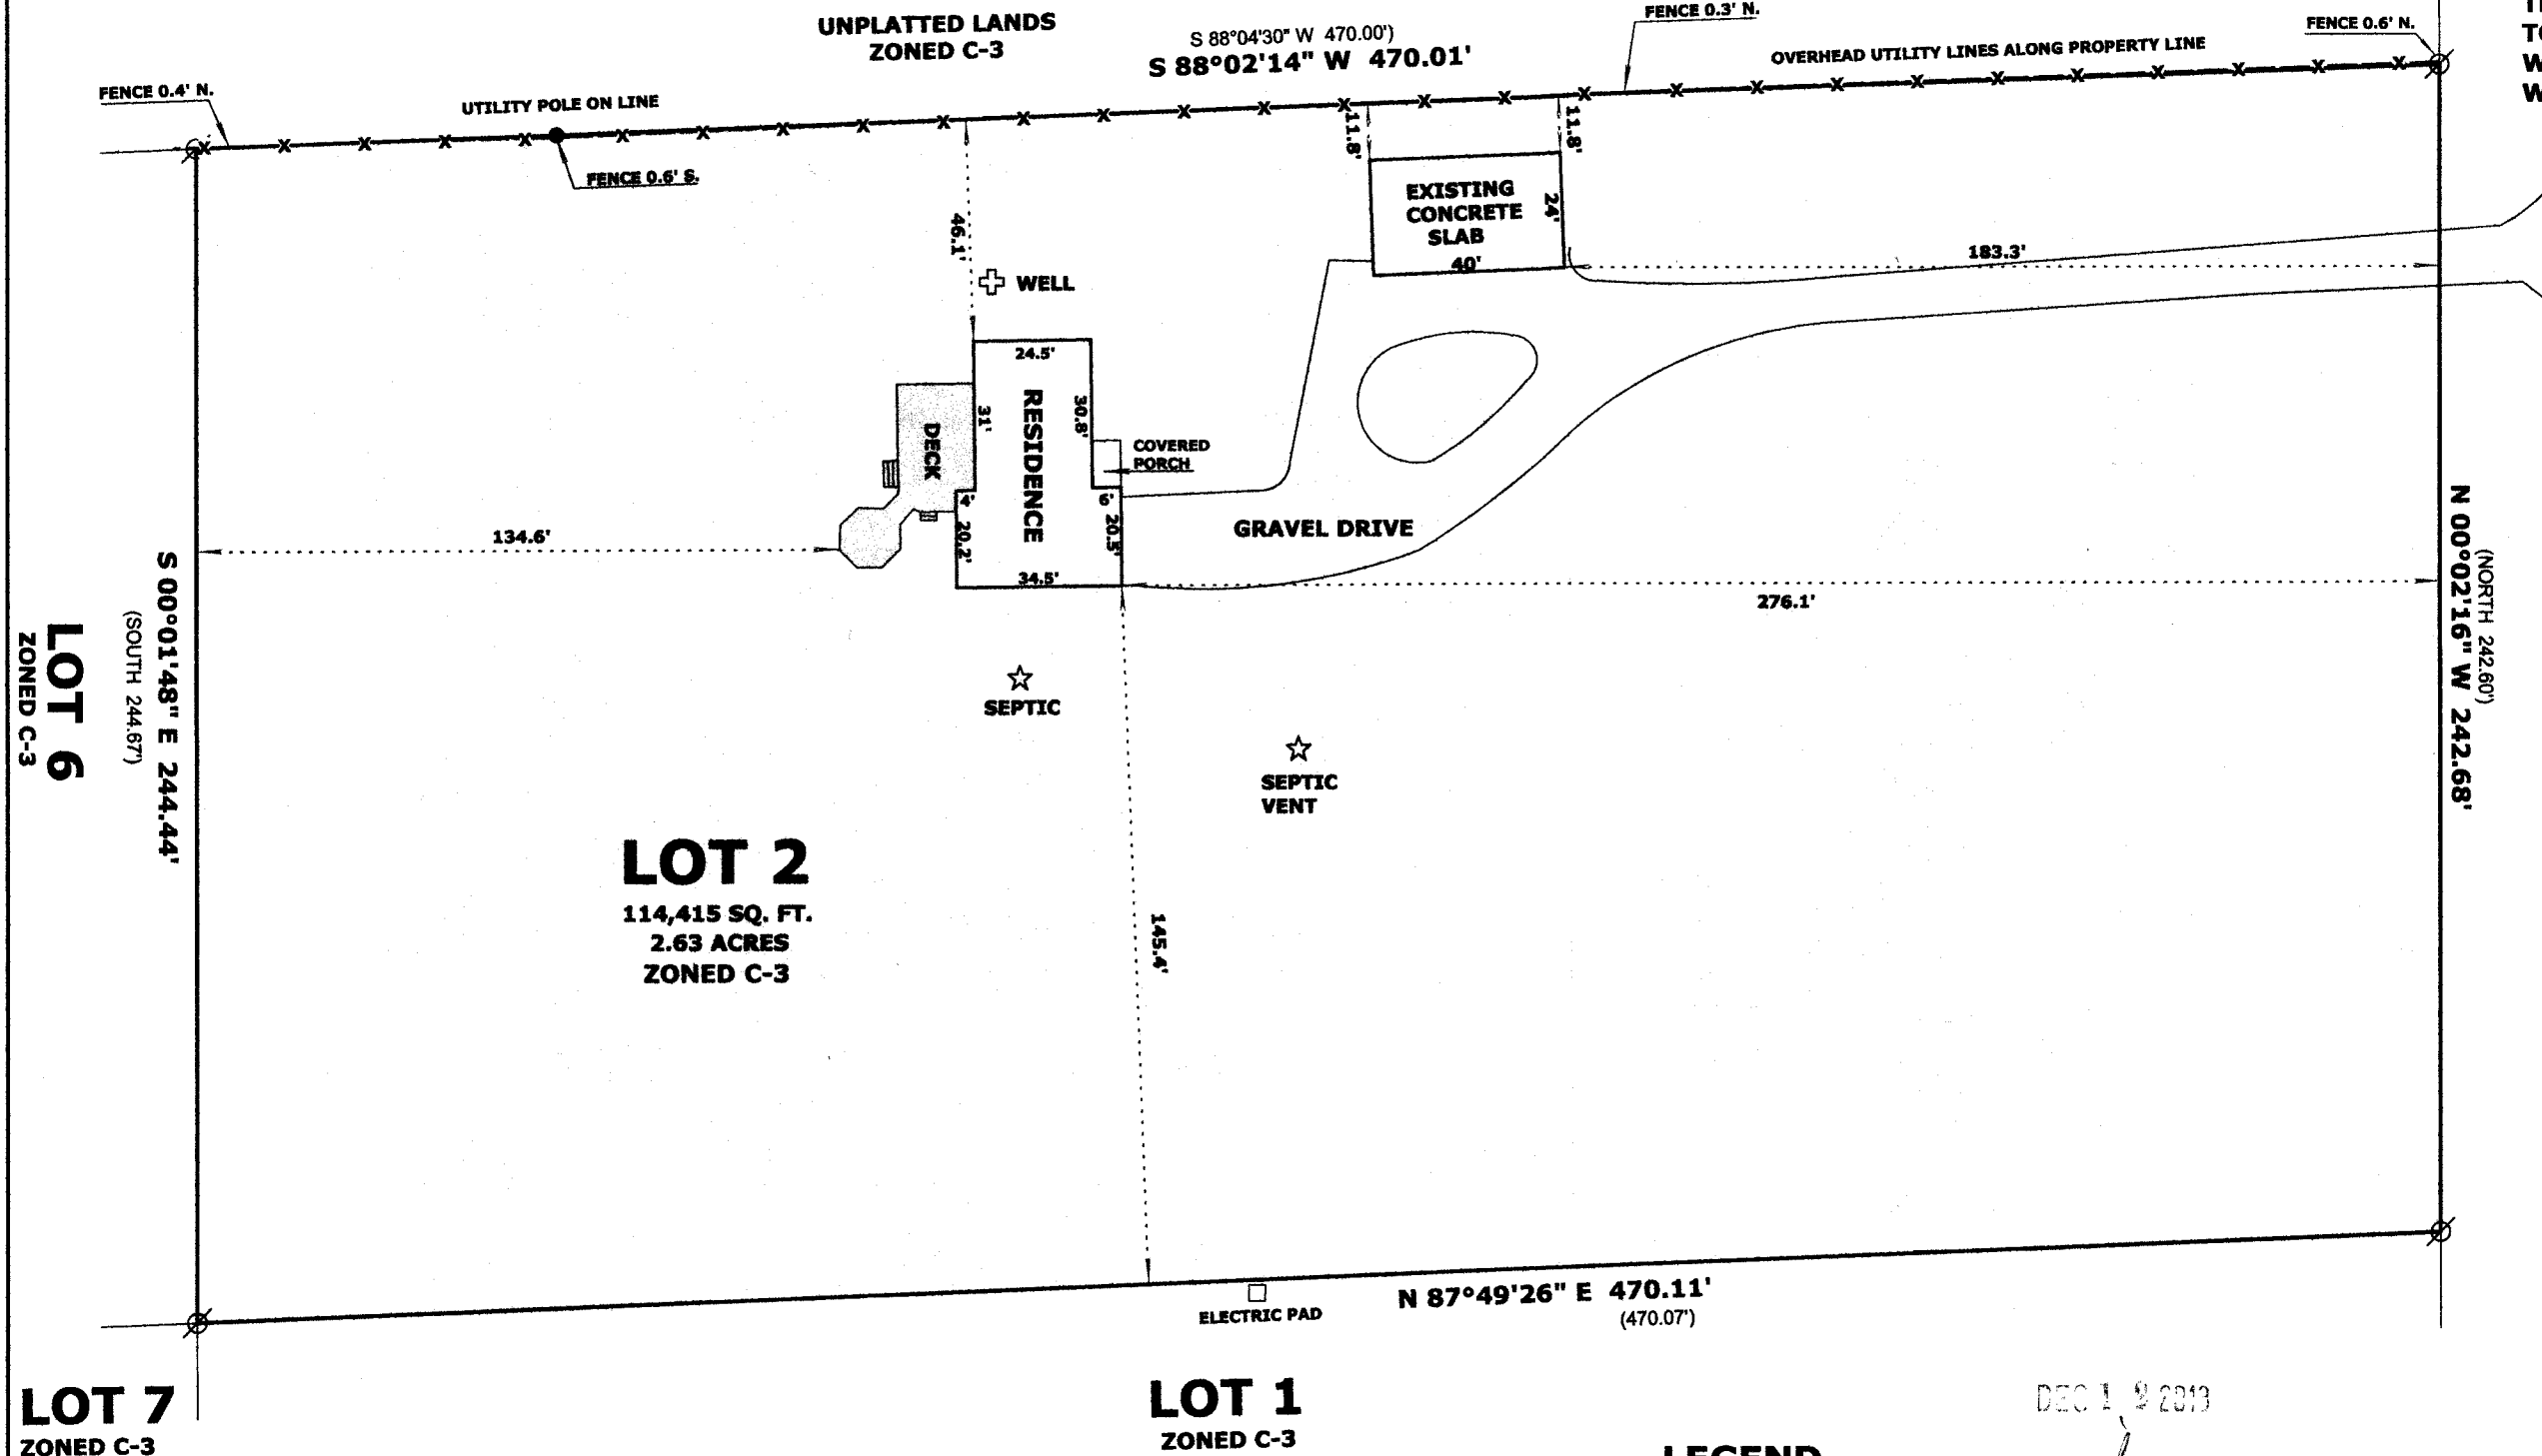

ENGEL ROAD
(66' WIDE)

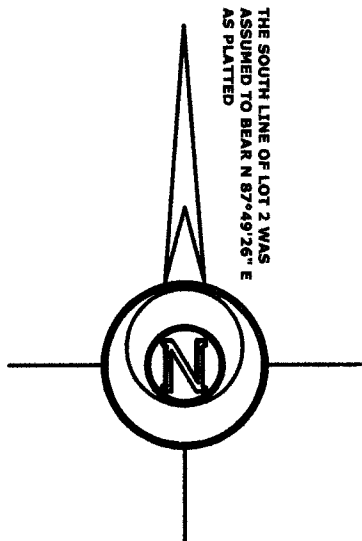

SCALE: 1 INCH = 40 FEET

"I hereby certify that the above described property has been surveyed by me or under my direction and that the above map is a true representation thereof and shows the size and location of the property, its exterior boundaries, the location of all visible structures and dimensions of all principal buildings thereon, boundary fences, apparent easements, roadways and visible encroachments, if any."
"This survey is made for the use of the present owners of the property, and also those who purchase, mortgage, or guarantee the title thereto within one year from date hereof."

Mark L. Miritz
MARK L. MIRITZ
WISCONSIN REGISTERED
LAND SURVEYOR S-2582

DATE: AUGUST 30, 2013 JOB NO. 13.808

LEGEND

- ⊗ FOUND IRON PIPE
- (x x) RECORDED AS DIMENSION
- x — EXISTING FENCE

DEC 1 2 2013
gjc

REVISED OCT. 29, 2013 TO SHOW
FLOOR FOR SHED "AS BUILT"

dl -2

415-1303