

SITE PLAN



Lot 3 of Certified Survey Map No. 702, being a part of the SE 1/4 of Section 34, T4N, R15E, Walworth County, Wisconsin, recorded in Volume 3 of Certified Surveys at Page 205 as Document No. 21674. EXCEPTING THEREFROM those portions of said Lot 3 more particularly described as follows, to-wit: Commencing at the NE corner of Lot 4 of Certified Survey Map No. 702; thence South 0° 23' West along the Easterly line of said Lot 4, 68.17 feet to the point of beginning; thence continue South 0° 23' West along said Easterly line 7.23 feet; thence South 33° 11' East along said Easterly line 108.80 feet to a meander point which is North 33° 11' West 6.5 feet, more or less, from Whitewater Lake; thence North 50° 40' East along a meander line 4.02 feet to a meander point, which is North 33° 11' W. 7 feet, more or less, from said Whitewater Lake; Thence North 33° 11' West 114.39 feet to the point of beginning, containing 500 square feet more or less which includes all lands between the above described meander line, the courses N 33° 11' West 6.5 feet more or less, North 33° 11' West 7 feet, more or less, and Whitewater Lake. ALSO included in this conveyance is a part of Lot 4 of Certified Survey Map No. 702 described as follows: Beginning at the NE corner of said Lot 4; thence N 89° 37' W along the North line of said Lot 4, 51.70 feet; Thence S 73° 26' 15" E., 53.83 feet to the easterly line of said Lot 4; thence N 0° 23' E. along said easterly line, 15.00 feet to the point of beginning, containing 388 square feet.

ORDERED BY: COUNTRY BUILDERS, INC.
DAVID R. WILLIAMS
220 N. JEFFERSON ST.
WHITEWATER, WI 53190

OWNER: WHITEWATER LAKE COOPERATIVE
615 FAIRFIELD DR.
BARRINGTON, IL 60010

SITE ADDRESS: N7468 KETTLE MORaine DRIVE

KETTLE MORaine DRIVE

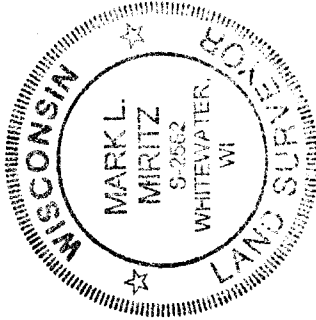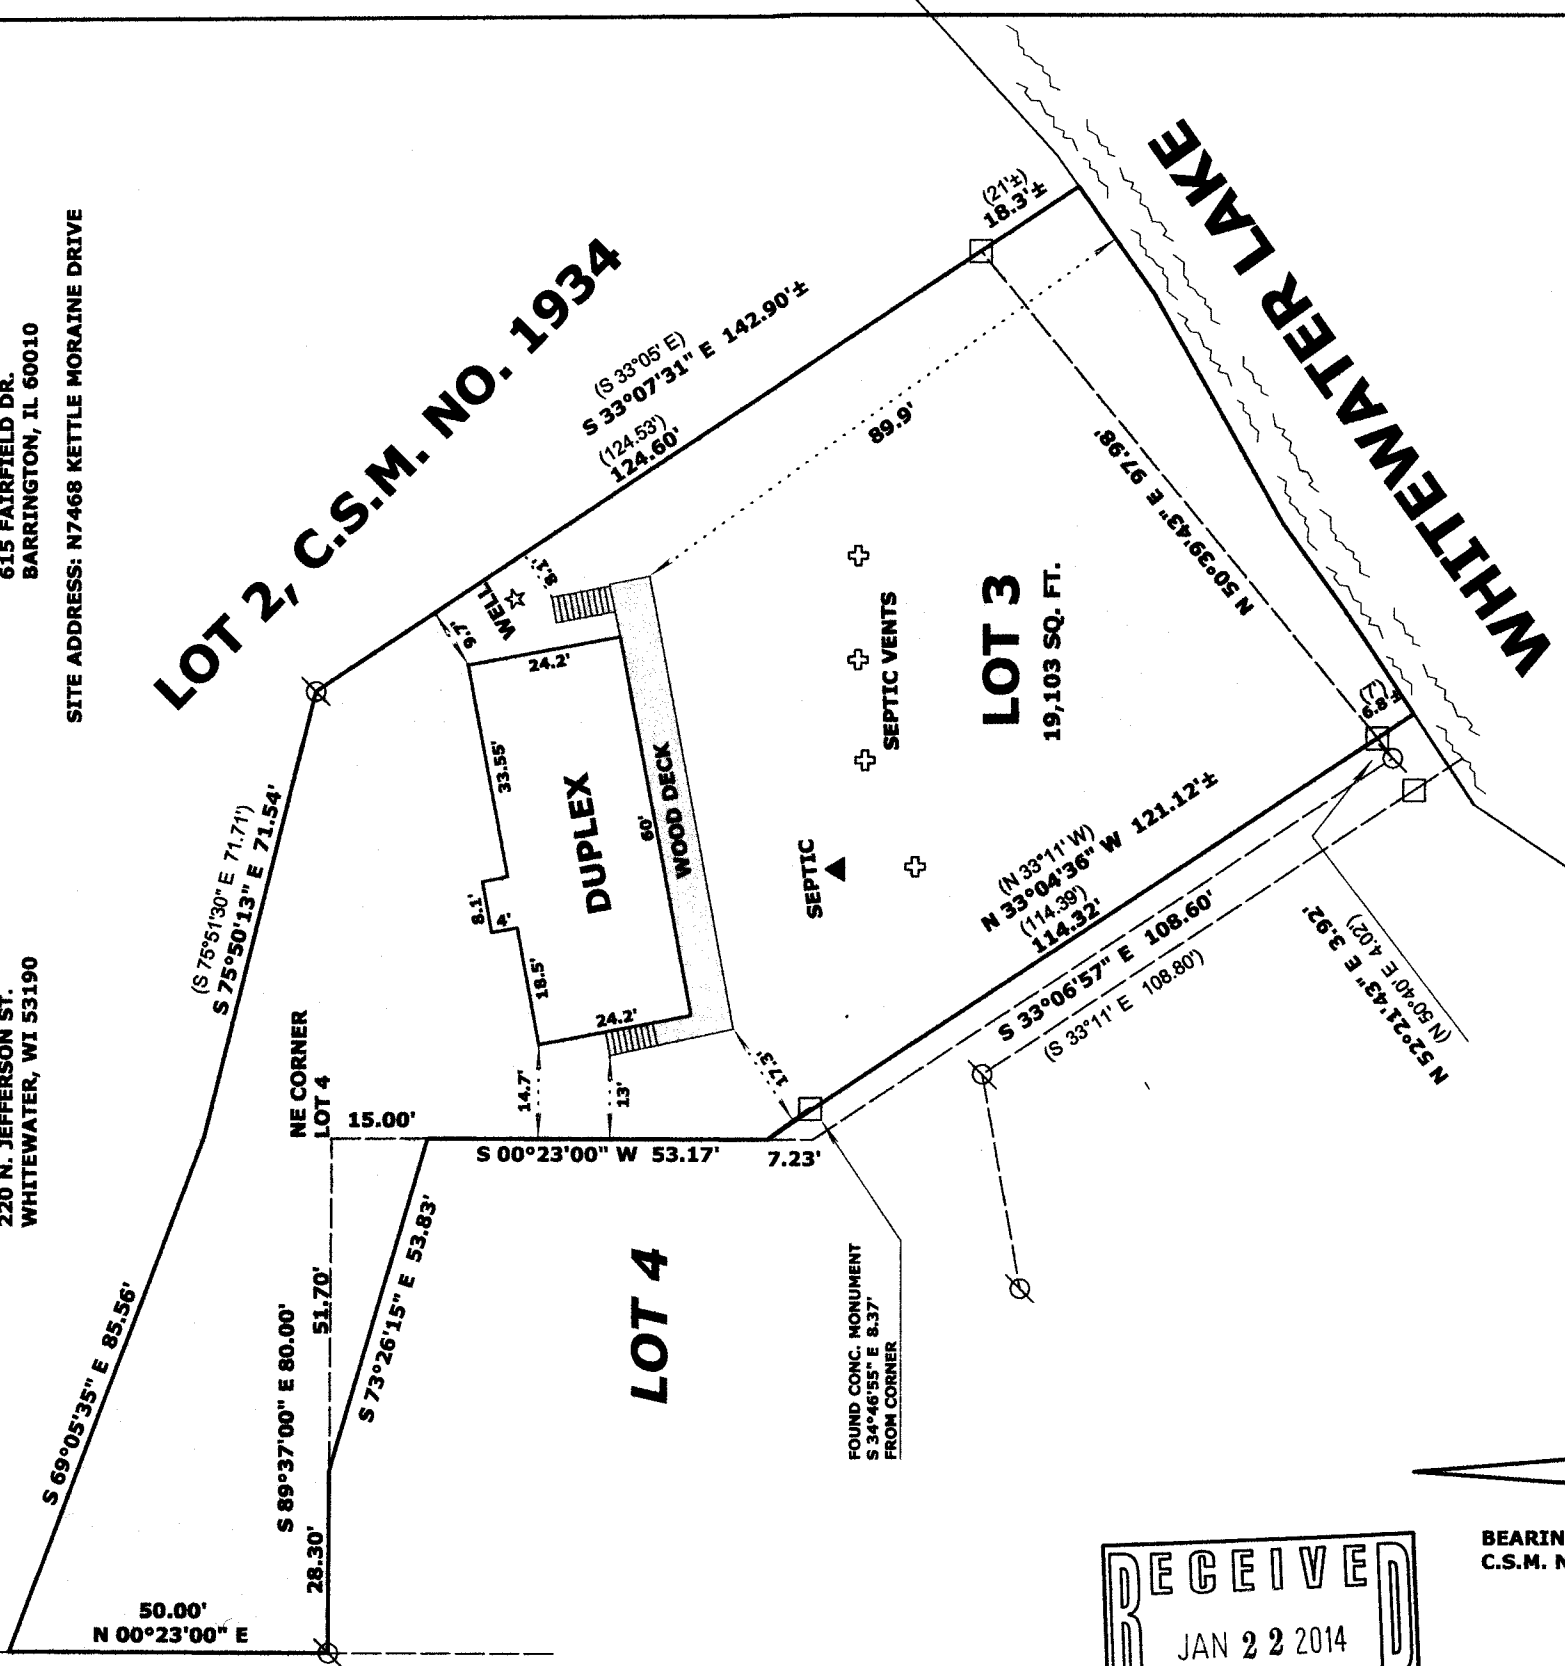

Mark L. Miritz

MARK L. MIRITZ
WISCONSIN REGISTERED
LAND SURVEYOR S-2582

DA 702-3 415-1307

DATE: DEC. 31, 2013 JOB NO. 13.1210