
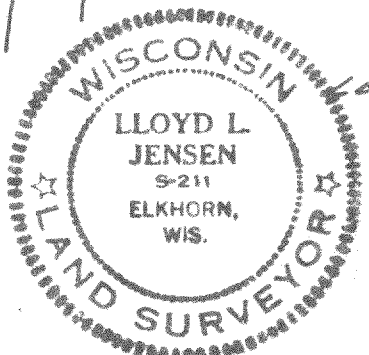


PLAT OF SURVEY

OF

LOT 8 BLOCK 2 OF GUTZMER'S SUBDIVISION
LOCATED IN THE NW $\frac{1}{4}$ AND THE SW $\frac{1}{4}$ OF
SECTION 25, T4N R15E, WALWORTH COUNTY,
WISCONSIN.

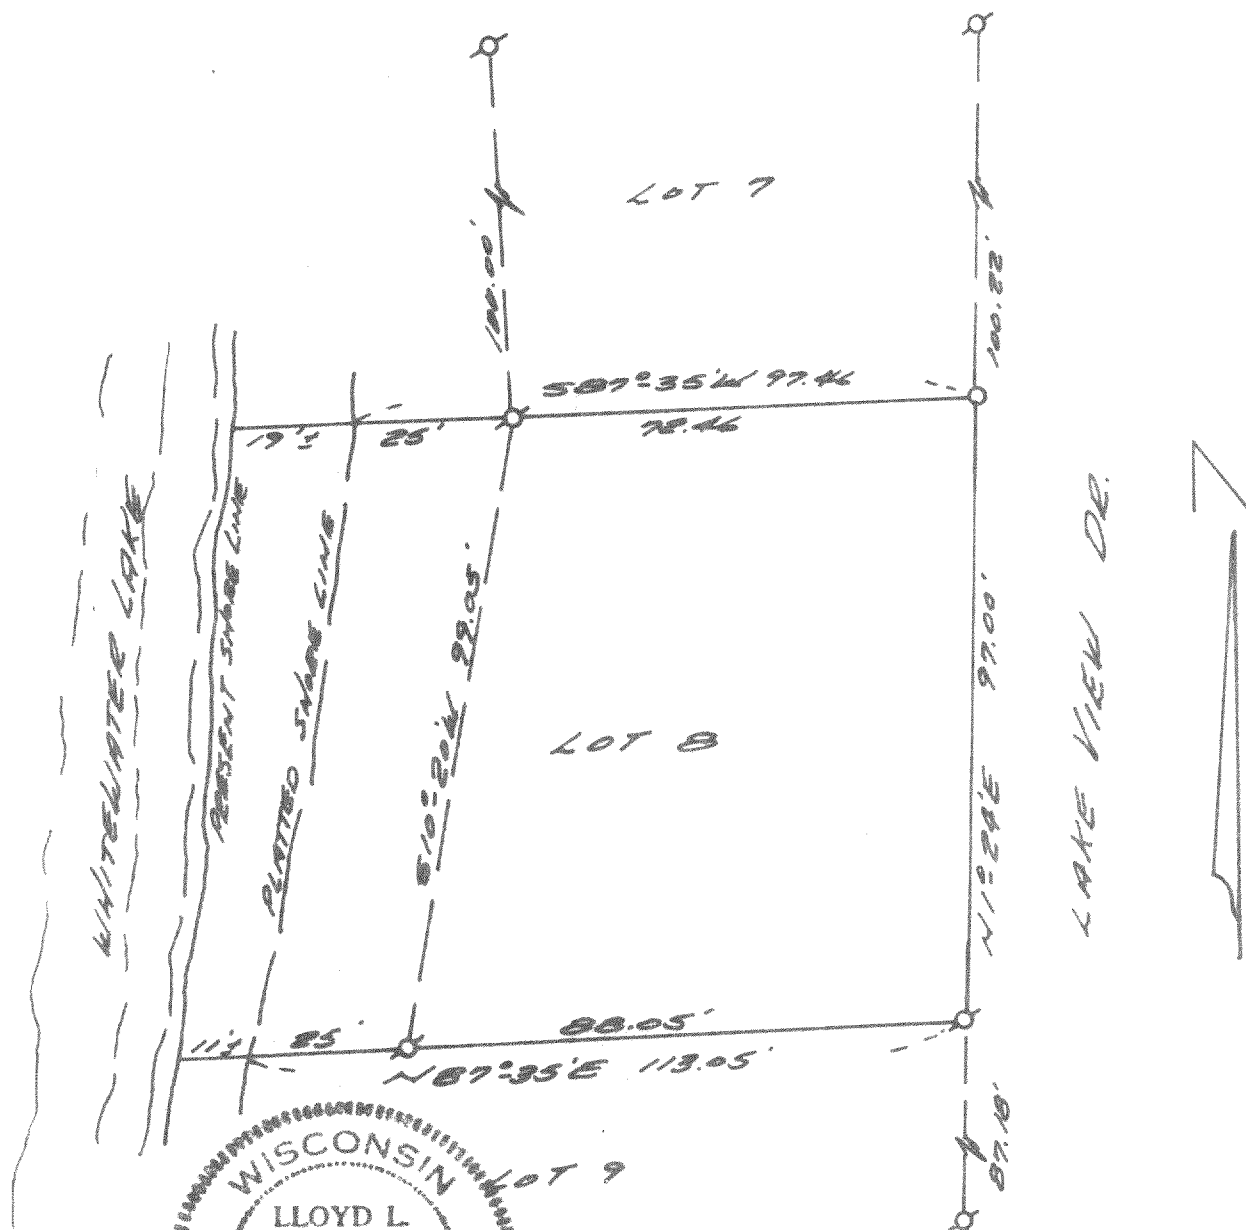

SURVEY AND PLAT BY
JENSEN & JOHNSON, INC.
CIVIL ENGINEERS AND SURVEYORS
Elkhorn, Wisconsin

LEGEND

- — Iron Pipe SET
- — Concrete Monument
- Scale 1" = 30'

⊗ — IRON PIPE FOUND

NOTE: BEARINGS &
DISTANCES AS

D65-17 PLATTED, DISTANCES MEAS.

WE CERTIFY: That we have surveyed the above described property and that the plat shown hereon is an accurate survey and a true representation thereof and correctly shows the exterior boundary lines and all divisions of said property.

Date SEPT. 1970

Lloyd L. Jensen
LLOYD L. JENSEN,

Wisconsin Registered Land Surveyor, No. S-211