

LAND-MARK SURVEYING

Mark L. Miritz

Wisconsin Registered Land Surveyor S-2582

N9330 Knuteson Drive
Whitewater, WI 53190
Phone: (262) 495-3284
MARKMIRITZ@
LAND-MARKSURVEYING.COM

PLAT OF SURVEY

LOTS 12 AND 13 IN BLOCK 3 OF LUDTKE'S SUBDIVISION,
LOCATED IN THE NORTHEAST 1/4 OF THE NORTHEAST 1/4
OF SECTION 34, TOWN 4 NORTH, RANGE 15 EAST, WHITE-
WATER TOWNSHIP, WALWORTH COUNTY, WISCONSIN.

ORDERED BY: MARV KROHN



TINCHER REALTY

532 WEST MAIN STREET
WHITEWATER, WI 53190

BAYVIEW DRIVE

(66' WIDE)

A.K.A. PINE KNOLLS DRIVE
SKYLINE DRIVE
(66' WIDE)

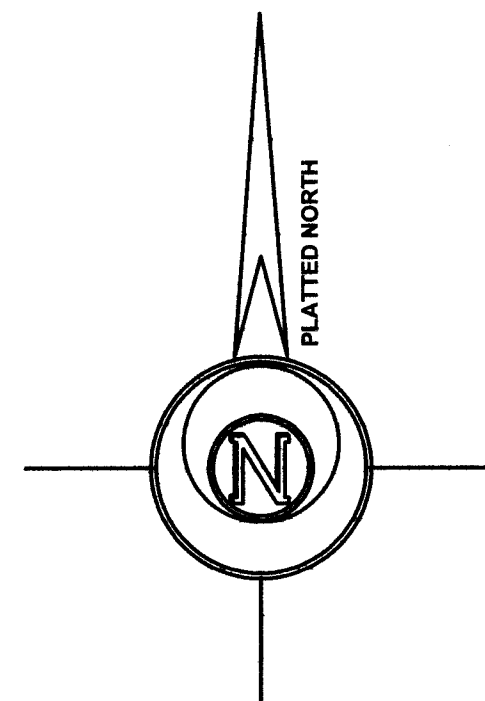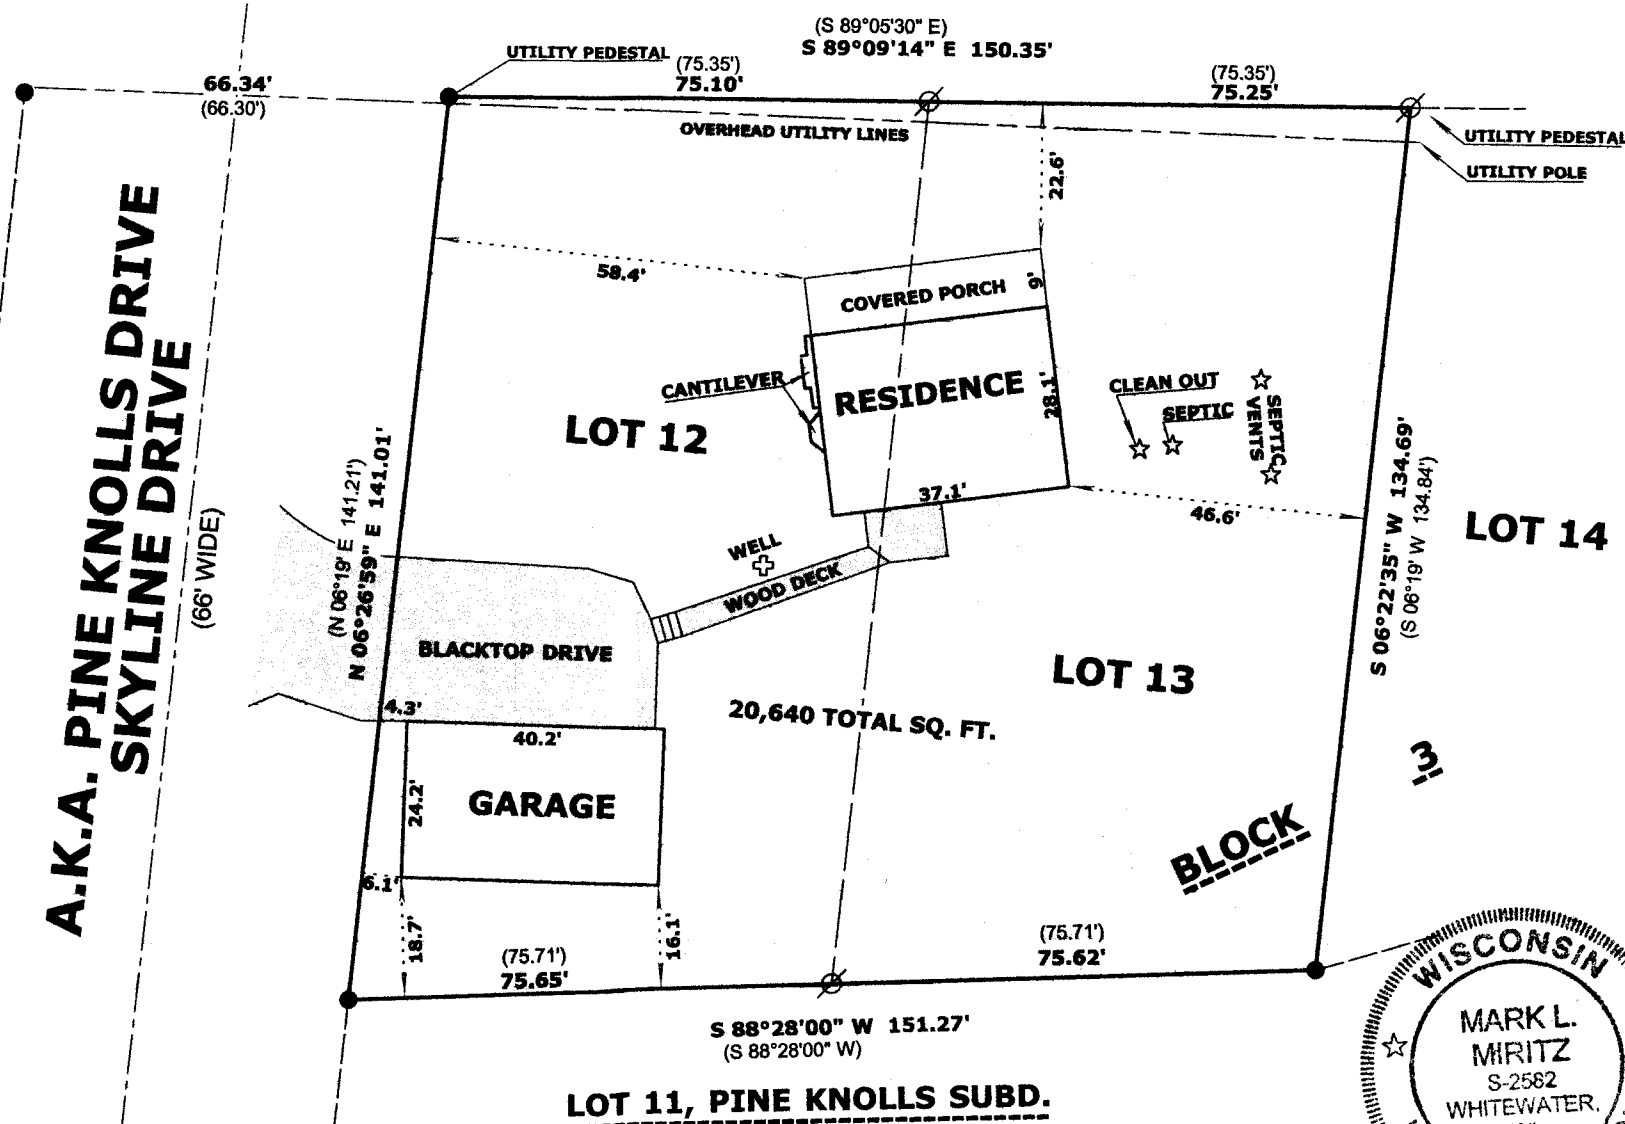

LEGEND

- FOUND IRON PIPE 1 1/4"
- FOUND IRON PIPE 2"
- RECORDED AS DIMENSION
- EXISTING FENCE

SCALE: 1 INCH = 30 FEET

"I hereby certify that the above described property has been surveyed by me or under my direction and that the above map is a true representation thereof and shows the size and location of the property, its exterior boundaries, the location of all visible structures and dimensions of all principal buildings thereon, boundary fences, apparent easements, roadways and visible encroachments, if any." "This survey is made for the use of the present owners of the property, and also those who purchase, mortgage, or guarantee the title thereto within one year from date hereof."

Mark L. Miritz
MARK L. MIRITZ
WISCONSIN REGISTERED
LAND SURVEYOR S-2582

DATE: MARCH 30, 2014 JOB NO. 14.307



dL8 -33
dL8 -34

415-1313