


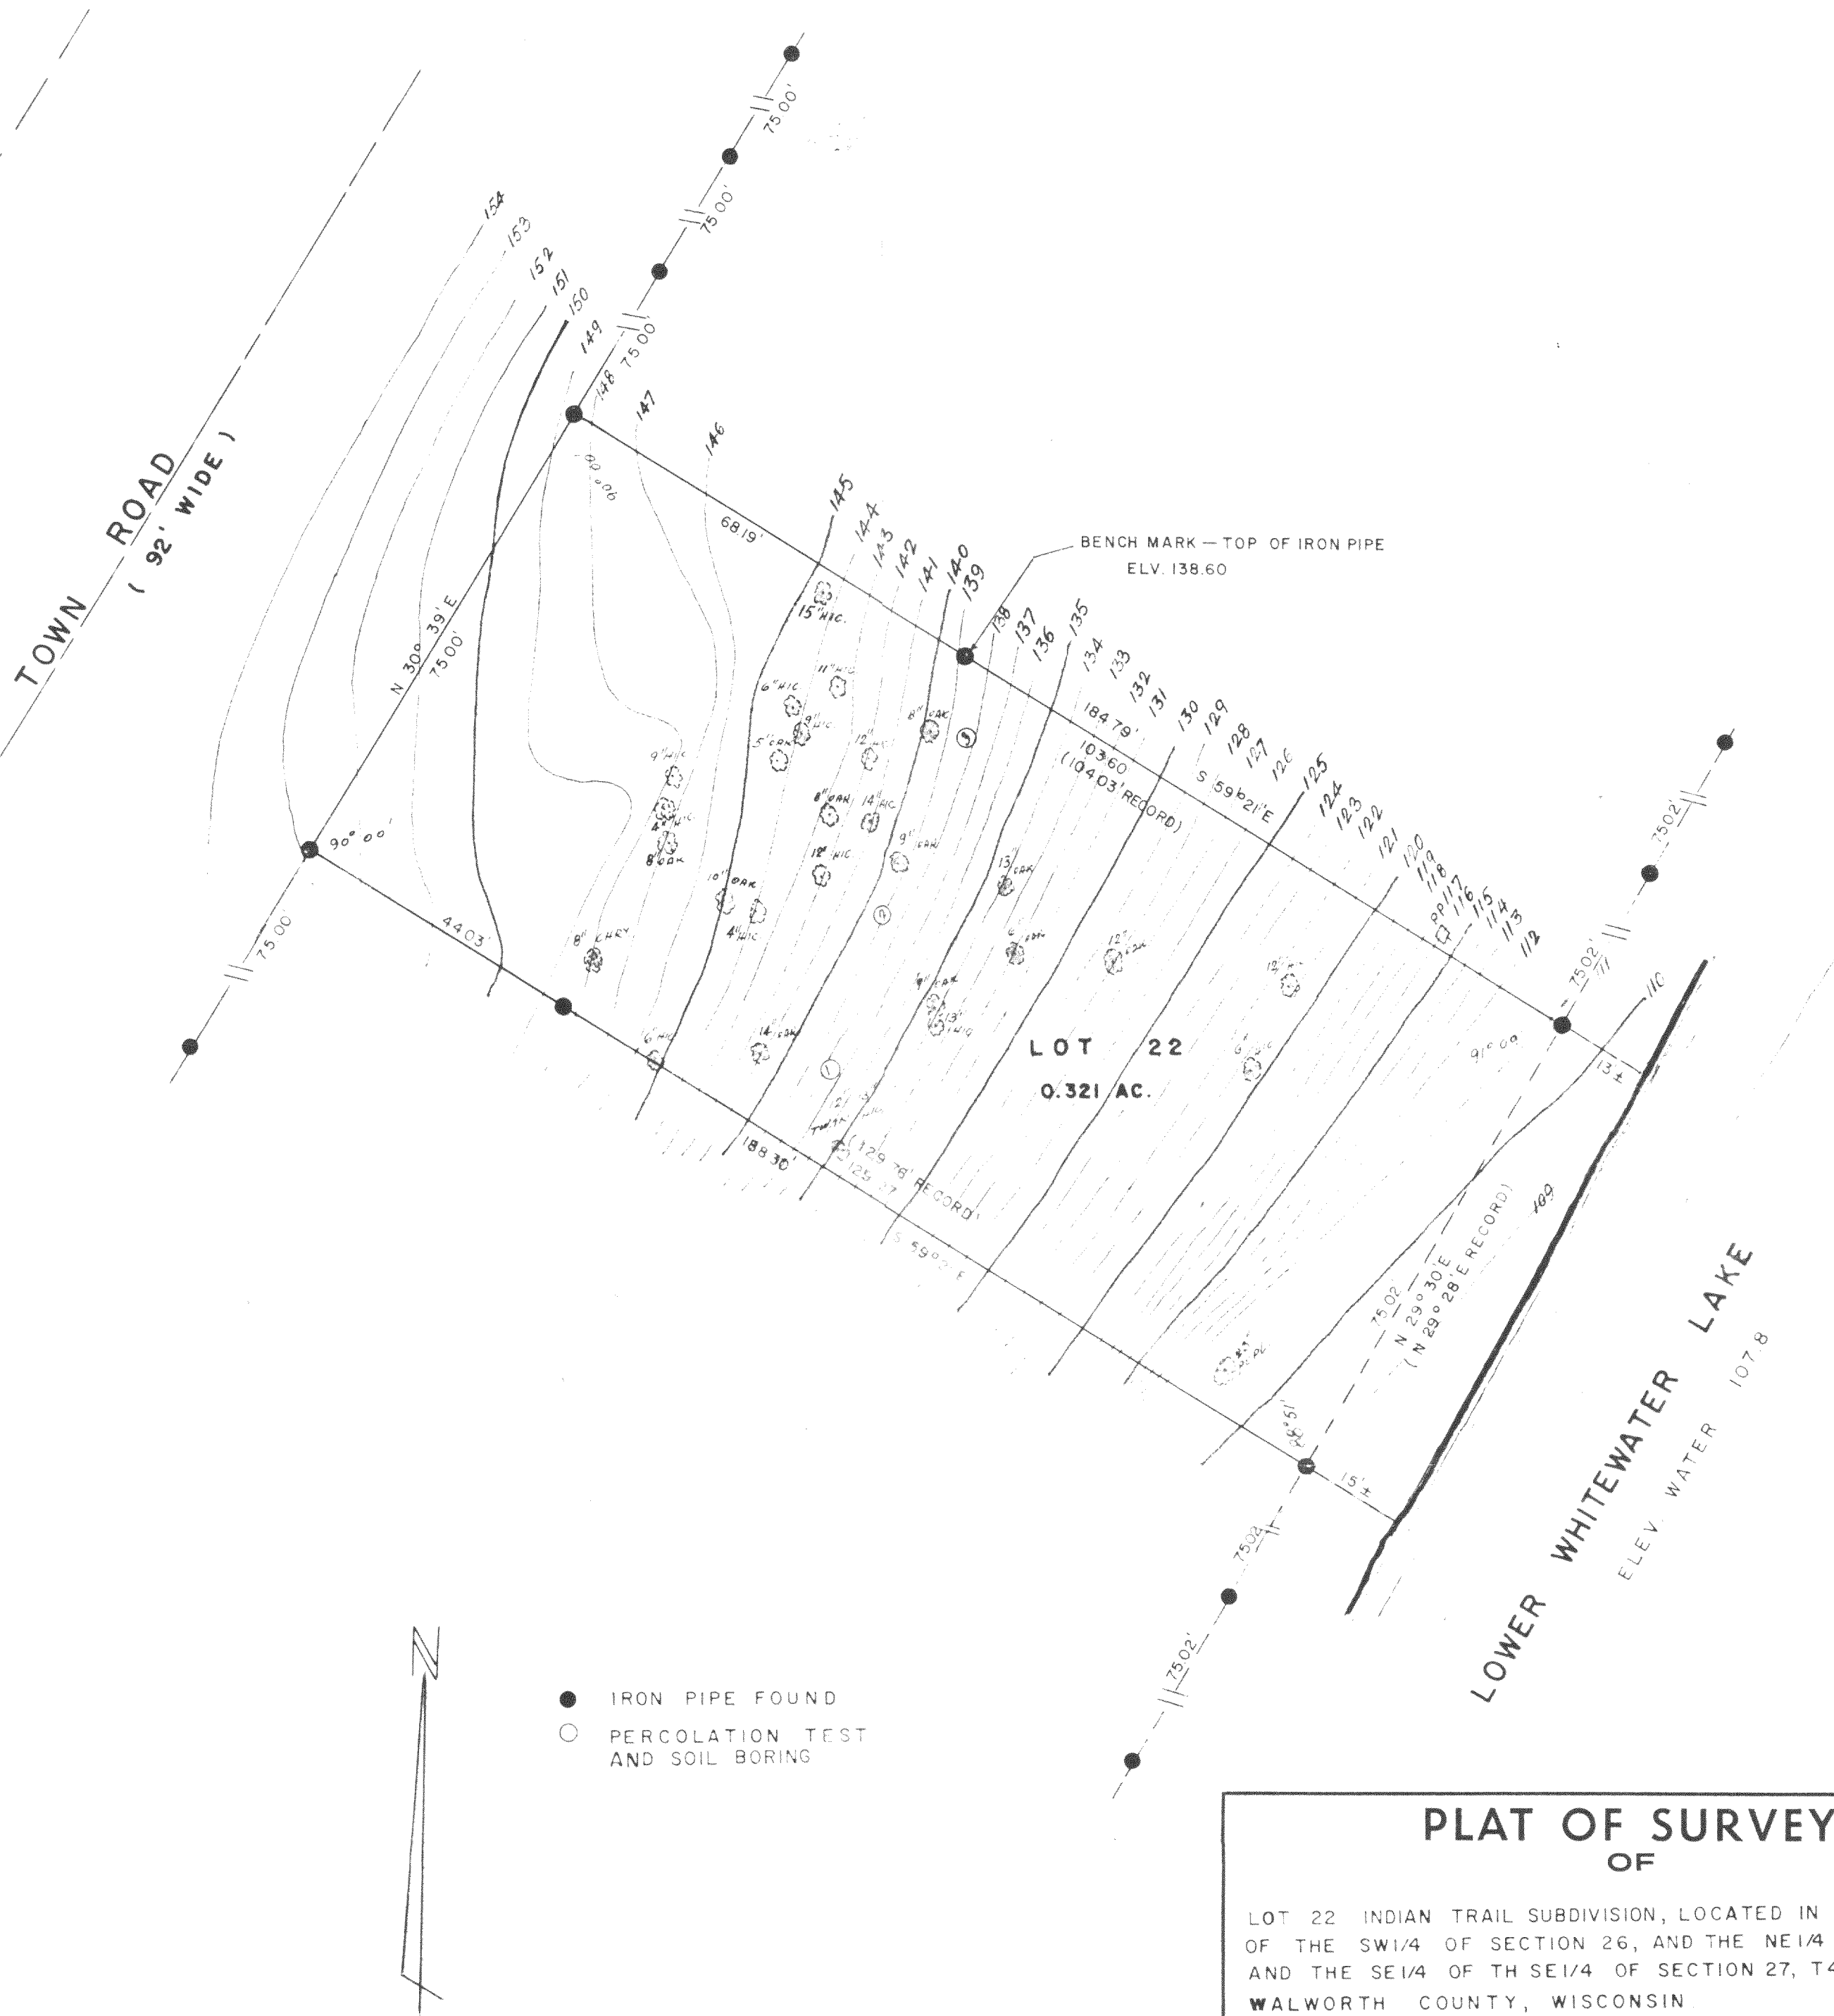

- IRON PIPE FOUND
- PERCOLATION TEST AND SOIL BORING

PLAT OF SURVEY OF

LOT 22 INDIAN TRAIL SUBDIVISION, LOCATED IN THE NW 1/4 OF THE SW 1/4 OF SECTION 26, AND THE NE 1/4 OF THE SE 1/4, AND THE SE 1/4 OF TH SE 1/4 OF SECTION 27, T4N R15E WALWORTH COUNTY, WISCONSIN

Royal L. Pearson
SURVEYOR

SCALE 1" = 20'

DATE APRIL 17 1974

ITS-46