


LAND-MARK SURVEYING
Mark L. Miritz
Wisconsin Registered Land Surveyor S-2582

N9330 Knuteson Drive
Whitewater, WI 53190
Phone: (262)495-3284
MARKMIRITZ@
LAND-MARKSURVEYING.COM

LOT 1 OF CERTIFIED SURVEY MAP NO. 2790,
LOCATED IN THE NORTHEAST 1/4 OF THE
NORTHWEST 1/4 OF SECTION 31, TOWN 4
NORTH, RANGE 15 EAST, WHITEWATER
TOWNSHIP, WALWORTH COUNTY, WISCONSIN

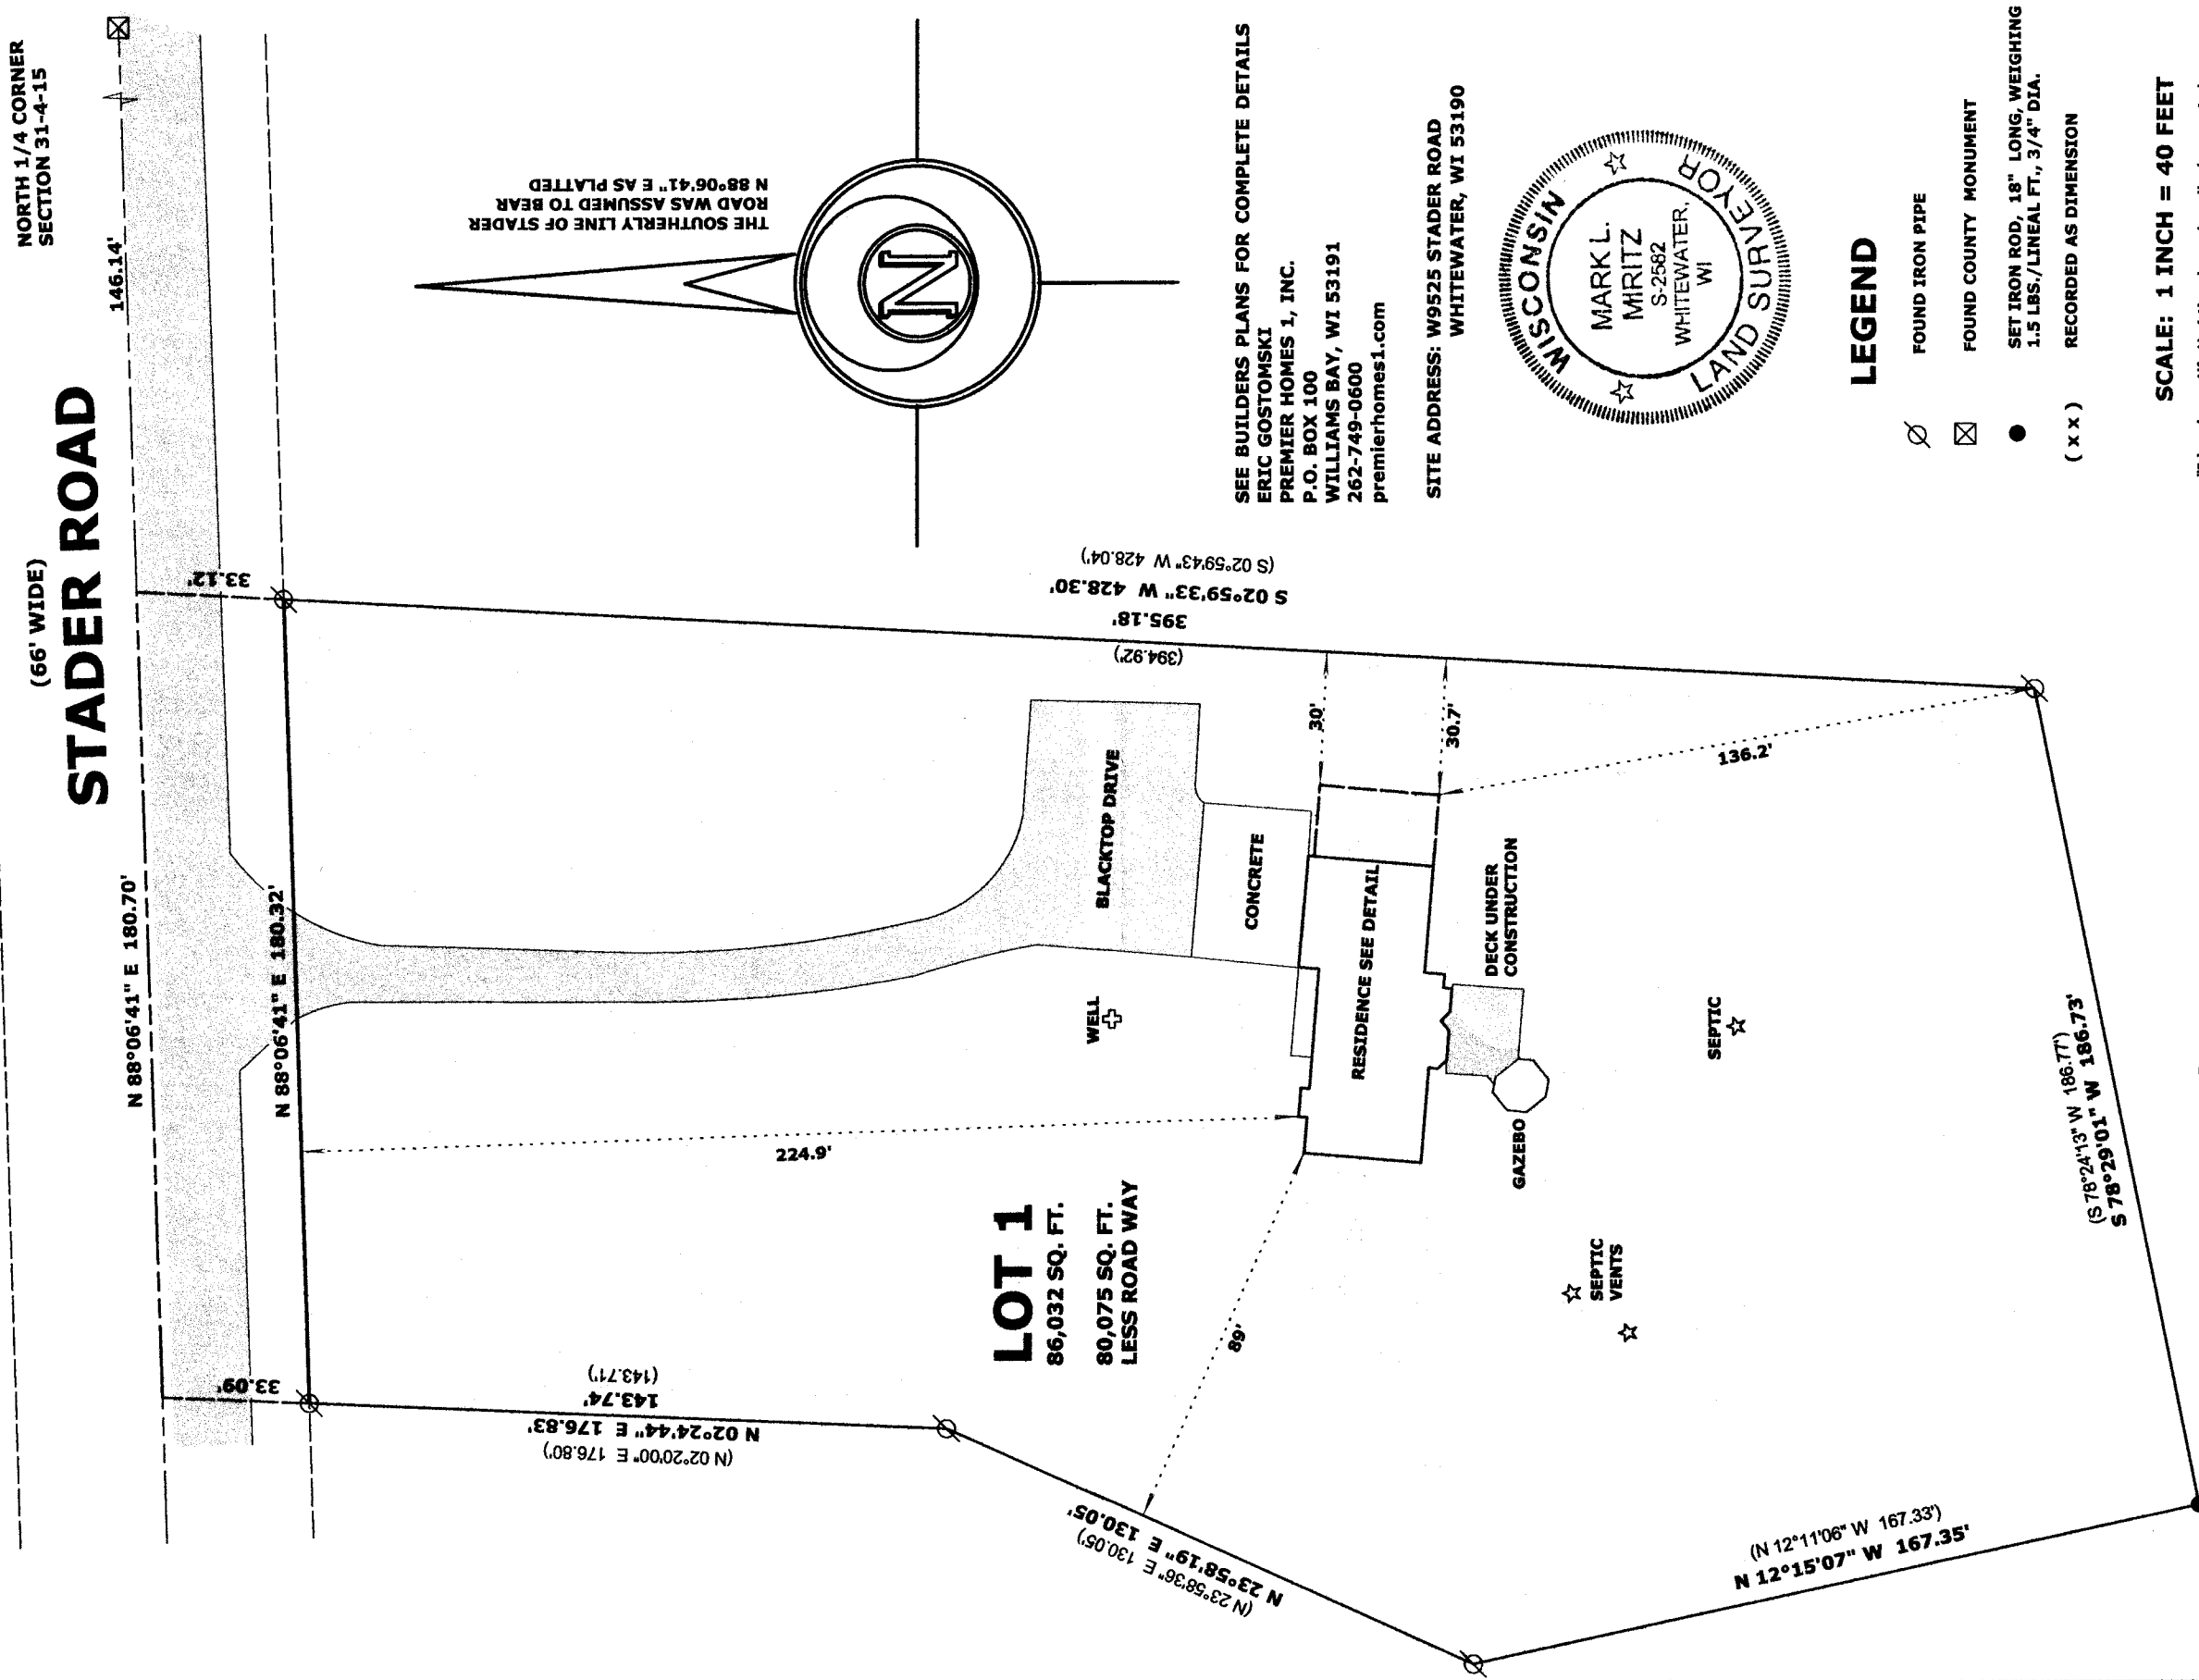

RECEIVED
JUN 20 2014
By Jan

"I hereby certify that the above described property has been surveyed by me or under my direction and that the above map is a true representation thereof and shows the size and location of the property, its exterior boundaries, the location of all visible structures and dimensions of all principal buildings thereon, boundary features, apparent easements, roadways and visible encroachments, if any."

"This survey is made for the use of the present owners of the property, and also those who purchase, mortgage, or guarantee the title thereto within one year from date hereof."

Mark L. Mirlitz
MARK L. MIRLITZ

**WISCONSIN REGISTERED
LAND SURVEYOR S-2582**

LAND SURVEYOR'S 25002

415-1320

DATE: MAY 28, 2014

JOB NO. 14.505