



LAND-MARK SURVEYING
Mark L. Miritz
Wisconsin Professional Land Surveyor S-2582

N9330 Knuteson Drive
Whitewater, WI 53190
Phone: (262)495-3284
MARKMIRITZ@
LAND-MARKSURVEYING.COM

PLAT OF SURVEY

**LOT 7, BLOCK 3 OF GRAND VIEW SUBDIVISION,
LOCATED IN THE SOUTHEAST 1/4 OF SECTION
34, TOWN 4 NORTH, RANGE 15 EAST, WHITEWATER
TOWNSHIP, WALWORTH COUNTY, WISCONSIN.**

OWNER: LUDTKE REVOCABLE LIVING TRUST
N7408 GRANDVIEW DRIVE
WHITEWATER, WI 53190

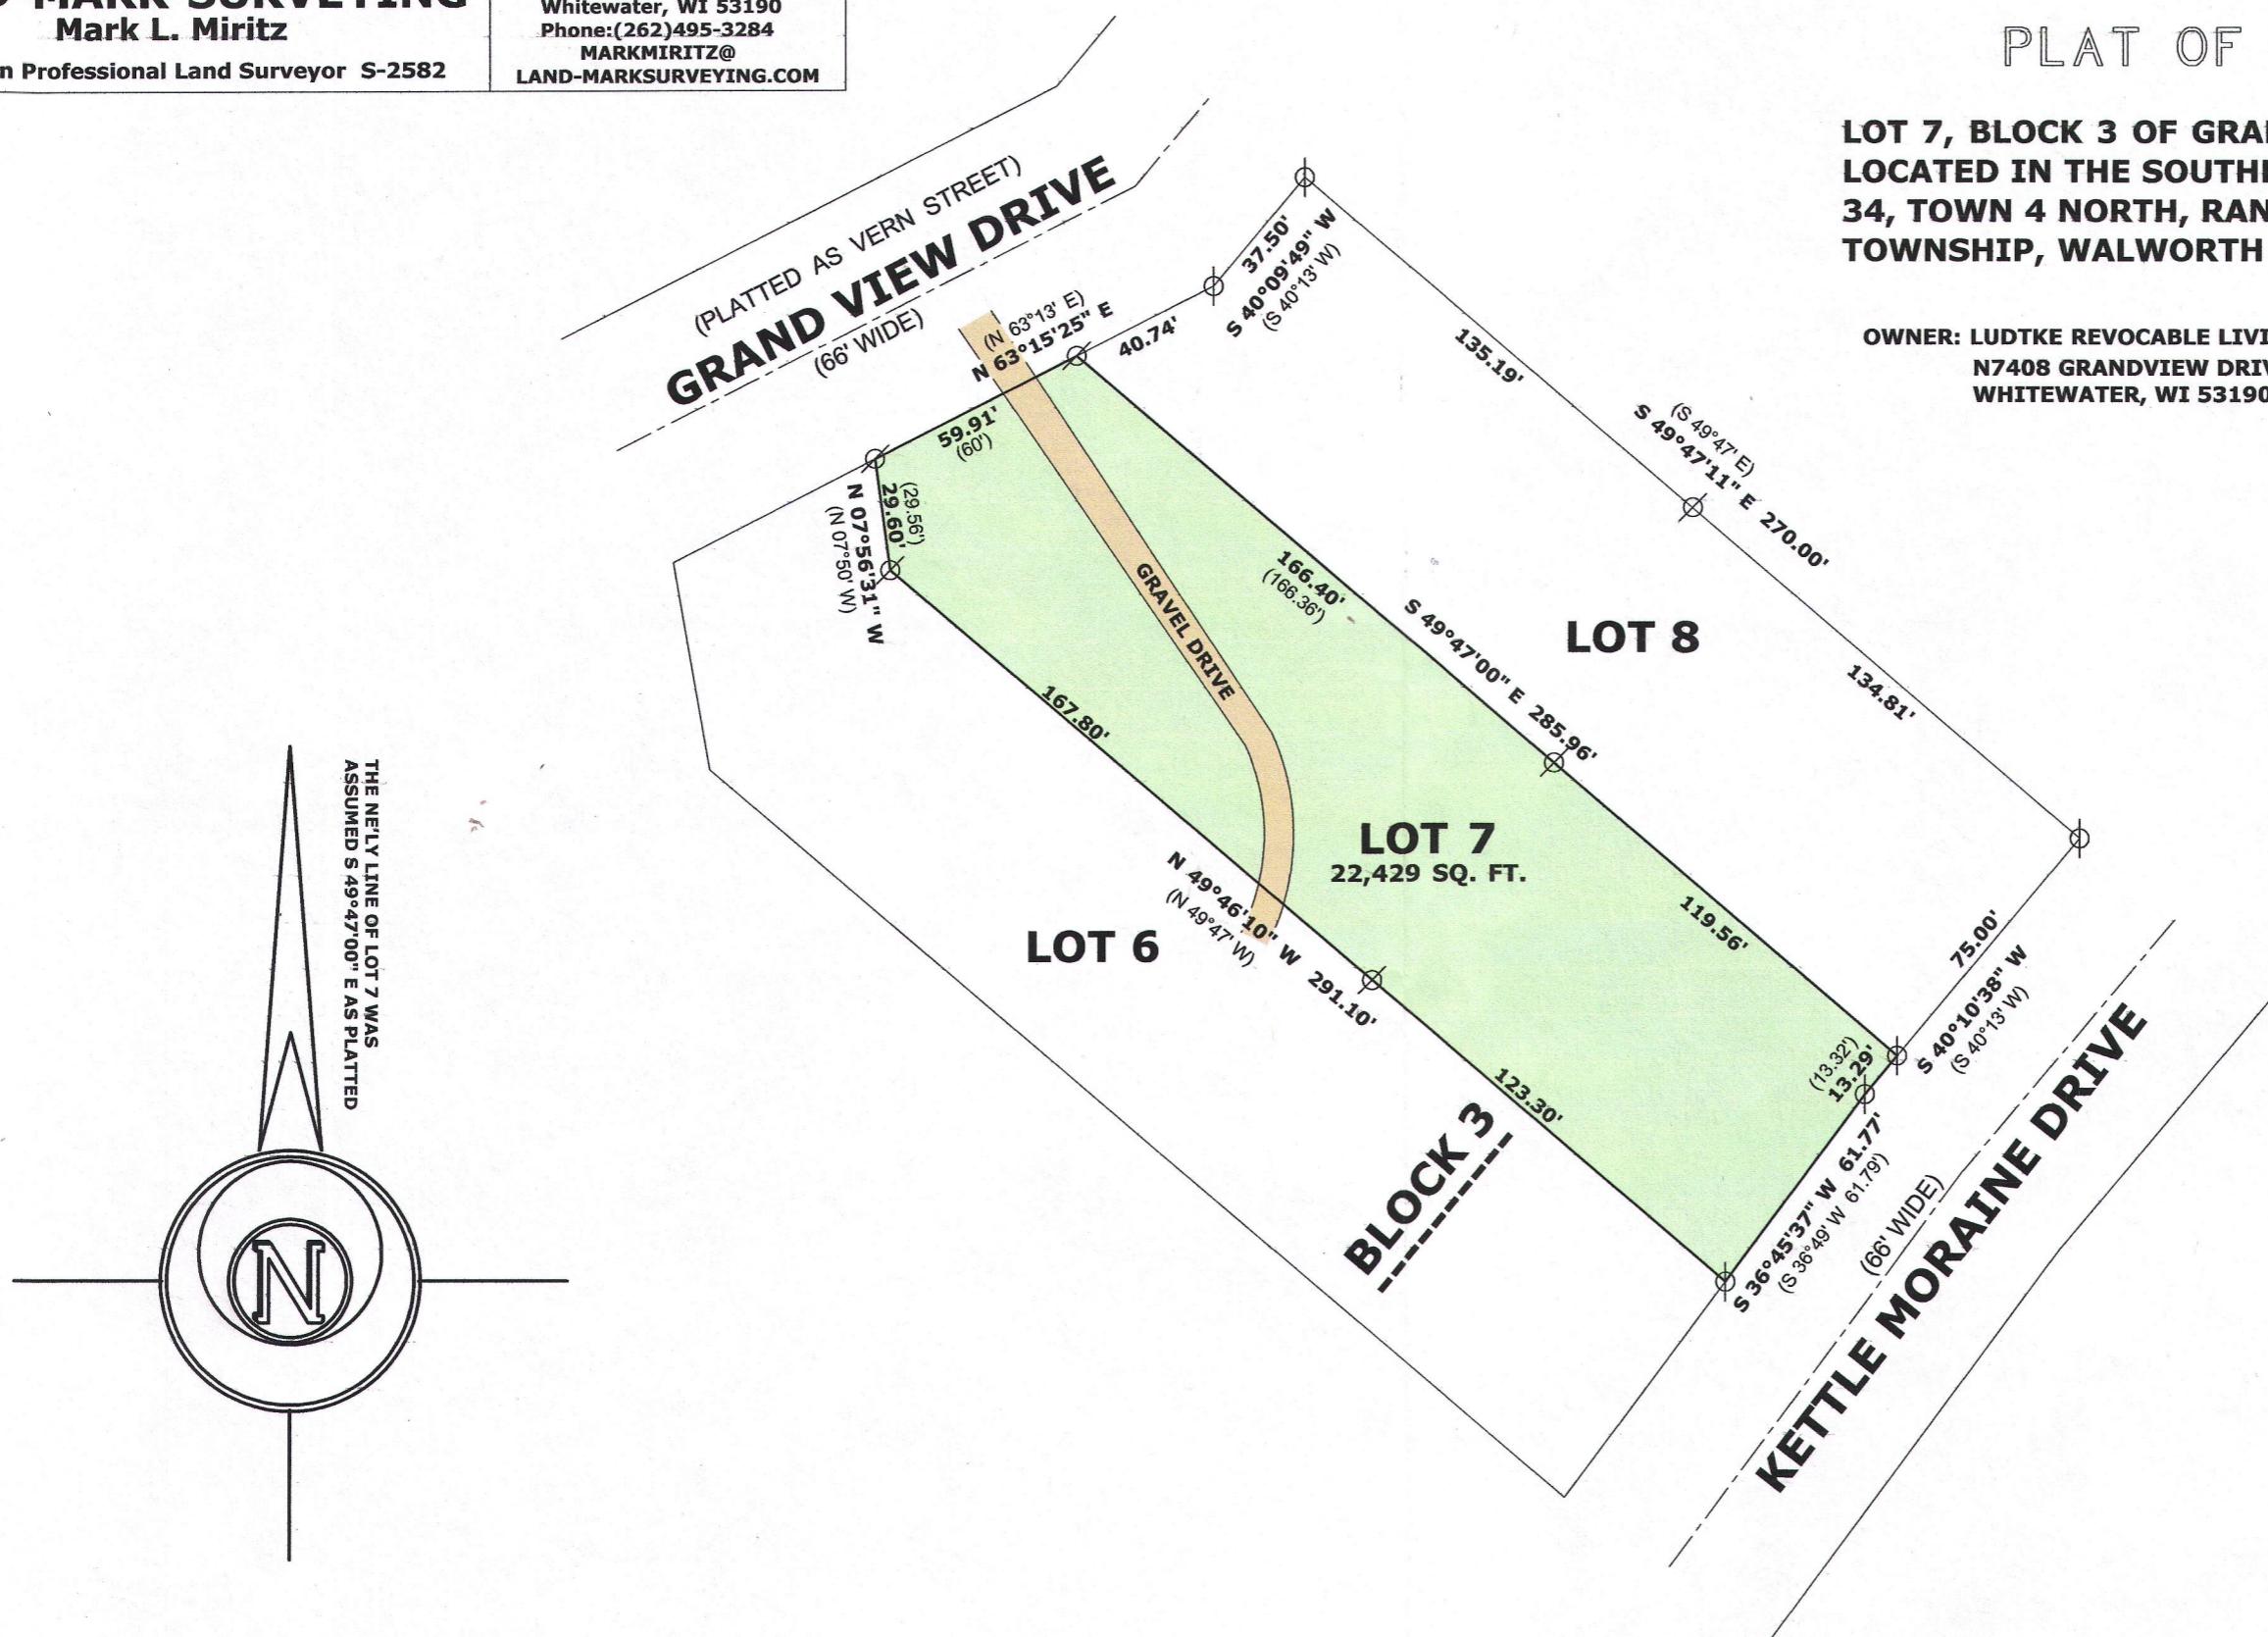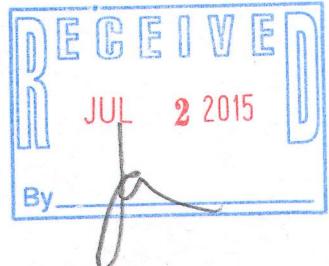

dGd-25

415-1356