


PLAT OF SURVEY

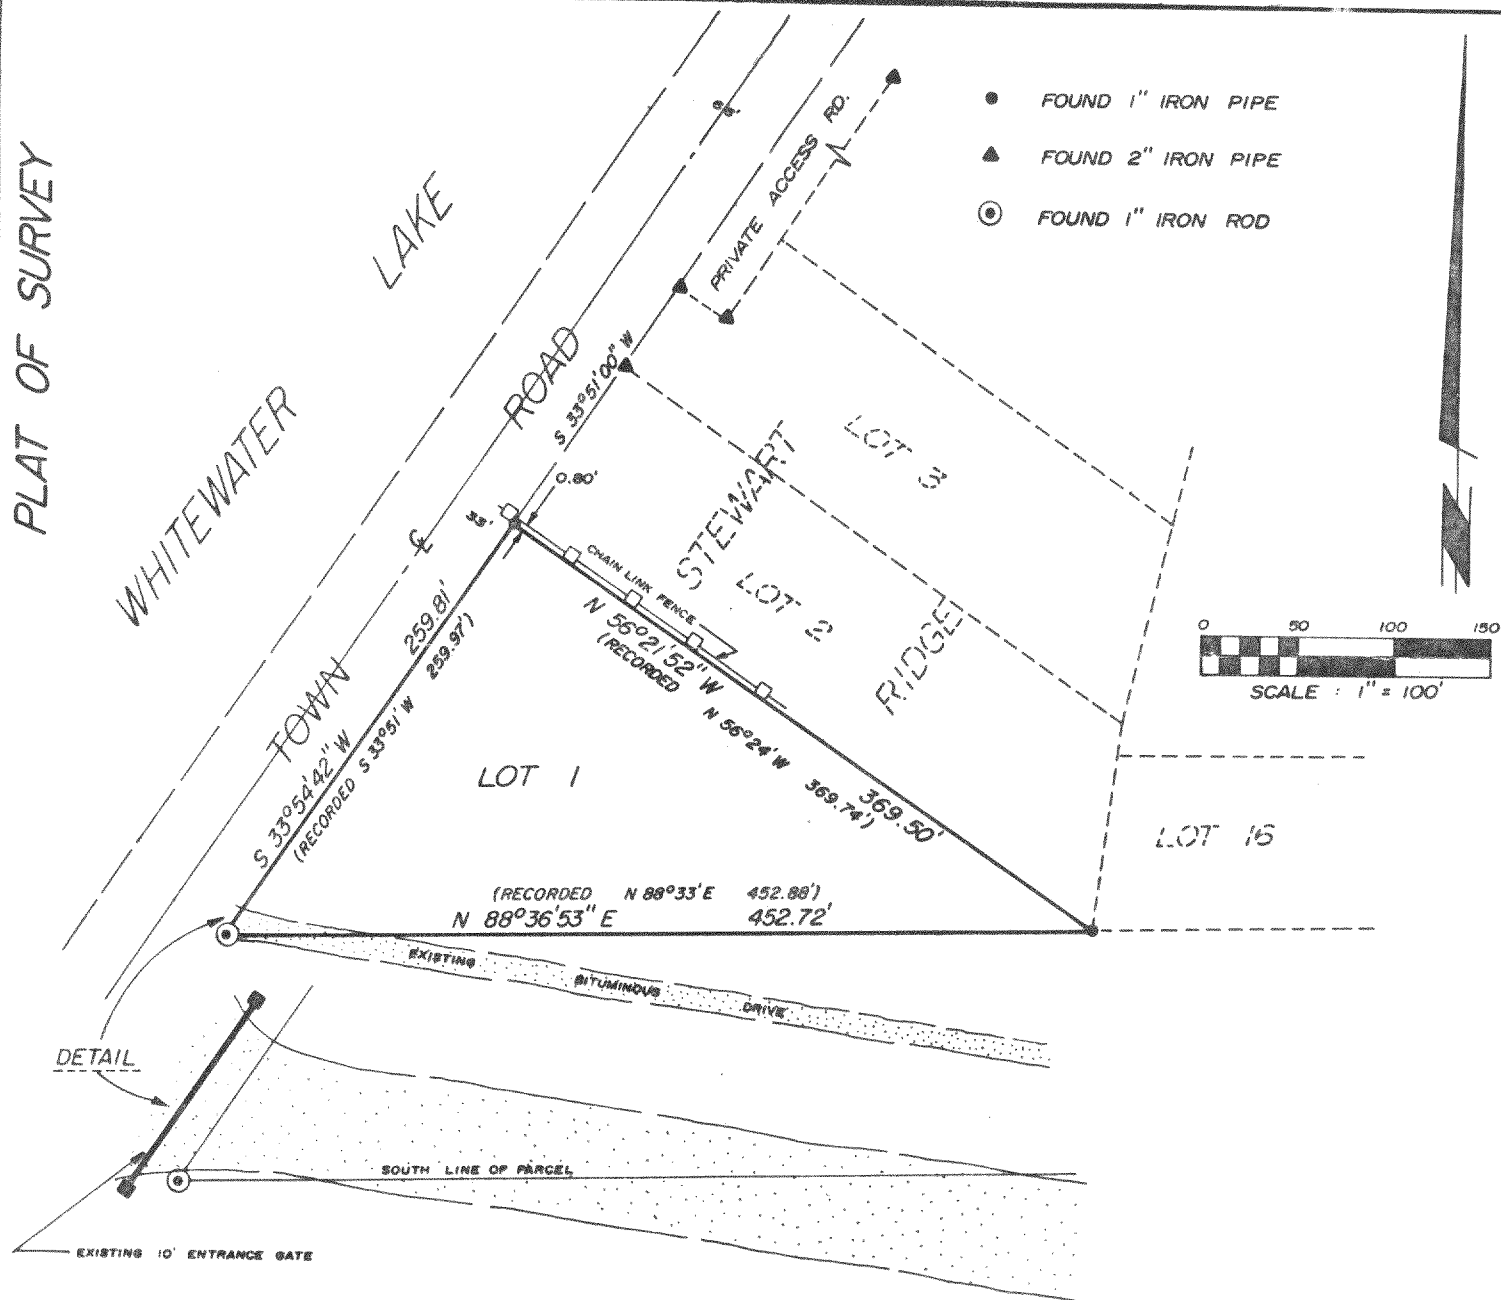

DESCRIPTION

Lot 1, STEWART RIDGE in the SE $\frac{1}{4}$ of the SW $\frac{1}{4}$ of Section 35, T4N, R15E, Town of Whitewater, Walworth County, Wisconsin.


CERTIFICATION

I hereby certify that the property described above has been surveyed under my responsible direction and supervision and that this map is a correct representation of the lot lines and dimensions and the principle lines of the permanent structures thereon.

Date 6-2-78


James B. Woodman
Registered Land Surveyor, S-1239

Prepared for: John Dwinell
c/o Projector Belt Co.
200 East Clay
Whitewater, WI 53190

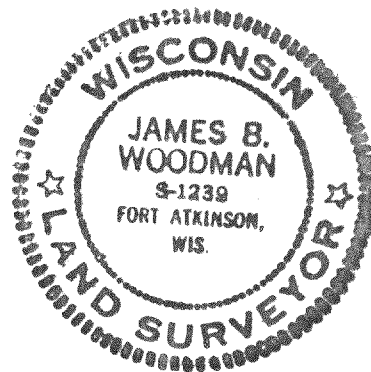

JN 78S-67

STRAND & WOODMAN ASSOCIATES
210 Madison Ave., Fort Atkinson, WI 53538

Land Surveyors & Engineers
Phone (414) 563-8182

415-136