

LOT 1 OF CERTIFIED SURVEY MAP NO. 1238, BEING RECORDED IN VOLUME 5 OF CERTIFIED SURVEY MAPS OF WALWORTH COUNTY, WISCONSIN, AS DOCUMENT NO. 81644 AND LOCATED IN THE NW 1/4 OF THE NW 1/4 OF SECTION 20, T.4N., R. 15E. OF THE 4TH P.M., TOWN OF WHITEWATER, WALWORTH COUNTY, WISCONSIN.



STATE OF WISCONSIN
COUNTY OF ROCK SS.

I HEREBY CERTIFY THAT I HAVE SUPERVISED THE SURVEY OF THE PROPERTY DESCRIBED ABOVE FOR THE EXCLUSIVE USE OF ART HUGHES AND THAT TO THE BEST OF MY KNOWLEDGE AND BELIEF THE PLAT HEREON DRAWN CORRECTLY REPRESENTS SAID SURVEY AND ITS LOCATION.

GIVEN UNDER MY HAND AND SEAL THIS 25th DAY OF AUGUST, 2015, AT JANESVILLE, WISCONSIN.

RONALD J. COMBS. PLS NO. 1330

If the surveyor's signature is not red in color, the map is a copy and may contain unauthorized alterations. The certification contained hereon shall not apply to any copies.

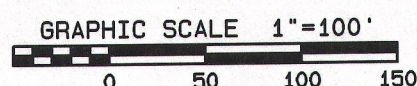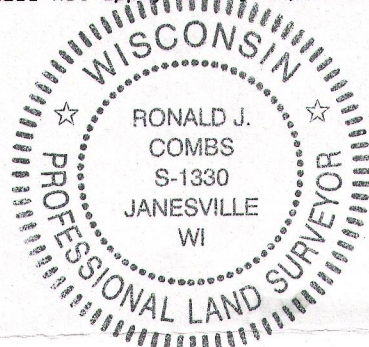

LEGEND:



- SET IRON PIN, 3/4"x 24",
1.5 LBS./LIN.FT.
- FOUND IRON PIPE

NOTES:

THIS SURVEY IS SUBJECT TO ANY AND ALL EASEMENTS AND AGREEMENTS, RECORDED AND UNRECORDED.

ASSUMED S1°46'46"W ALONG THE WEST LINE OF THE
NW 1/4 OF SECTION 20-4-15.

Project No. 115 - 295 For: HUGHES

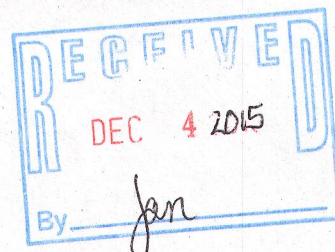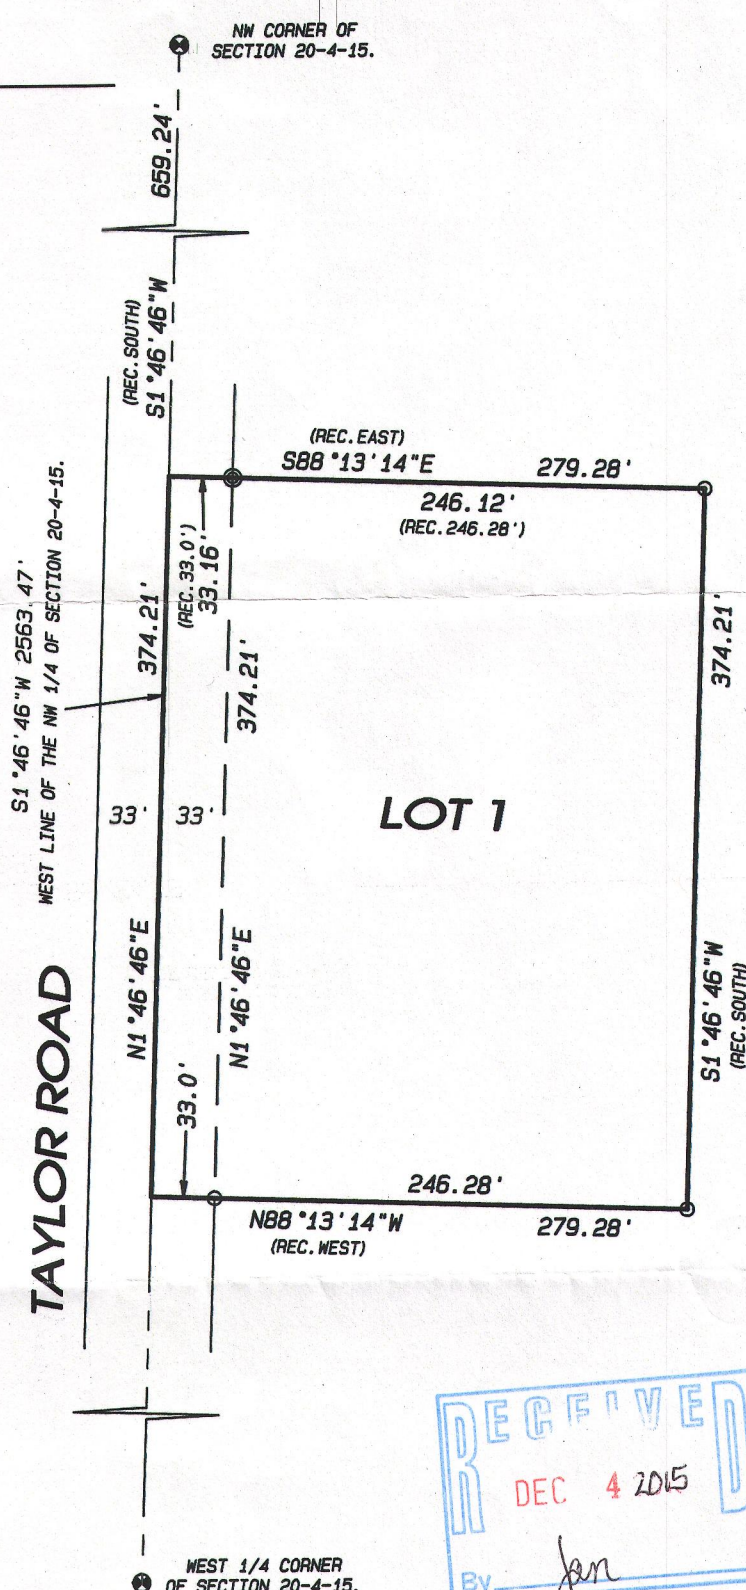

Combs
& ASSOCIATES, INC.

- LAND SURVEYING
- LAND PLANNING
- CIVIL ENGINEERING

109 W. Milwaukee St.
Janesville, WI 53548
www.combssurvey.com

tel: 608 752-0575
fax: 608 752-0534

LA1238-1

415-1367