


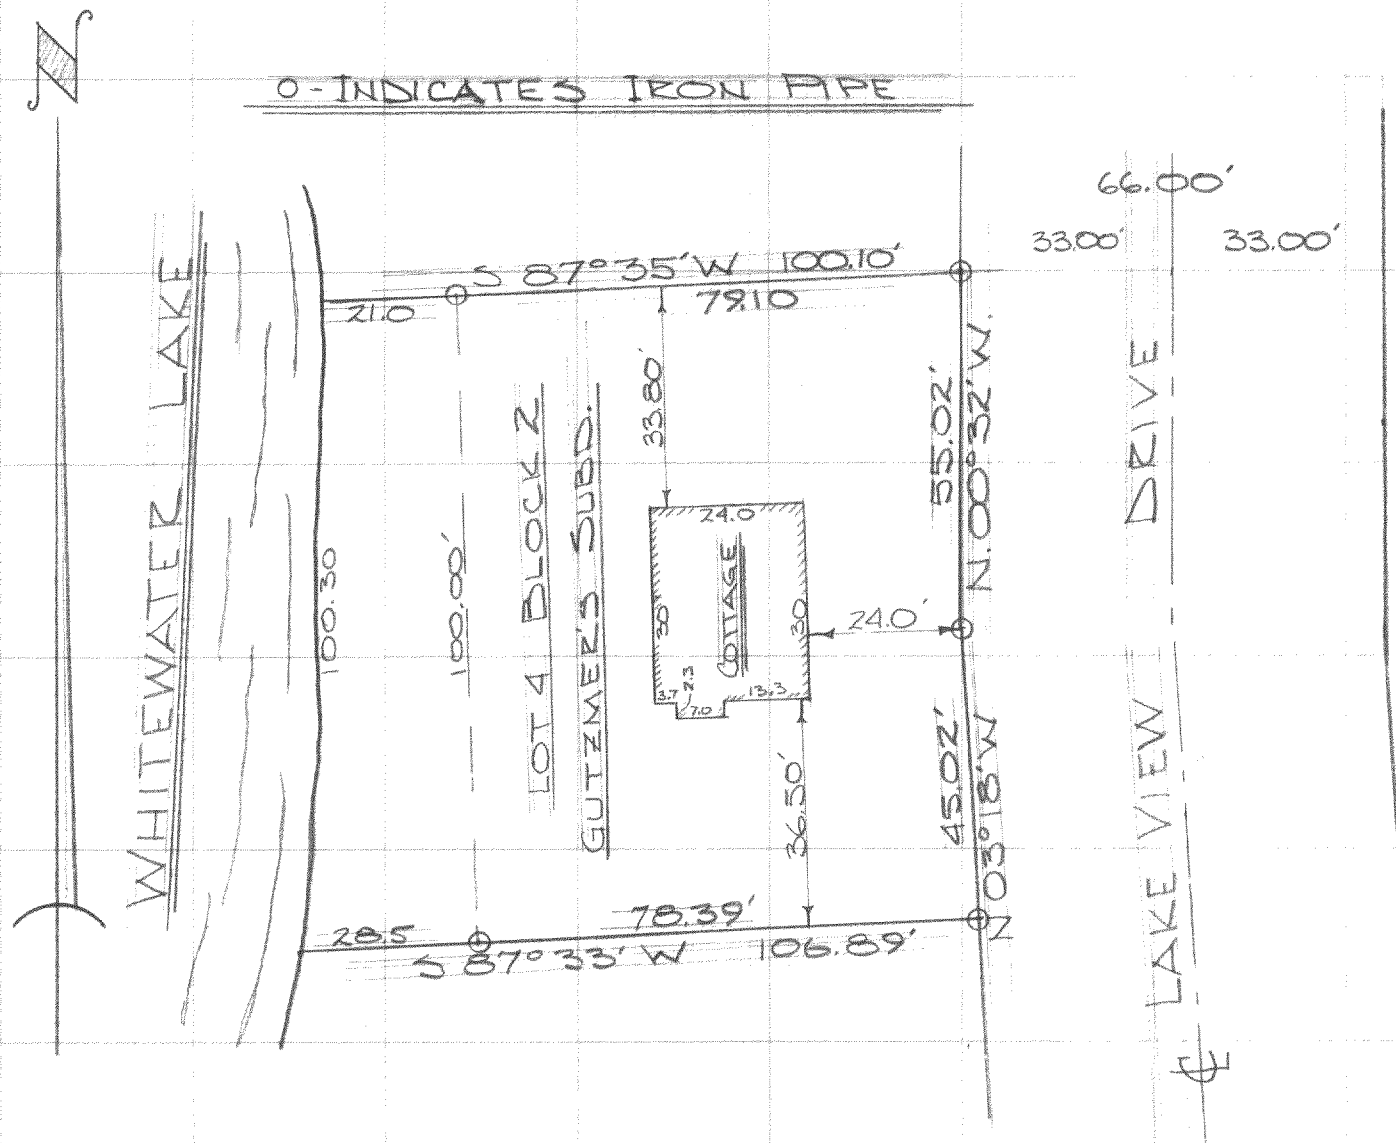

DESCRIPTION: Lot 4 of Block 2 of Gutzmer's Subdivision,
located in Section 25, T.4 N., R. 15 E.,
Whitewater Township, Walworth County, Wisc.

CERTIFICATE: I, James F. Biagi, surveyor, do hereby
certify that I have surveyed the property
hereon described.

March 14, 1967.

James F. Biagi
James F. Biagi, R/S 272
Elkhorn, Wisconsin

