



PREPARED FOR:
LOWELL MANAGEMENT,
401 GENEVA DRIVE, SUITE S
LAKE GENEVA, WI 53147

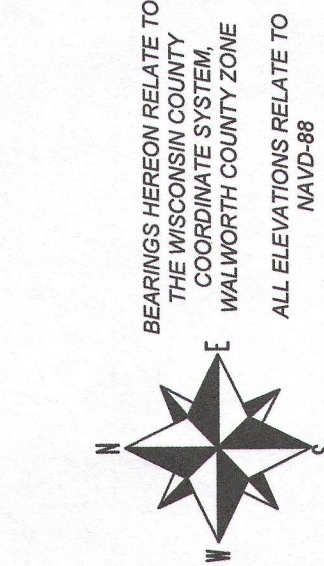

LYNCH & ASSOCIATES
ENGINEERING CONSULTANTS, LLC
4015 SKYLINE DRIVE, SUITE C
LAKE GENEVA, WI 53147
(262) 248-3697

LEGAL DESCRIPTION
LOT 7, IN BLOCK 2 OF GUTZMER'S SUBDIVISION, IN THE TOWN OF
WHITEWATER, COUNTY OF WALWORTH, STATE OF WISCONSIN.

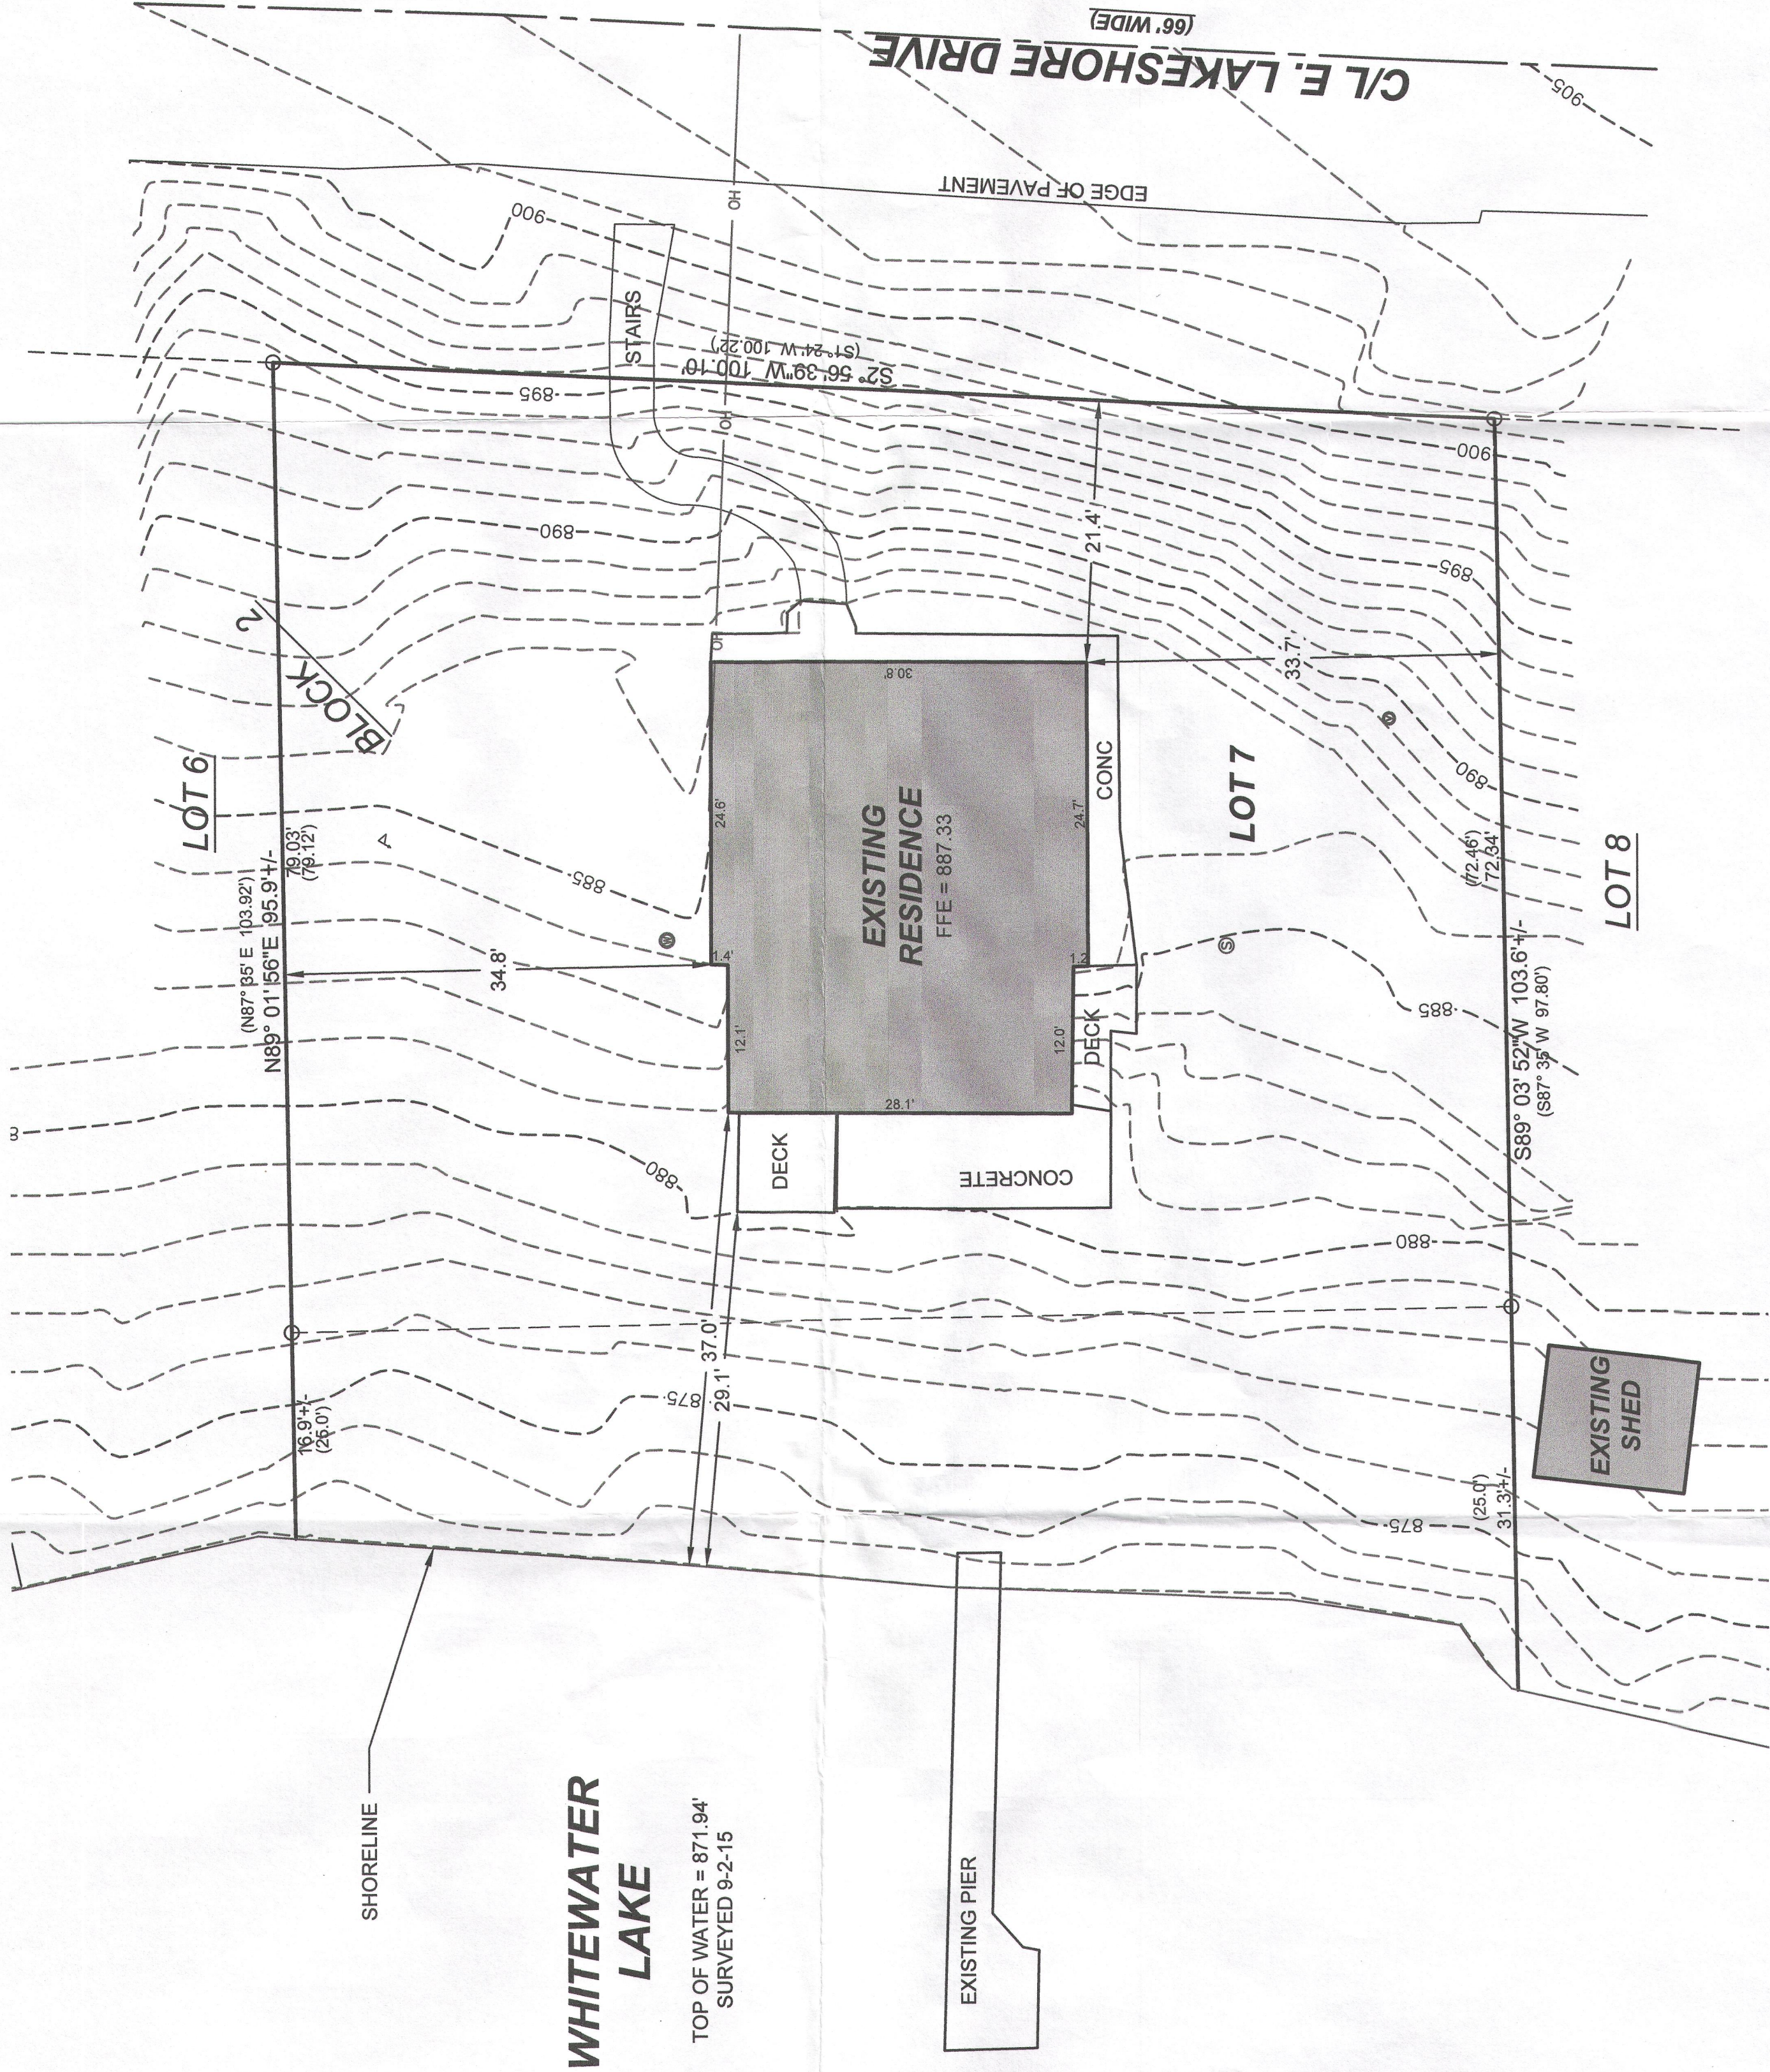



TOPOGRAPHIC PLAT OF SURVEY
- OF -
THE ALLER'S RESIDENCE
TOWN OF WHITEWATER, WALWORTH COUNTY, WISCONSIN

- LEGEND**
- FOUND 1" IRON PIPE
 - FOUND 5/8" IRON BAR
 - OH — OVERHEAD UTILITY
 - ⊙ POWER POLE
 - (XX) RECORDED AS
 - ⊙ SEPTIC TANK COVER
 - ⊙ SEPTIC VENT
 - SET 5/8"x18" IRON BAR 1.13W/LF
 - △ FLAG POLE
 - ⊙ WELL

NOTE:
No title commitment or results of a title search were provided to this office
pertaining to this survey. This Plat Of Survey may not reflect easements of
record, encumbrances, restrictions, ownership, title evidence, or other facts
that a current and accurate title search may disclose.

I have surveyed the above-described property and the above map is a true
representation thereof and shows the size and location of the property, its
exterior boundaries, the location and dimensions of all structures thereon,
fences, apparent easements and roadways, and visible encroachments, if
any.

This survey is made for the exclusive use of the present owners of the
property, and also those who purchase, mortgage, or insure the title thereto
within one (1) year from date hereof, and as to them I warrant the accuracy of
said survey map.

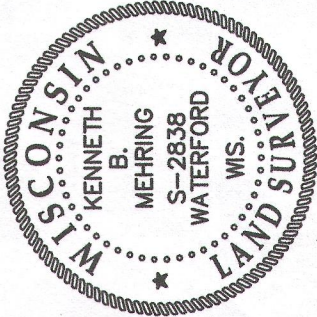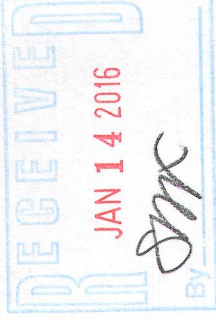

JOB # 15626
TAX ID # DGS 00016

FILENAME: C:\Egnyte\Shared\1 - Projects\2015\15.625 Lowell - Aller residence\CAD\Sheets\15.625 Topographic Survey.dwg

PLOT DATE: 9/16/2015 11:43 PM

415 1375