


PLAT OF SURVEY

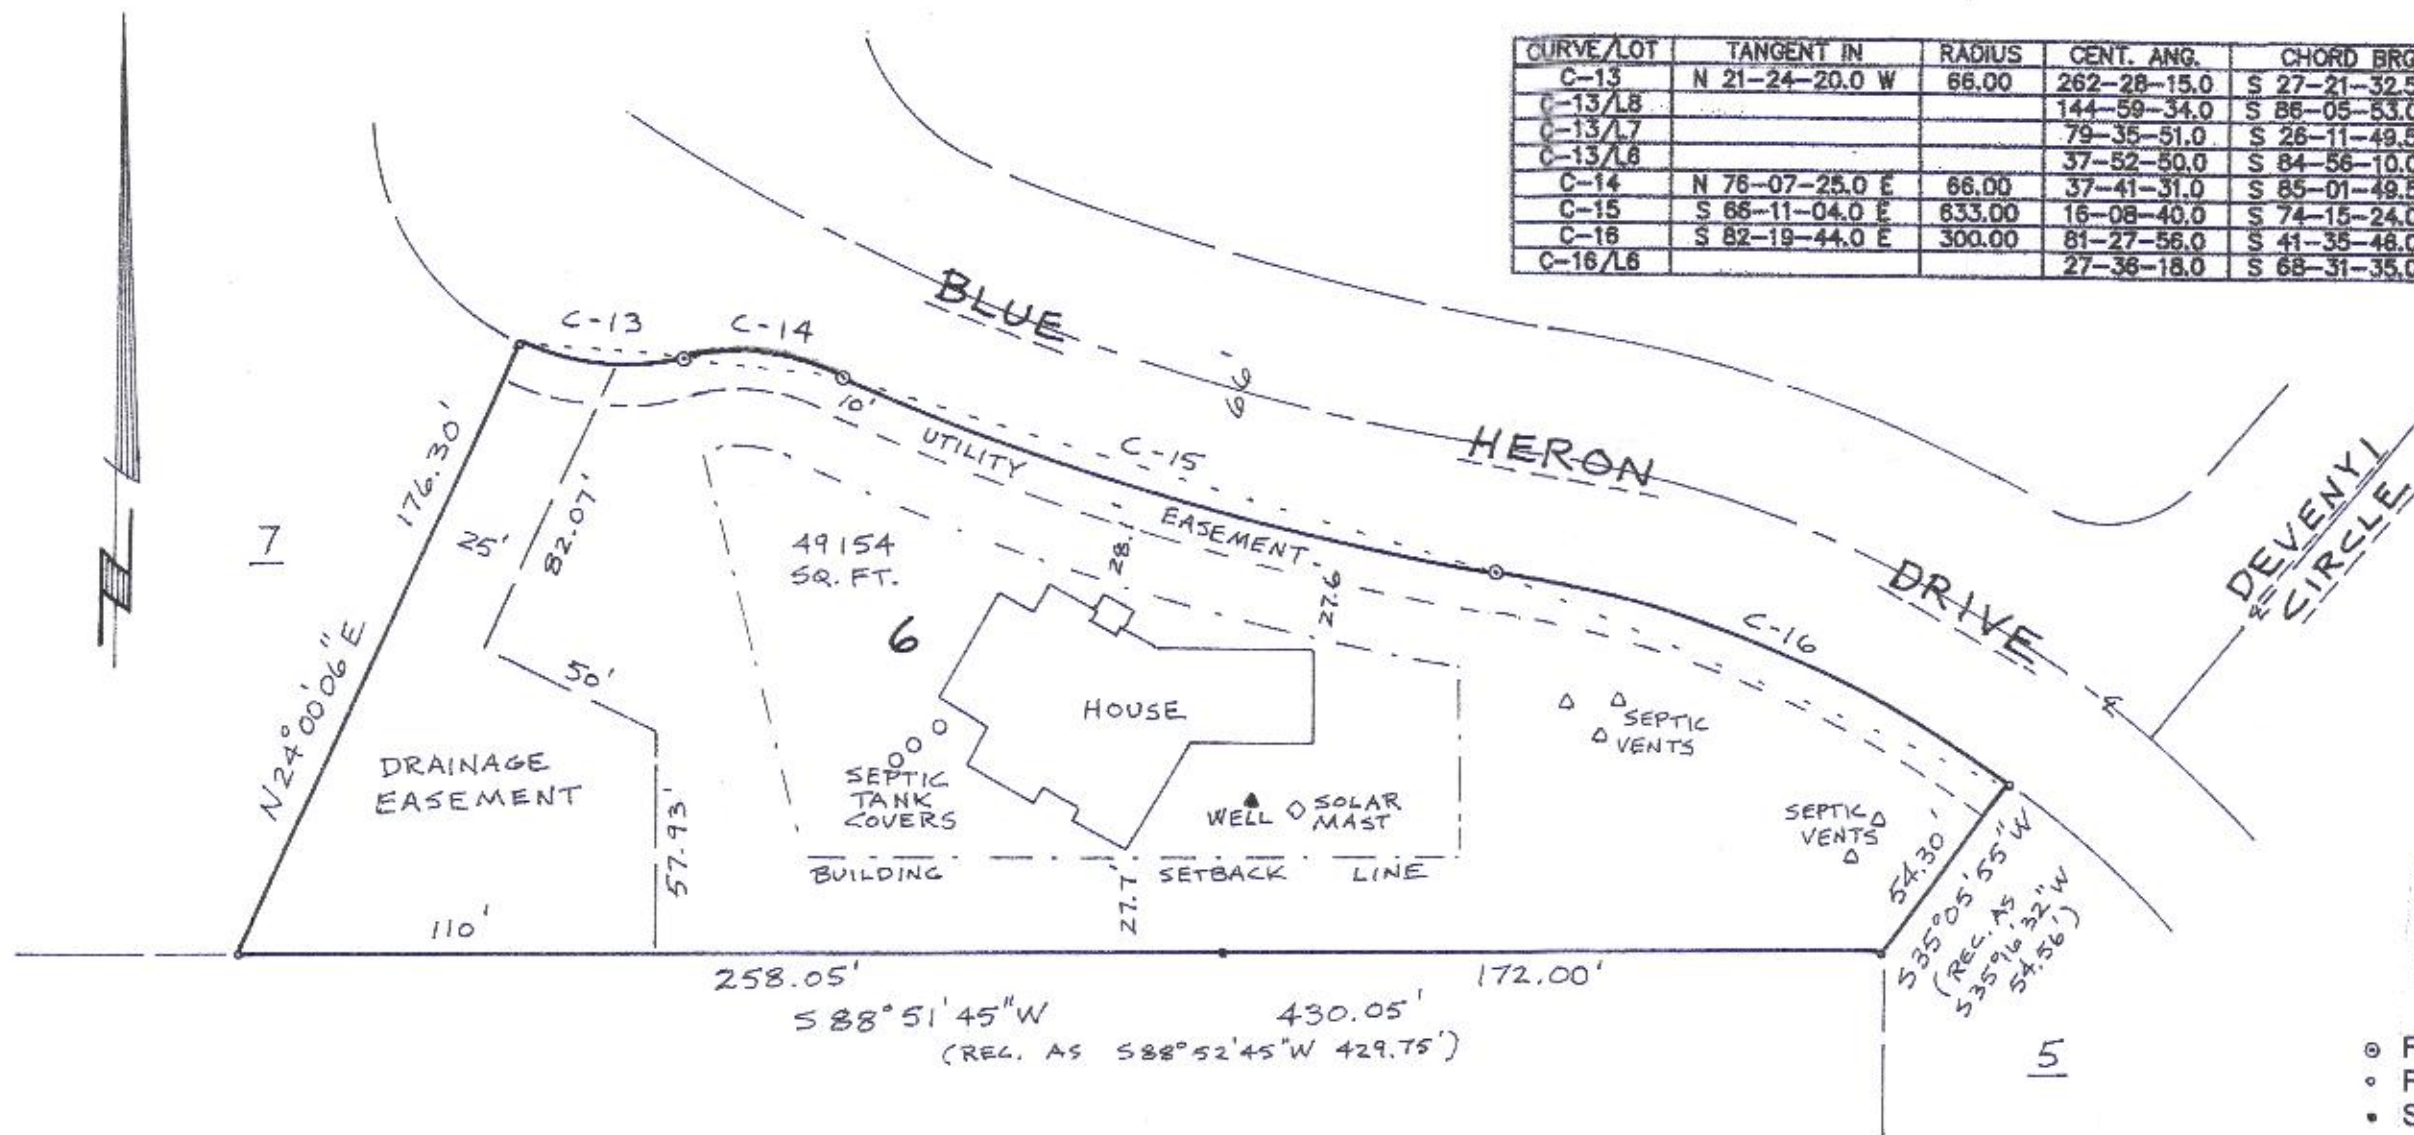

Prepared for:
Steve Holz
N1782 County Road D
Fort Atkinson, WI 53538

- Found 1 1/4" Iron Rod
- Found 3/4" Iron Rod
- Set 3/4" x 18" Iron Rod

NOTES:

- This parcel may be subject to any and all easements or agreements either recorded or unrecorded.
- Assumed north referenced to the westerly line of Lot 6 bearing S24°00'06"W.

LEGAL DESCRIPTION

Lot 6, BLUE HERON HILLS in the NE 1/4 of the SE 1/4 of Section 35, T4N, R15E, Town of Whitewater, Walworth County, Wisconsin.

CERTIFICATION

I hereby certify that the property described above has been surveyed under my responsible direction and supervision and that this map is an accurate representation of the lot lines and dimensions and principle lines of the permanent structures thereon to the best of my knowledge and belief.

Date: 8-26-19

Mark E. Anderson
Mark E. Anderson
Professional Land Surveyor, S-1370



ANDERSON LAND SURVEYING LLC

Mark E. Anderson, Professional Land Surveyor
W6141 Star School Road, Fort Atkinson, WI 53538
Tel: 920-563-8162 andersonlandsurvey@gmail.com

DBHH-6

415-1484