
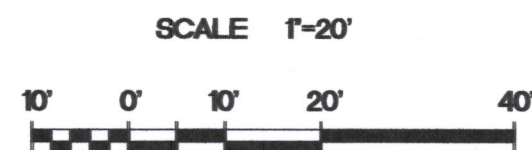


Plat of Survey
PARCELS 1 AND 2 OF CERTIFIED SURVEY MAP NO 78, being a redivision of Lot 18, in Thorne Heights, being a part of the Southeast 1/4 and Southwest 1/4 of Section 35, Town 4 North, Range 15 East, Walworth County, Wisconsin.

Surveyed for: Terry Johnson

Survey address: N7453/N7459 East Lakeshore Drive

**WHITEWATER
LAKE**

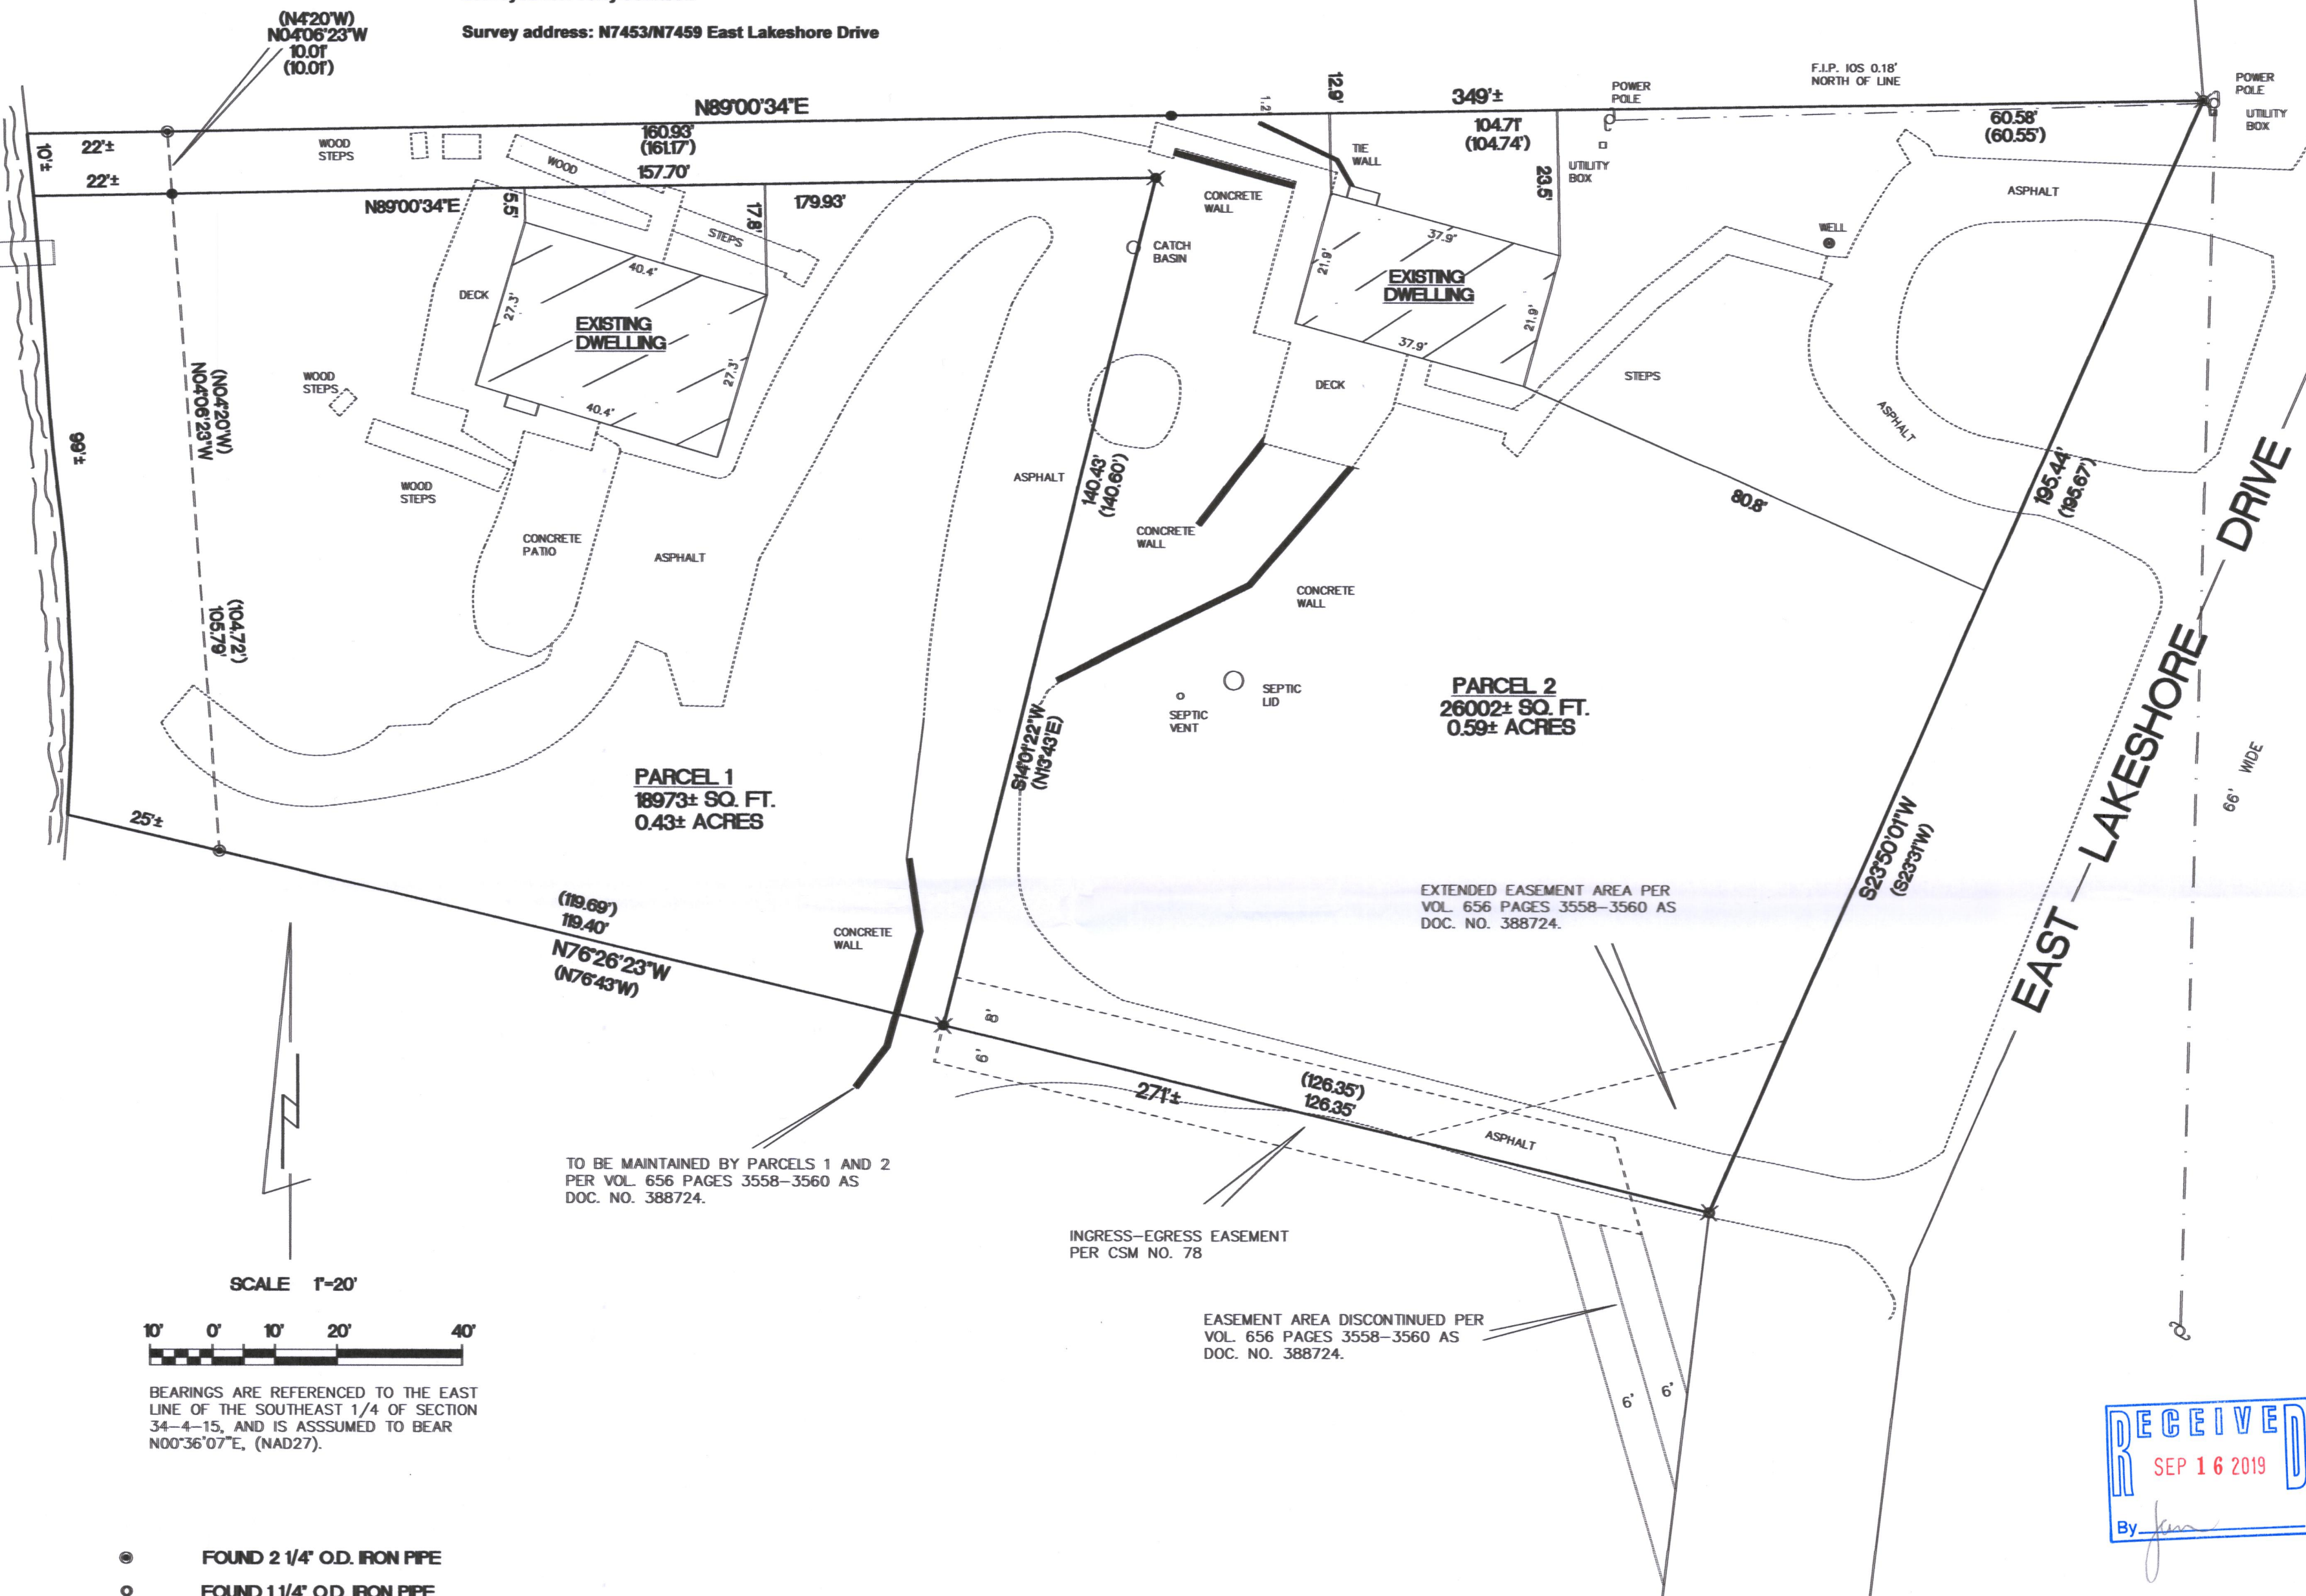


BEARINGS ARE REFERENCED TO THE EAST LINE OF THE SOUTHEAST 1/4 OF SECTION 34-4-15, AND IS ASSUMED TO BEAR N00°36'07"E, (NAD27).

- FOUND 2 1/4" O.D. IRON PIPE
- FOUND 1 1/4" O.D. IRON PIPE
- ✕ FOUND R.R. SPIKE
- ✕ FOUND SPIKE IN STUMP
- SET 1 1/4" O.D. IRON PIPE
- ✕ SET "MAG" NAIL
- () RECORDED AS DIMENSIONS

"I hereby certify that I have surveyed the above property and that the above map is a true representation thereof and shows the size and location of the property, its exterior boundaries, the location of all visible structures and dimensions of all principal buildings thereon, boundary fences, apparent easements, roadways and encroachments if any."

"This survey is made for the use of the present owners of the property, and also those who purchase, mortgage or guarantee the title thereto within one year from date hereof."

Kettle Moraine Surveying Inc.
P.O. Box 357
Eagle WI 53119
(262)594-3484
kettlemorainesurveying.com

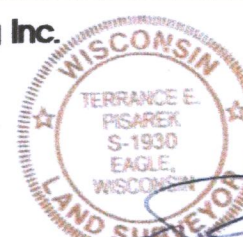

THIS IS NOT AN ORIGINAL SURVEY UNLESS THE SEAL IS RED.

8/22/19 DATE TEP FIELD WORK BY TEP DRAWN BY 19079 JOB NUMBER

LA 78-1
LA 78-2
415-1486