

LAND-MARK SURVEYING
Mark L. Miritz
Wisconsin Professional Land Surveyor S-2582


N9330 Knuteson Drive
Whitewater, WI 53190
Phone: (262) 495-3284
MARKMIRITZ@
LAND-MARKSURVEYING.COM

PLAT OF SURVEY

LOT 5, BLOCK 2 OF INDIAN TRAILS SUBDIVISION AND A PORTION OF THE VACATED KETTLE MORaine DRIVE AS FOUND IN VOLUME 657, PAGE 1123, DOCUMENT NO. 391597 OF WALWORTH COUNTY RECORDS, ALL IN THE SOUTHEAST 1/4 OF SECTION 27, TOWN 4 NORTH, RANGE 15 EAST, TOWN OF WHITEWATER, WALWORTH COUNTY, WISCONSIN.

ORDERED BY:
TOM SPEAR
N6442 DELANEY ROAD
DELAVER, WI 53115

KETTLE MORaine DRIVE
(107' WIDE)
(95' WIDE AFTER VACATION)

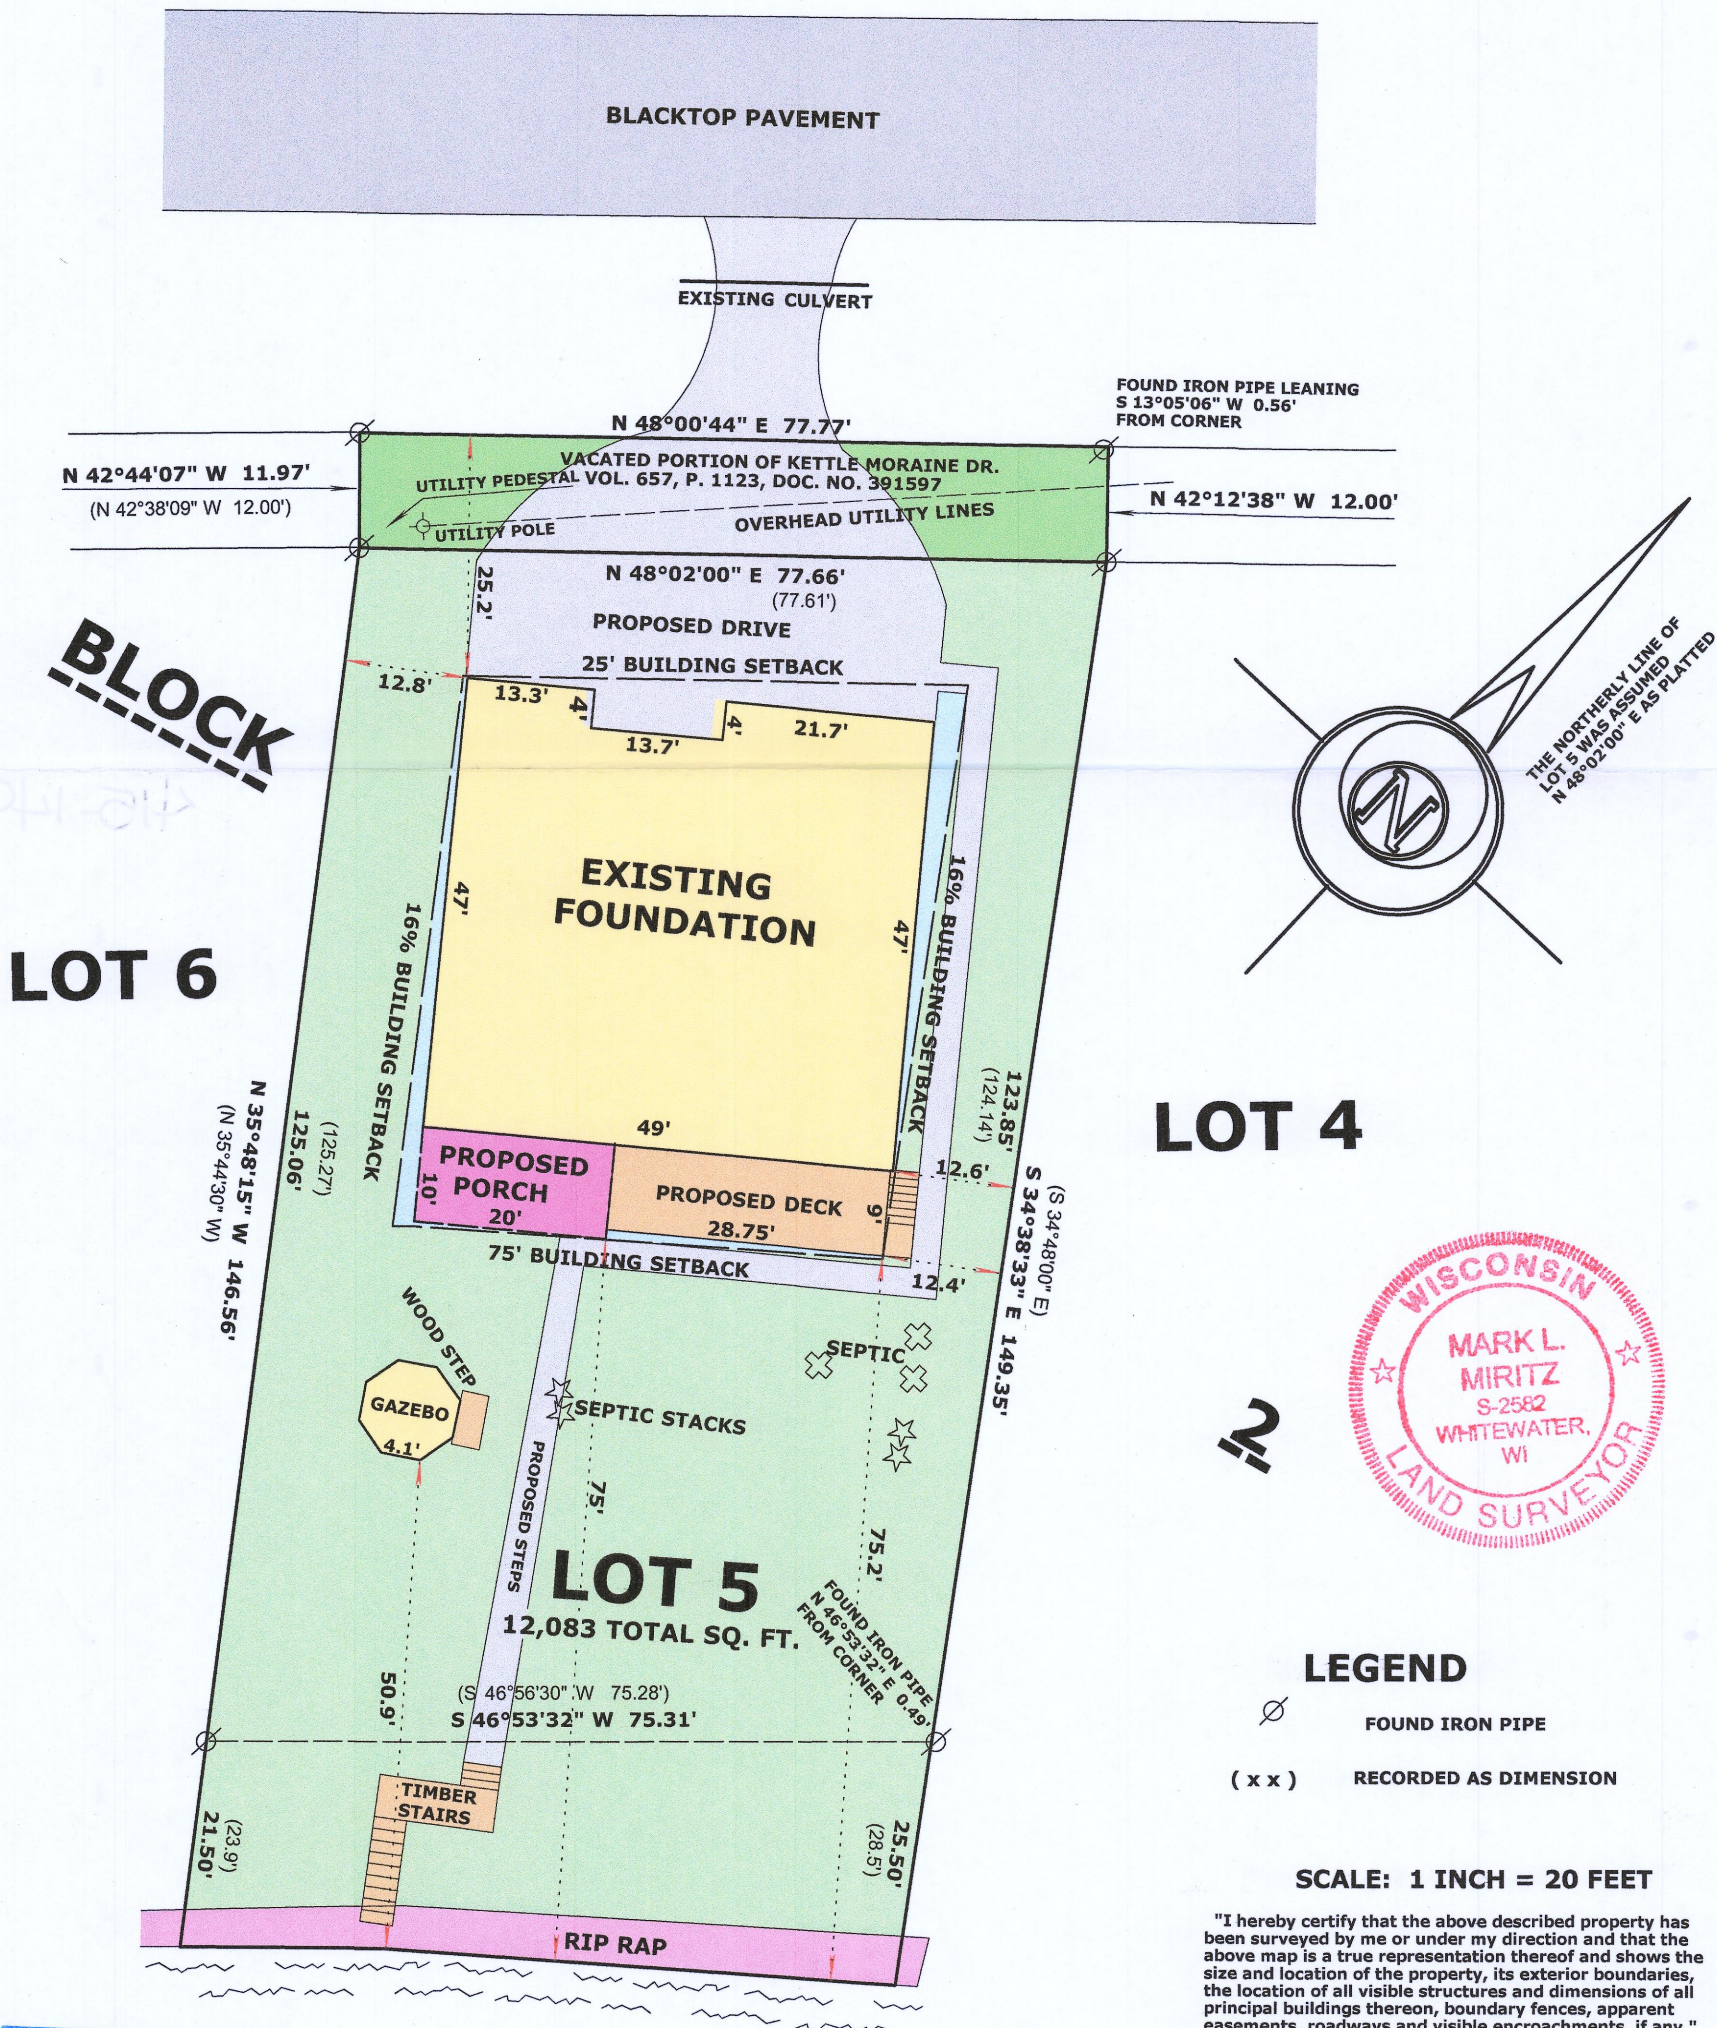

RECEIVED
JUL 15 2020
By *SMF*

RICE LAKE
LAKE ELEVATION 4/21/2017 = 865'
100 YEAR FLOOD ELEVATION = 867'
FALLS ON SIDE OF RIP RAP

REVISED OCT. 10, 2019
TO SHOW PROPOSED
RESIDENCE
REVISED MAY 2, 2020 TO
SHOW FOUNDATION "AS BUILT"

Mark L. Miritz
MARK L. MIRITZ
WISCONSIN PROFESSIONAL
LAND SURVEYOR S-2582
DATE: APRIL 23, 2017 JOB NO. 17.409

DITS-29

415-1499