
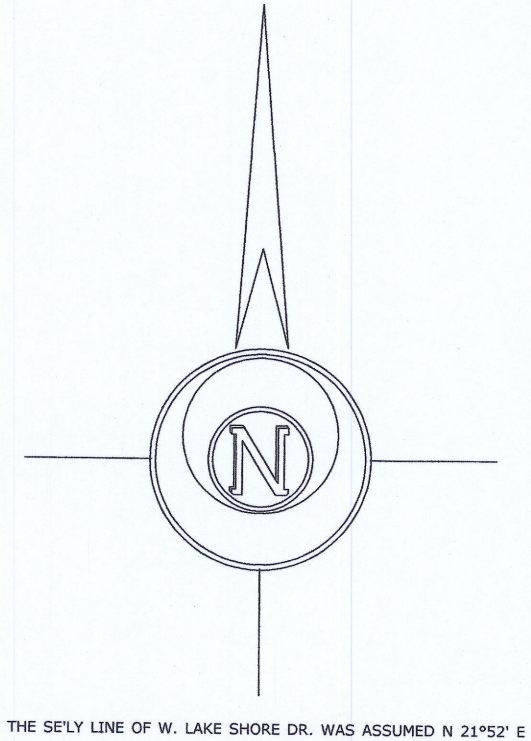


LAND-MARK SURVEYING
Mark L. Miritz
Wisconsin Registered Land Surveyor S-2582

N9330 Knuteson Drive
Whitewater, WI 53190
Phone: (262) 495-3284
FAX : (262) 495-8421
LAND-MARKSURVEYING.COM

PLAT OF SURVEY

A PARCEL OF LAND BEING LOT 13 AND PART OF LOT 14, BLOCK 1, MORaine PARK SUBDIVISION, SECTION 34, TOWN 4 NORTH, RANGE 15 EAST, WALWORTH COUNTY, WISCONSIN AND DESCRIBED AS FOLLOWS, TO-WIT: BEGINNING AT THE S.E. CORNER OF SAID LOT 13; THENCE N 70°54' W 160.77 FEET TO THE S.W. CORNER OF SAID LOT 13; THENCE N 21°52' E 119.94 FEET; THENCE S 62°29' E 160.94 FEET TO THE SHORE OF WHITEWATER LAKE; THENCE SW'LY ALONG THE SHORE OF WHITEWATER LAKE 95.6 FEET TO THE PLACE OF BEGINNING.

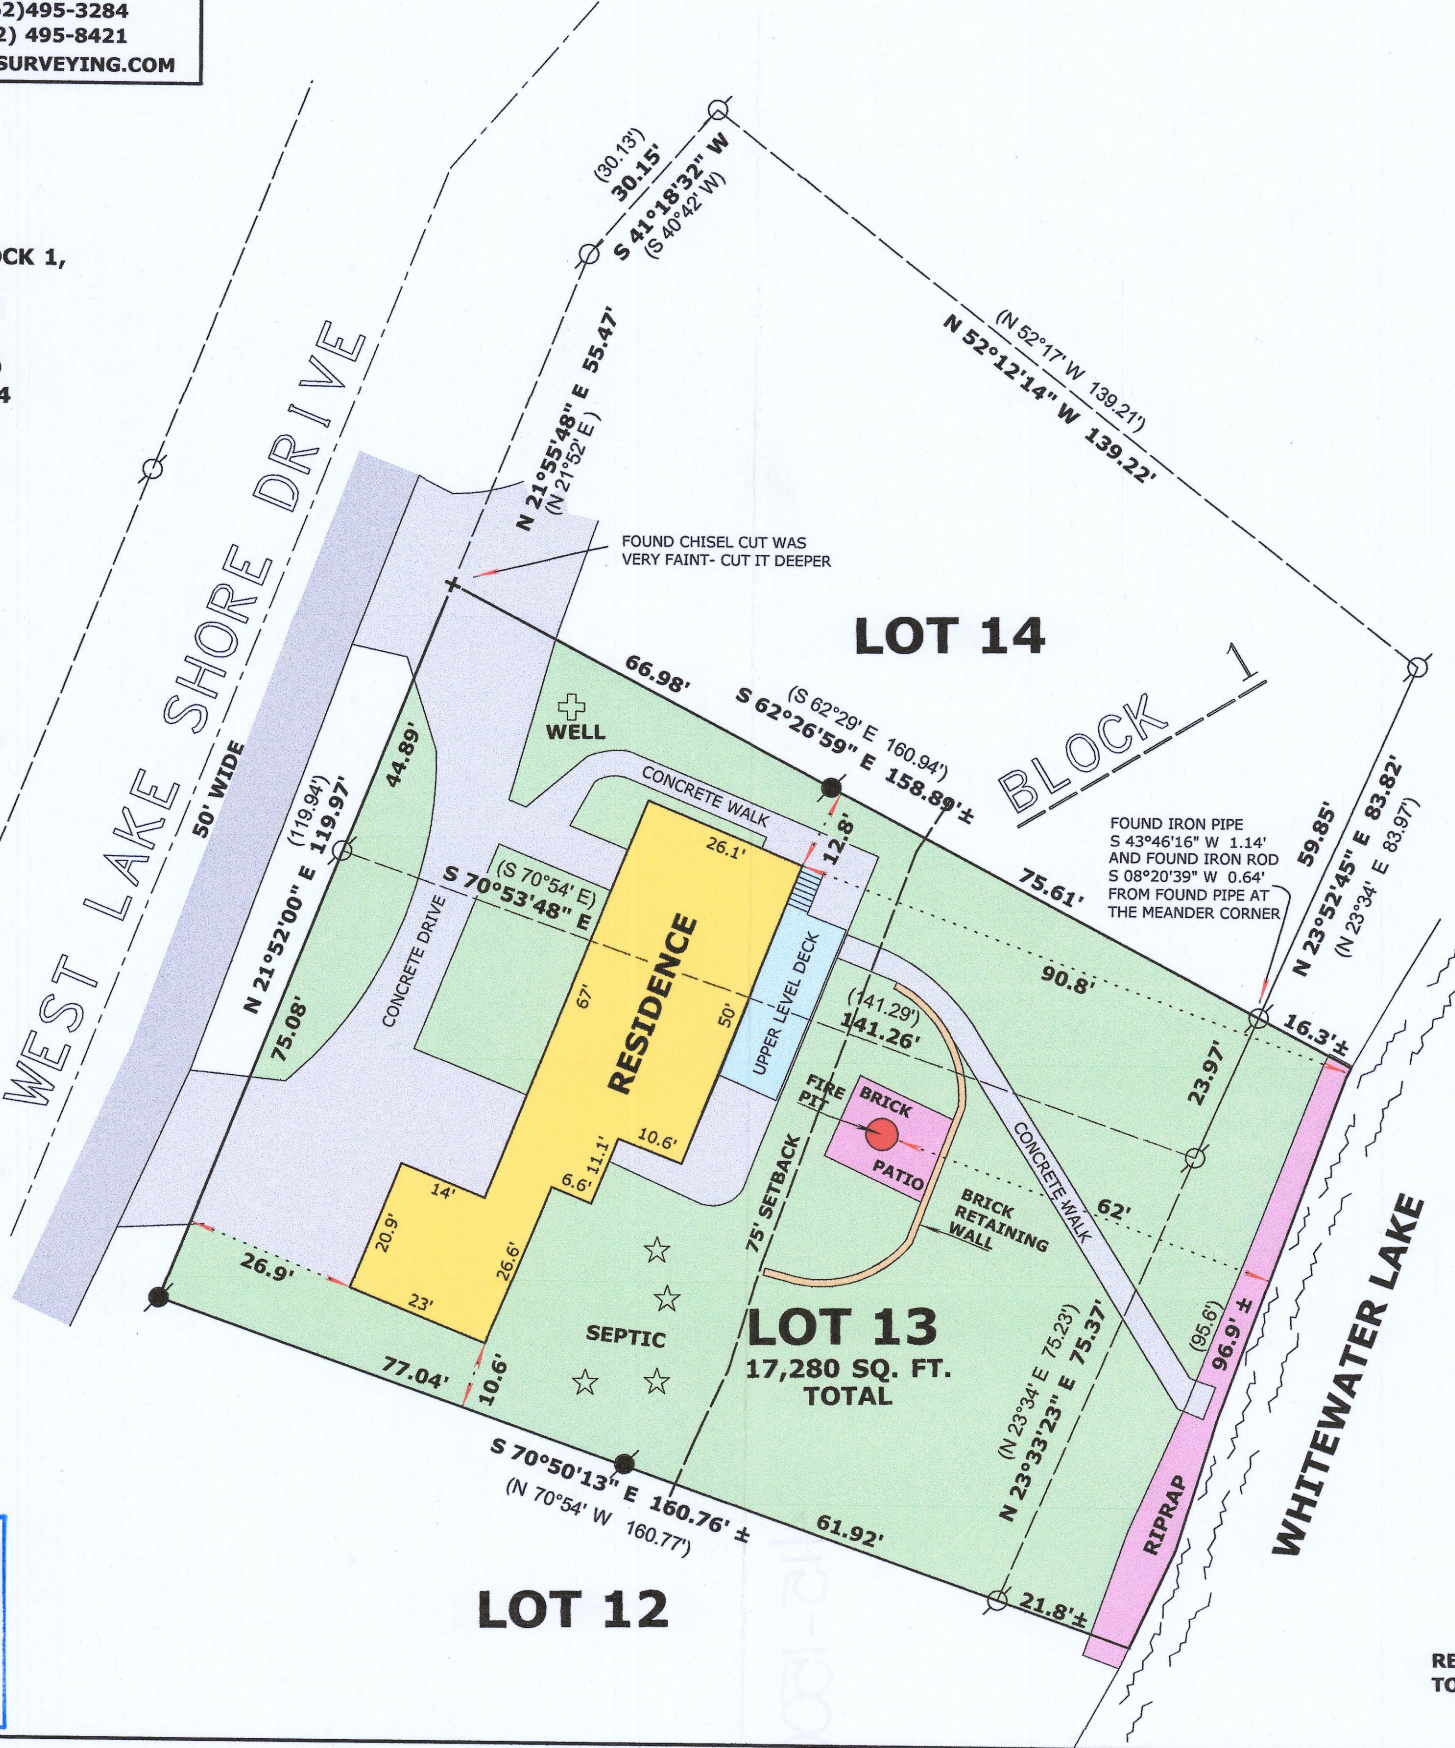

- LEGEND**
- FOUND IRON PIPE
 - FOUND IRON ROD
 - + CHISEL CUT IN CONCRETE
 - (xx) RECORDED AS DIMENSION

SCALE: 1 INCH = 30 FEET

"I hereby certify that the above described property has been surveyed by me or under my direction and that the above map is a true representation thereof and shows the size and location of the property, its exterior boundaries, the location of all visible structures and dimensions of all principal buildings thereon, boundary fences, apparent easements, roadways and visible encroachments, if any."
"This survey is made for the use of the present owners of the property, and also those who purchase, mortgage, or guarantee the title thereto within one year from date hereof."


Mark L. Miritz
MARK L. MIRITZ
WISCONSIN REGISTERED
LAND SURVEYOR S-2582

DATE: MAY 27, 2005 JOB NO. 05.516



REVISED JULY 1, 2020
TO SHOW FIRE PIT

OWNER:
DOLORES ARETOS TRUST
1749 S. EDGAR
PALATINE, IL 60067

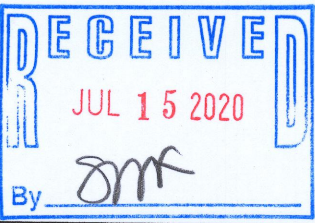

DMP-13

415-1500