
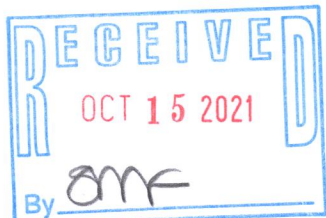


PLAT OF SURVEY

LOT 24, PINE KNOLLS SUBDIVISION, BEING A PART OF THE
NORTHEAST 1/4 OF THE NORTHEAST 1/4 OF SECTION 34,
TOWN 4 NORTH, RANGE 15 EAST, TOWN OF WHITEWATER,
WALWORTH COUNTY, WISCONSIN.

SURVEYED FOR: BRUCE/NANCY NELSON

SURVEY ADDRESS: N7654 KETTLE MORaine DRIVE

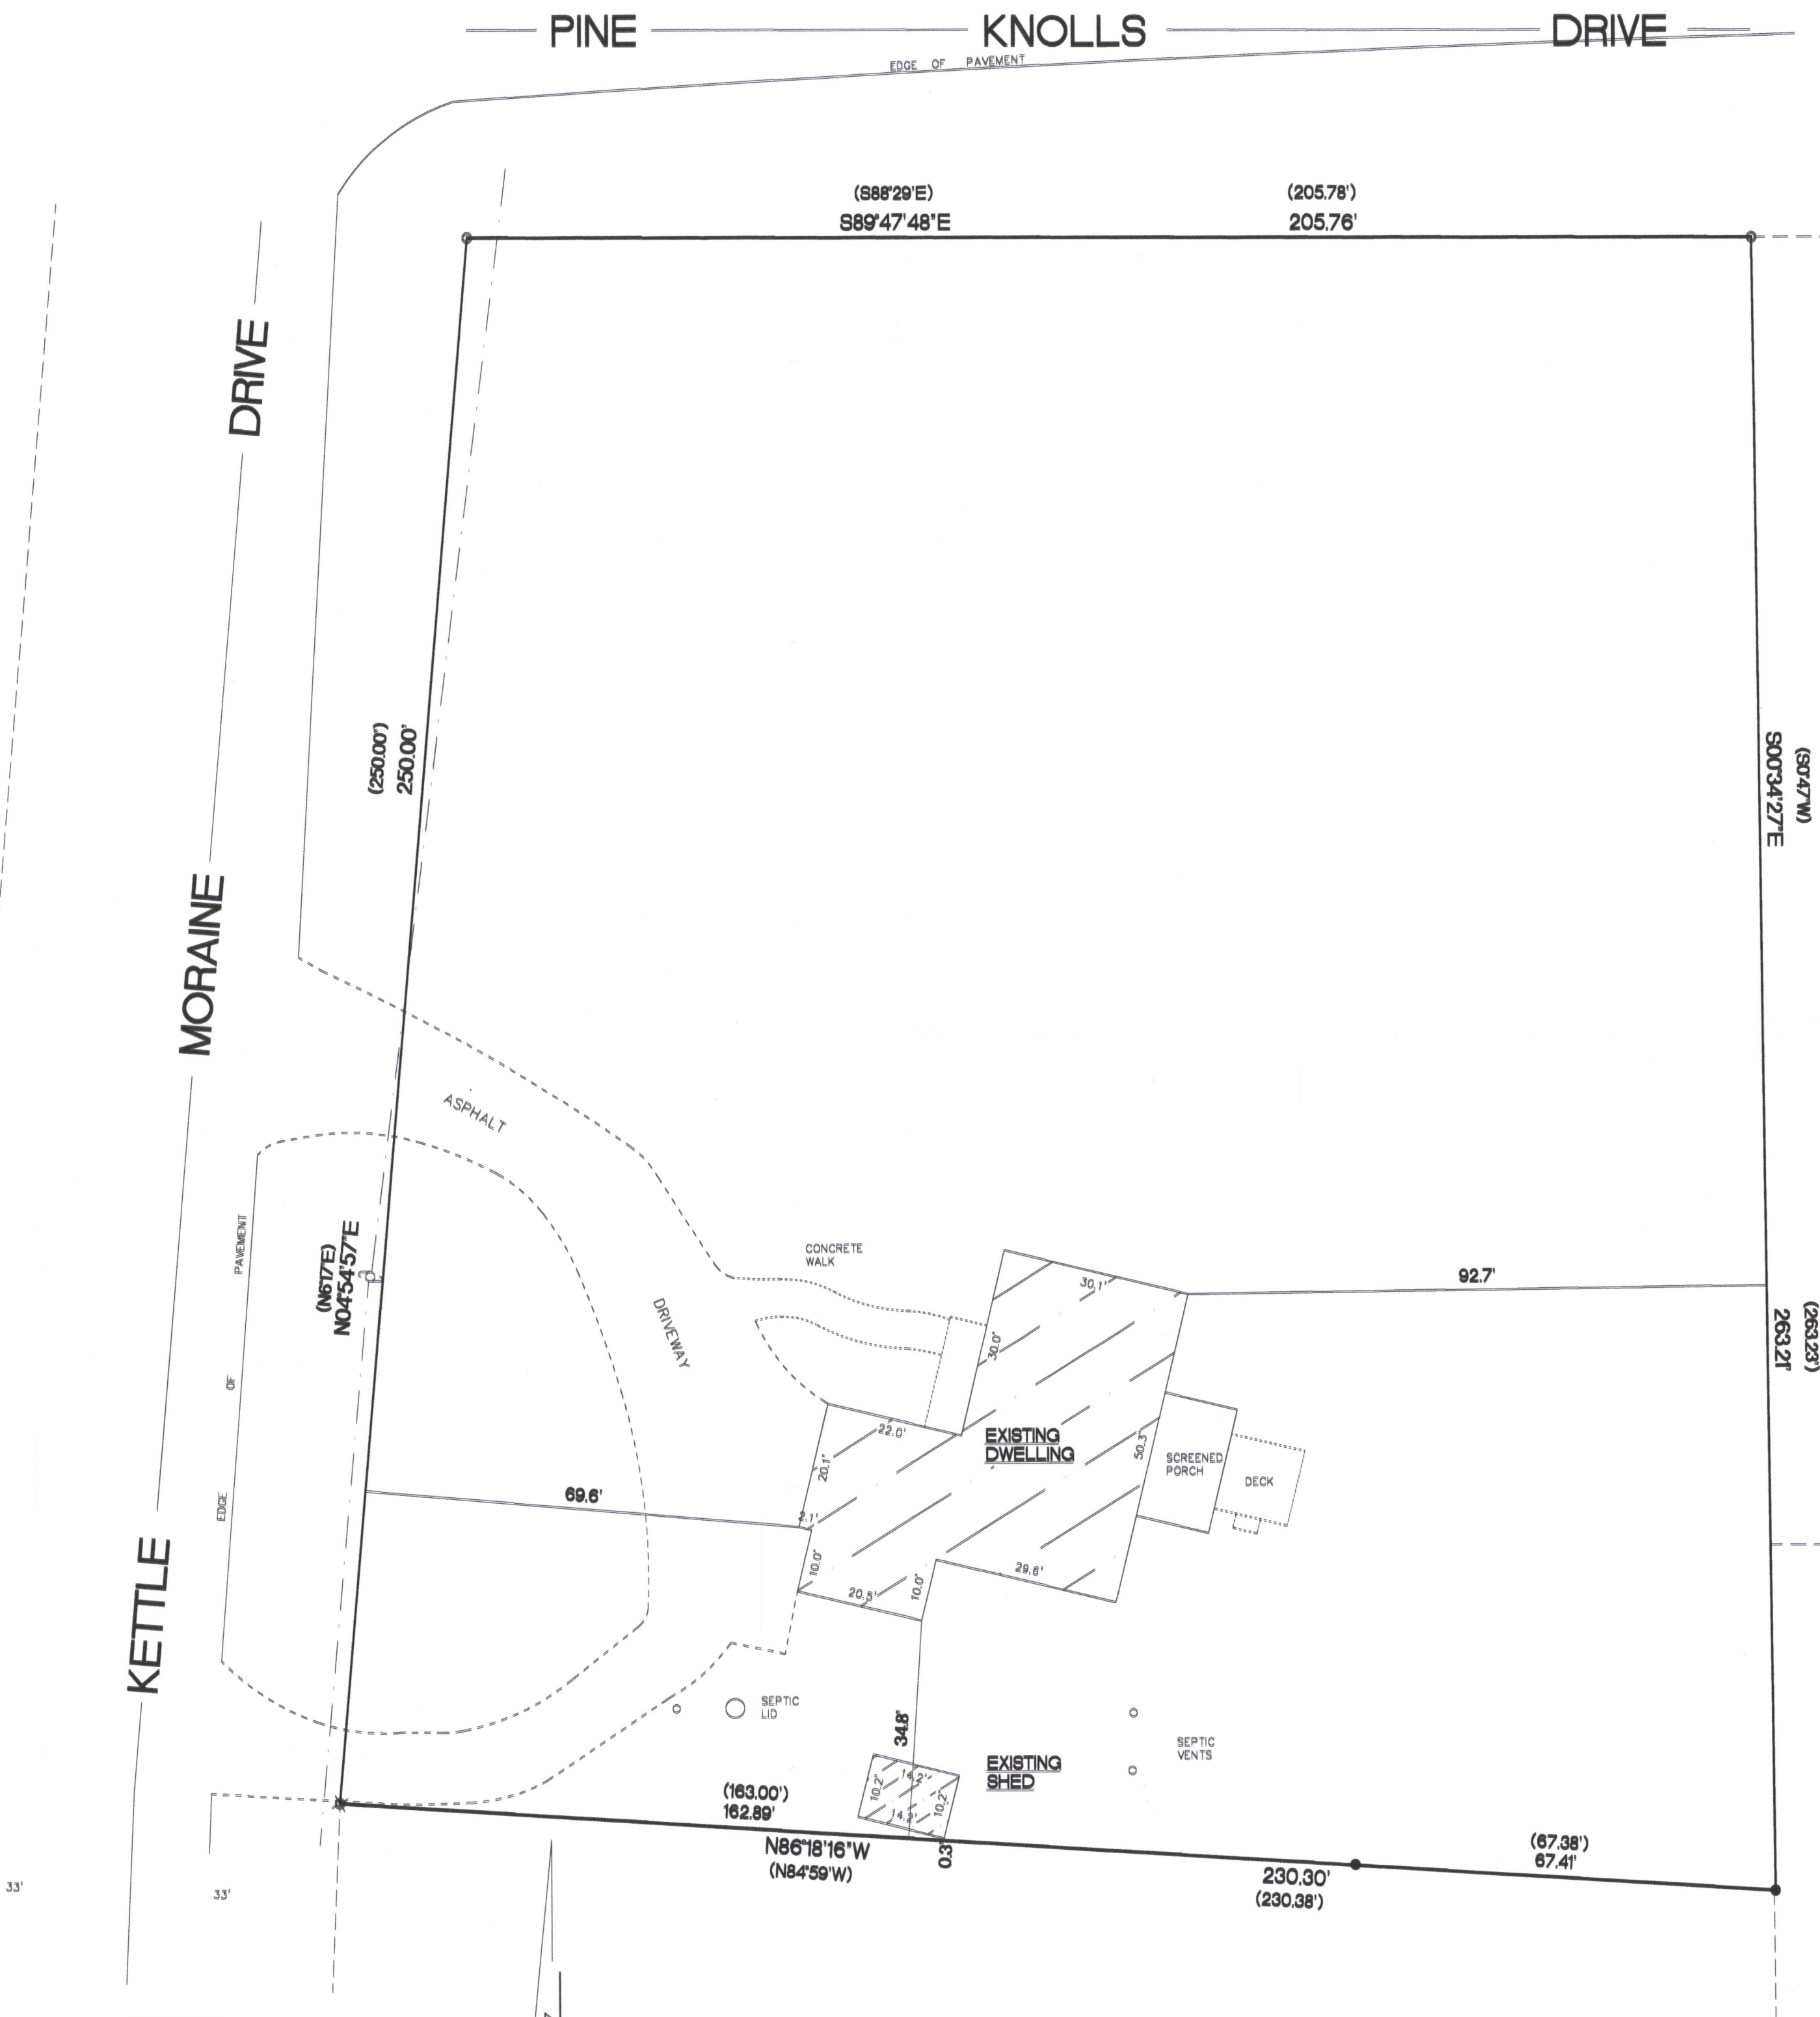

- FOUND 1 1/4" O.D. IRON PIPE
- ✕ FOUND 1" IRON ROD
- FOUND 3/4" IRON ROD
- () RECORDED AS DIMENSIONS

SCALE 1"=20'

10' 0' 10' 20' 40'

BEARINGS ARE REFERENCED TO THE EAST
LINE OF THE NORTHEAST 1/4 OF SECTION
34-4-15 AND IS ASSUMED TO BEAR
N00°20'00"E, (NAD27).

"I hereby certify that I have surveyed the above property
and that the above map is a true representation thereof
and shows the size and location of the property, its exterior
boundaries, the location of all visible structures and dimensions
of all principal buildings thereon, boundary, fences, apparent
easements, roadways and encroachments if any.

"This survey is made for the use of the present owners of
the property, and also those who purchase, mortgage or
guarantee the title thereto within one year from date hereof."

REV. 6/2/2021
6/1/2021
DATE

TEP
FIELD WORK BY

TEP
DRAWN BY

21066
JOB NUMBER

Kettle Moraine Surveying Inc.
P.O. Box 357
Eagle WI. 53119
(262)594-3484
kettlemorainesurveying.com



THIS IS NOT AN ORIGINAL SURVEY UNLESS THE SEAL IS HERE.