


PLAT OF SURVEY

- OF -

Lot 6, Block 1, Minnieska Subdivision, Town of Whitewater, County of Walworth, Wisconsin.

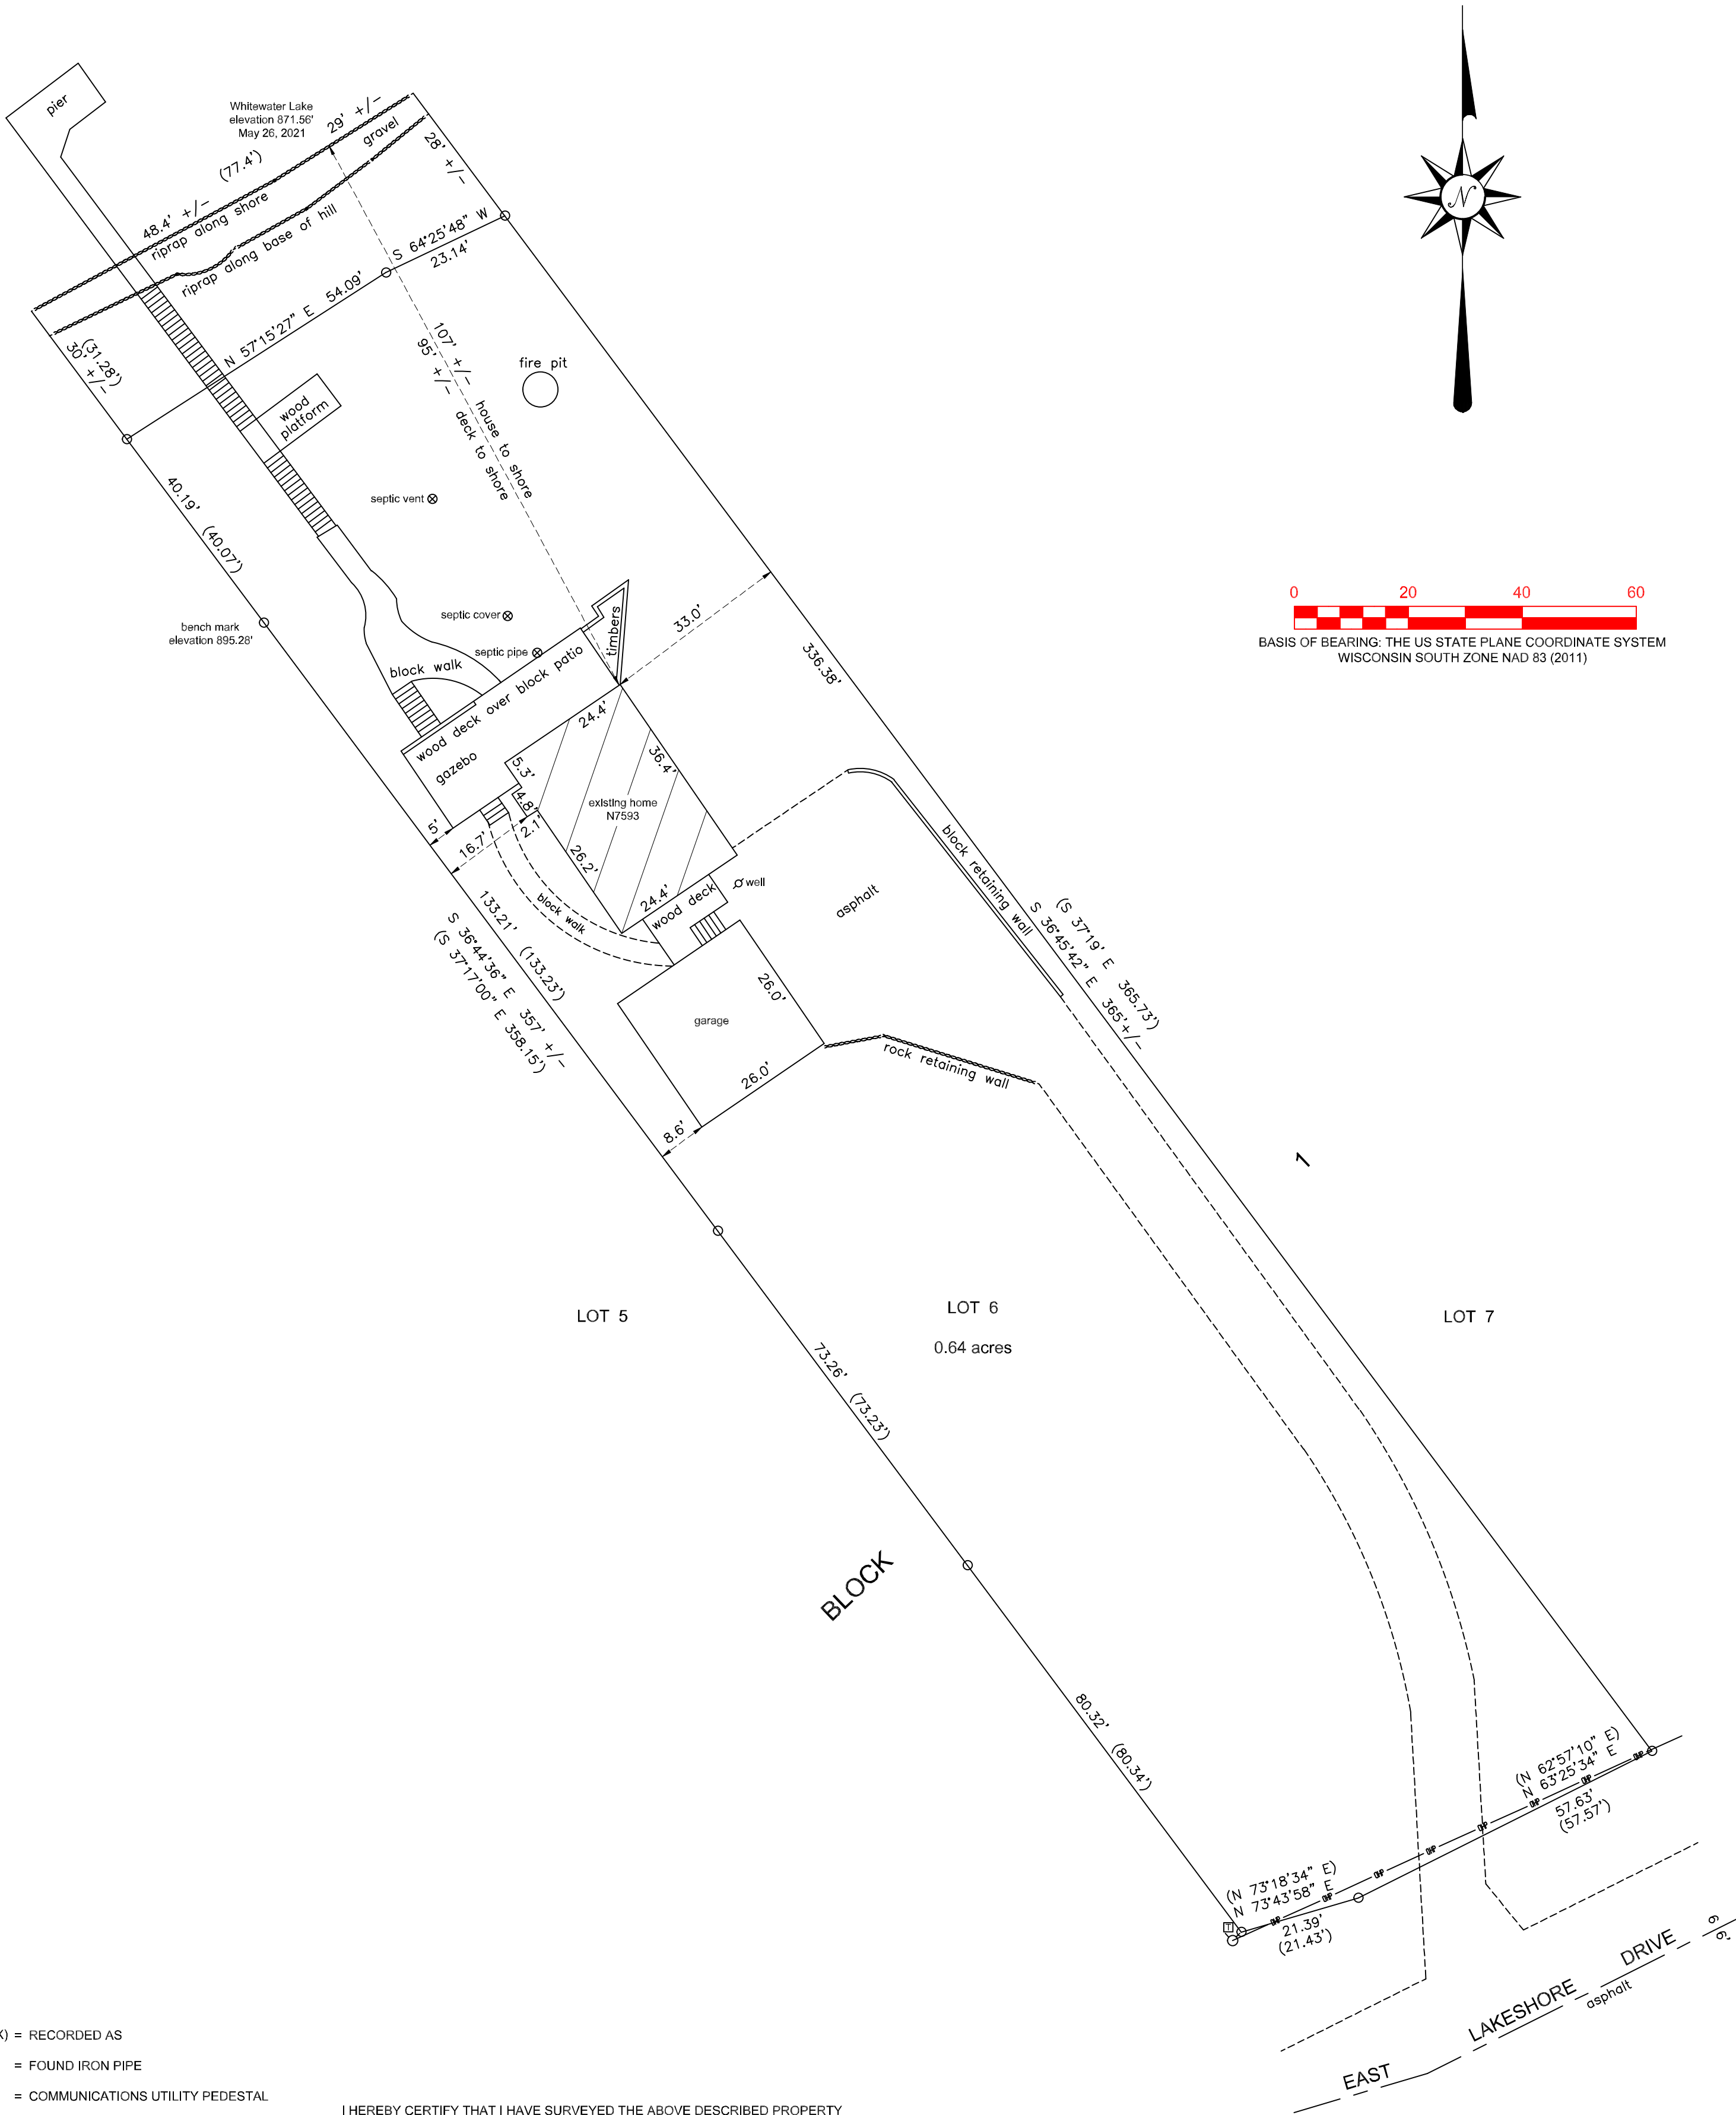

(XXX) = RECORDED AS
○ = FOUND IRON PIPE
□ = COMMUNICATIONS UTILITY PEDESTAL
⊕ = UTILITY POLE
—OP— = OVERHEAD UTILITY LINES

SCALE 1" = 20'

JOB NO. 2021-018

TAX ID # DM 00006

I HEREBY CERTIFY THAT I HAVE SURVEYED THE ABOVE DESCRIBED PROPERTY AND THE ABOVE MAP IS A TRUE REPRESENTATION THEREOF AND SHOWS THE SIZE AND LOCATION OF THE PROPERTY, ITS EXTERIOR BOUNDARIES, THE LOCATION AND DIMENSIONS OF ALL STRUCTURES THEREON, FENCES, APPARENT EASEMENTS, ROADWAYS, AND VISIBLE ENCROACHMENTS, IF ANY.

THIS SURVEY IS MADE FOR THE PRESENT OWNERS OF THE PROPERTY, AND THOSE WHO PURCHASE, MORTGAGE, OR GUARANTEE THE TITLE THERETO WITHIN ONE YEAR FROM THIS DATE HEREOF.

DATED THIS 22ND DAY OF JUNE 2021

STEVEN L SCHMIDT S - 2813
Wisconsin Professional Land Surveyor