

ASSUMED IRON
ROAD LINES AT JUMP

SCALE 1" = 20'

○ ~ IRON PIPE FOUND

✱ ~ IRON ROD FOUND


✱ ~ 60 PEN. SPIKE
FOUND

● ~ IRON ROD SET
3 1/2" DIA. X 24"

OWNER: G. L. JOHNSON
SURVEYED FOR:
H. KINSON
RR3 WHITEWATER,
WIS.

LAND DEDICATED TO THE PUBLIC
FOR USE AS PARK & ROAD

NOTE: ROAD BUILT & USED AS TWO WAY ROAD
& OF PLATED 30 FT WIDE. ONE WAY. E.D.B.E. ROAD.

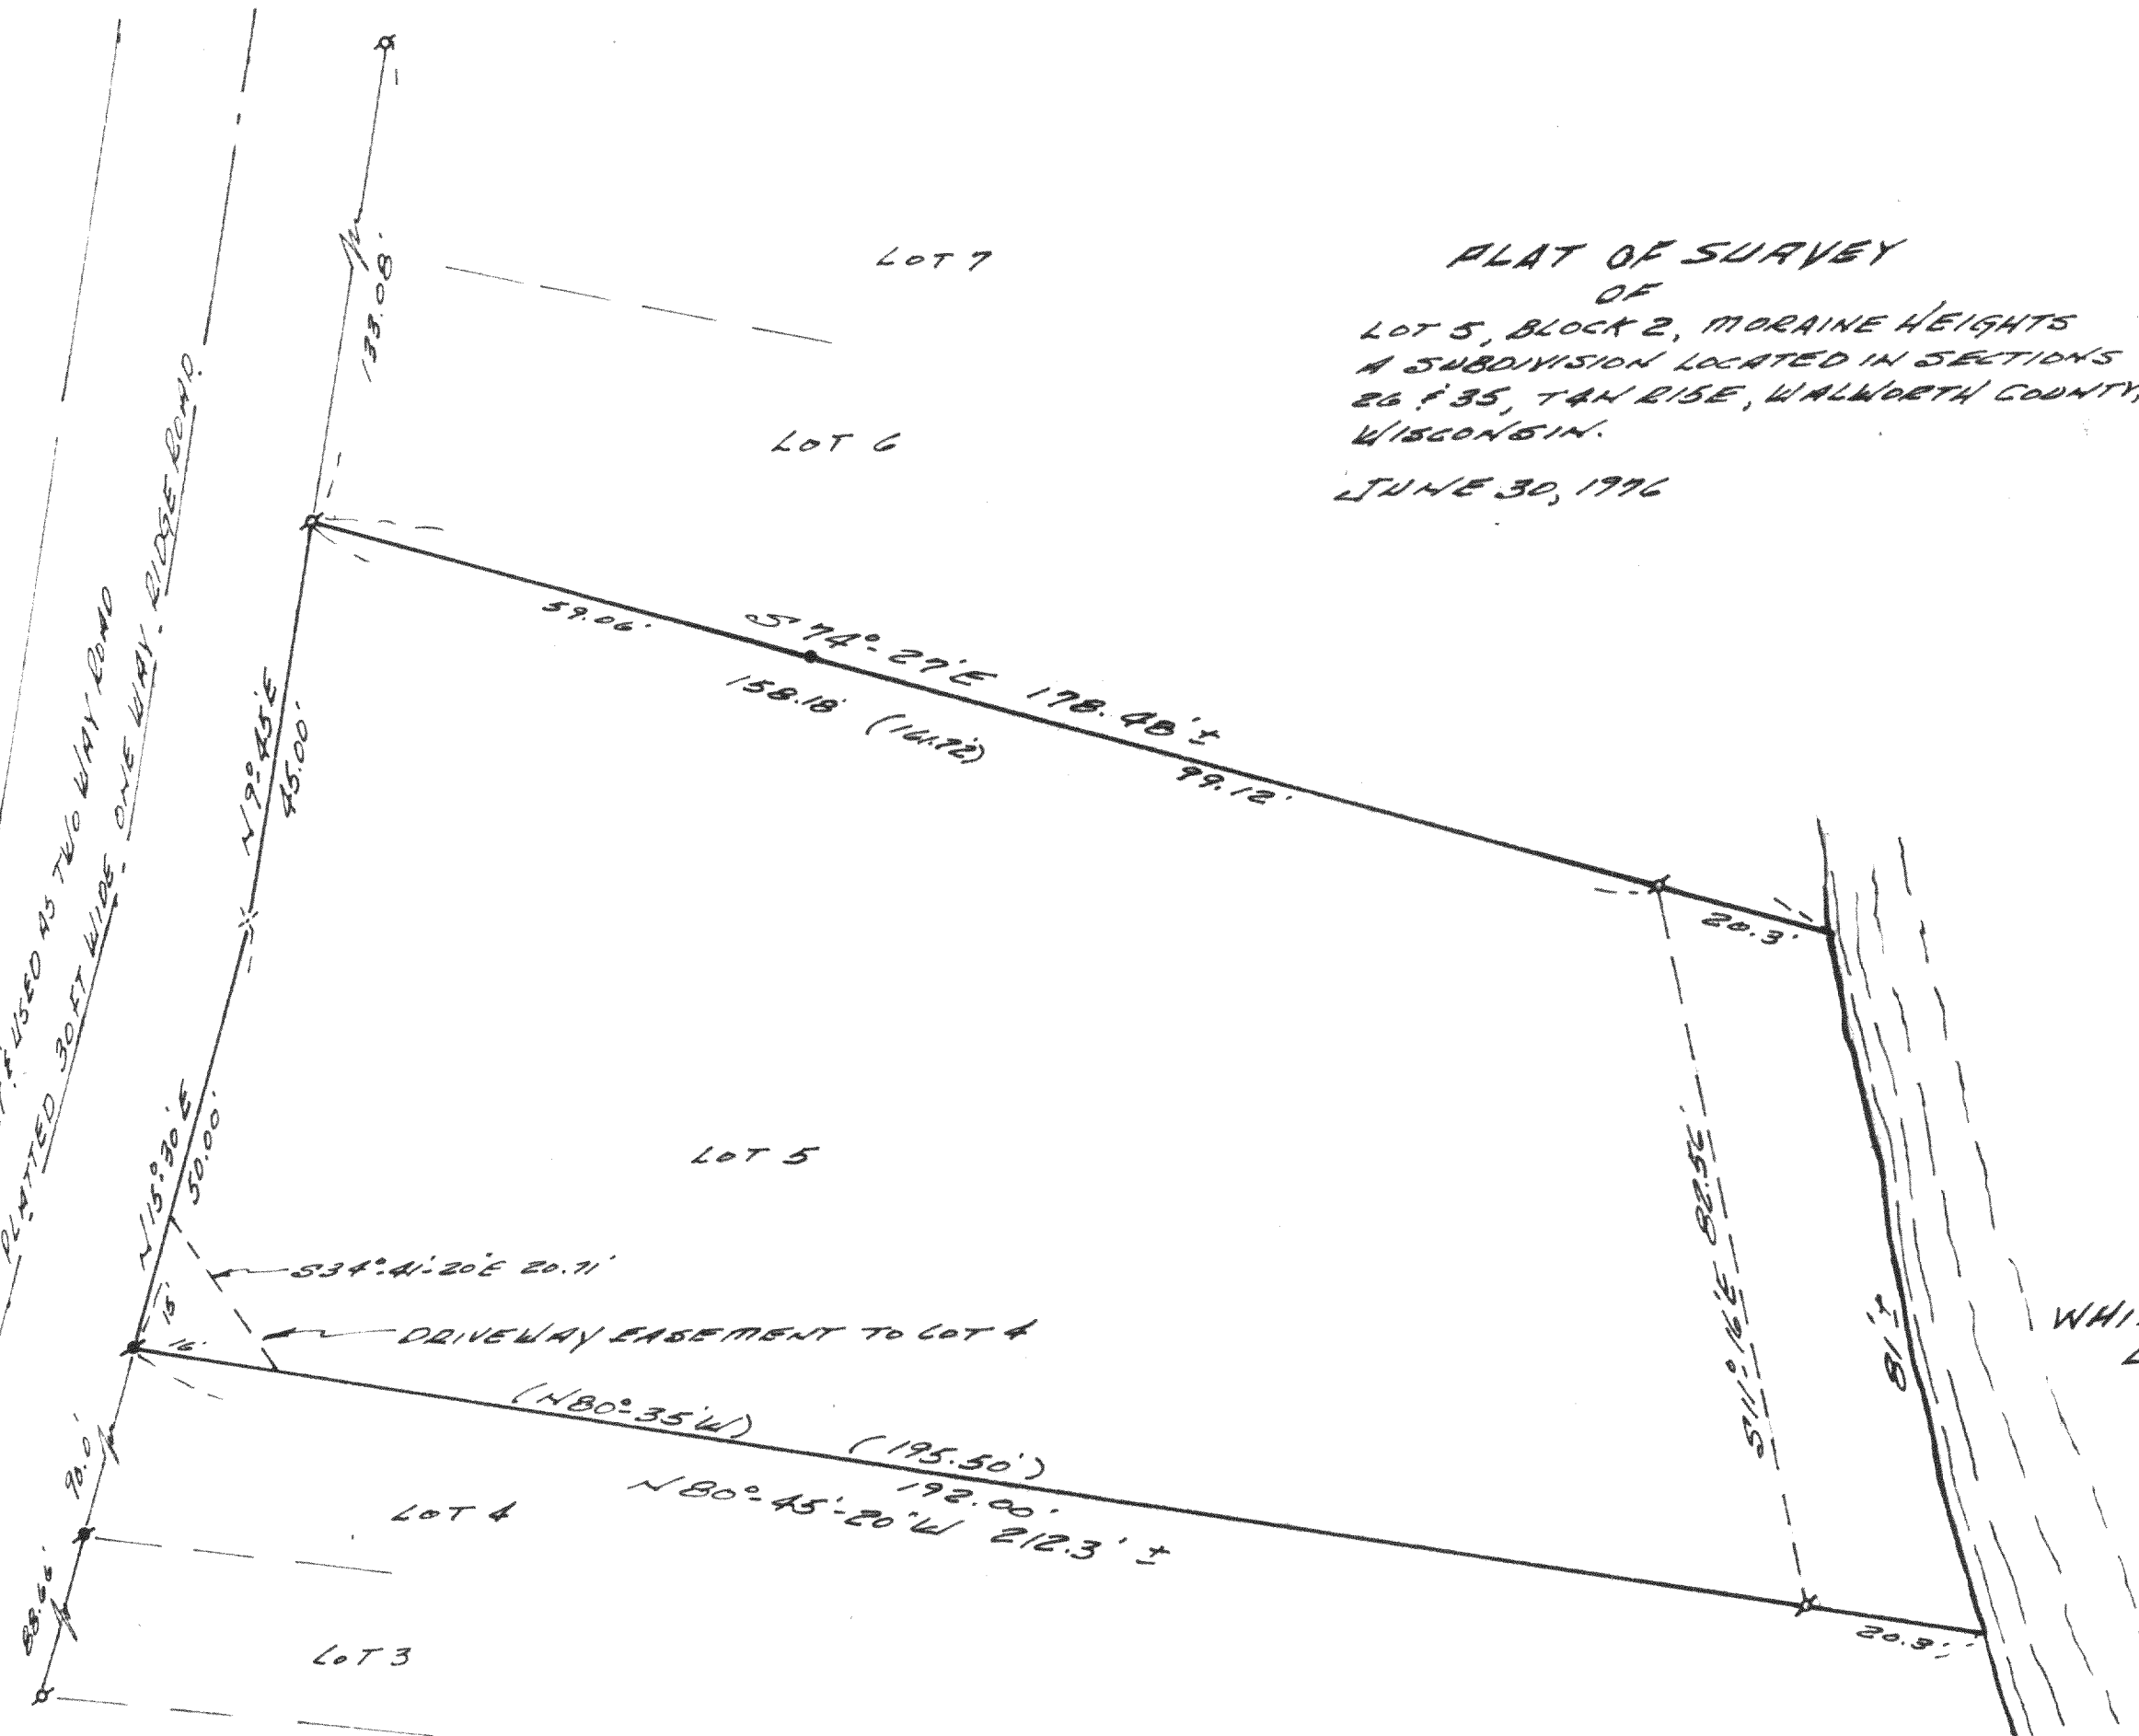

PLAT OF SURVEY

OF
LOT 5, BLOCK 2, MORaine HEIGHTS
A SUBDIVISION LOCATED IN SECTIONS
26 & 35, T4N R1E, WALWORTH COUNTY,
WISCONSIN.

JUNE 30, 1976

DESCRIPTION OF DRIVEWAY EASEMENT
DRIVEWAY EASEMENT OVER PART OF
LOT 5, TO LOT 4, DESCRIBED AS
FOLLOWS: BEGIN AT THE SOUTHWEST
CORNER OF LOT 5, THENCE $N 15^{\circ} 30' E$
15.00 FEET; THENCE $S 34^{\circ} 41' 20'' E$
20.71 FEET TO THE SOUTHERLY LOT
LINE OF SAID LOT 5, THENCE $N 80^{\circ} 45' 20'' W$
ALONG SAID SOUTHERLY LOT LINE, 16.00
FEET TO THE POINT OF BEGINNING.

I HAVE SURVEYED THE ABOVE DESCRIBED
PROPERTY & THE ABOVE MAP IS A TRUE
REPRESENTATION THEREOF & SHOWS
THE SIZE & LOCATION OF THE
PROPERTY, ITS EXTERIOR BOUNDARIES,
APPARENT EASEMENTS & ROADWAYS
& VISIBLE ENCROACHMENTS, IF ANY,
TO THE BEST OF MY KNOWLEDGE &
BELIEF.

Thomas P. A. Jensen
THOMAS P. A. JENSEN R.L.S. #1084

