

PLAT OF SURVEY

LOT 3, BLOCK 2, MORaine HEIGHTS, TOWN OF WHITEWATER,
WALWORTH COUNTY, WISCONSIN.



STATE OF WISCONSIN
COUNTY OF ROCK SS.

I HEREBY CERTIFY THAT I HAVE SUPERVISED THE SURVEY OF THE PROPERTY DESCRIBED HEREON FOR THE EXCLUSIVE USE OF PRO LANDSCAPE SUPPLY AND THAT TO THE BEST OF MY KNOWLEDGE AND BELIEF THE PLAT HEREON DRAWN CORRECTLY REPRESENTS SAID SURVEY AND ITS LOCATION AND COMPLIES WITH CHAPTER A-E7.

GIVEN UNDER MY HAND AND SEAL THIS 26th DAY OF JULY, 2022, AT JANESVILLE, WISCONSIN.

JEFFREY R. GARDE, PLS NO. 2766

If the surveyor's signature is not red in color, the map is a copy and may contain unauthorized alterations. The certification contained hereon shall not apply to any copies.

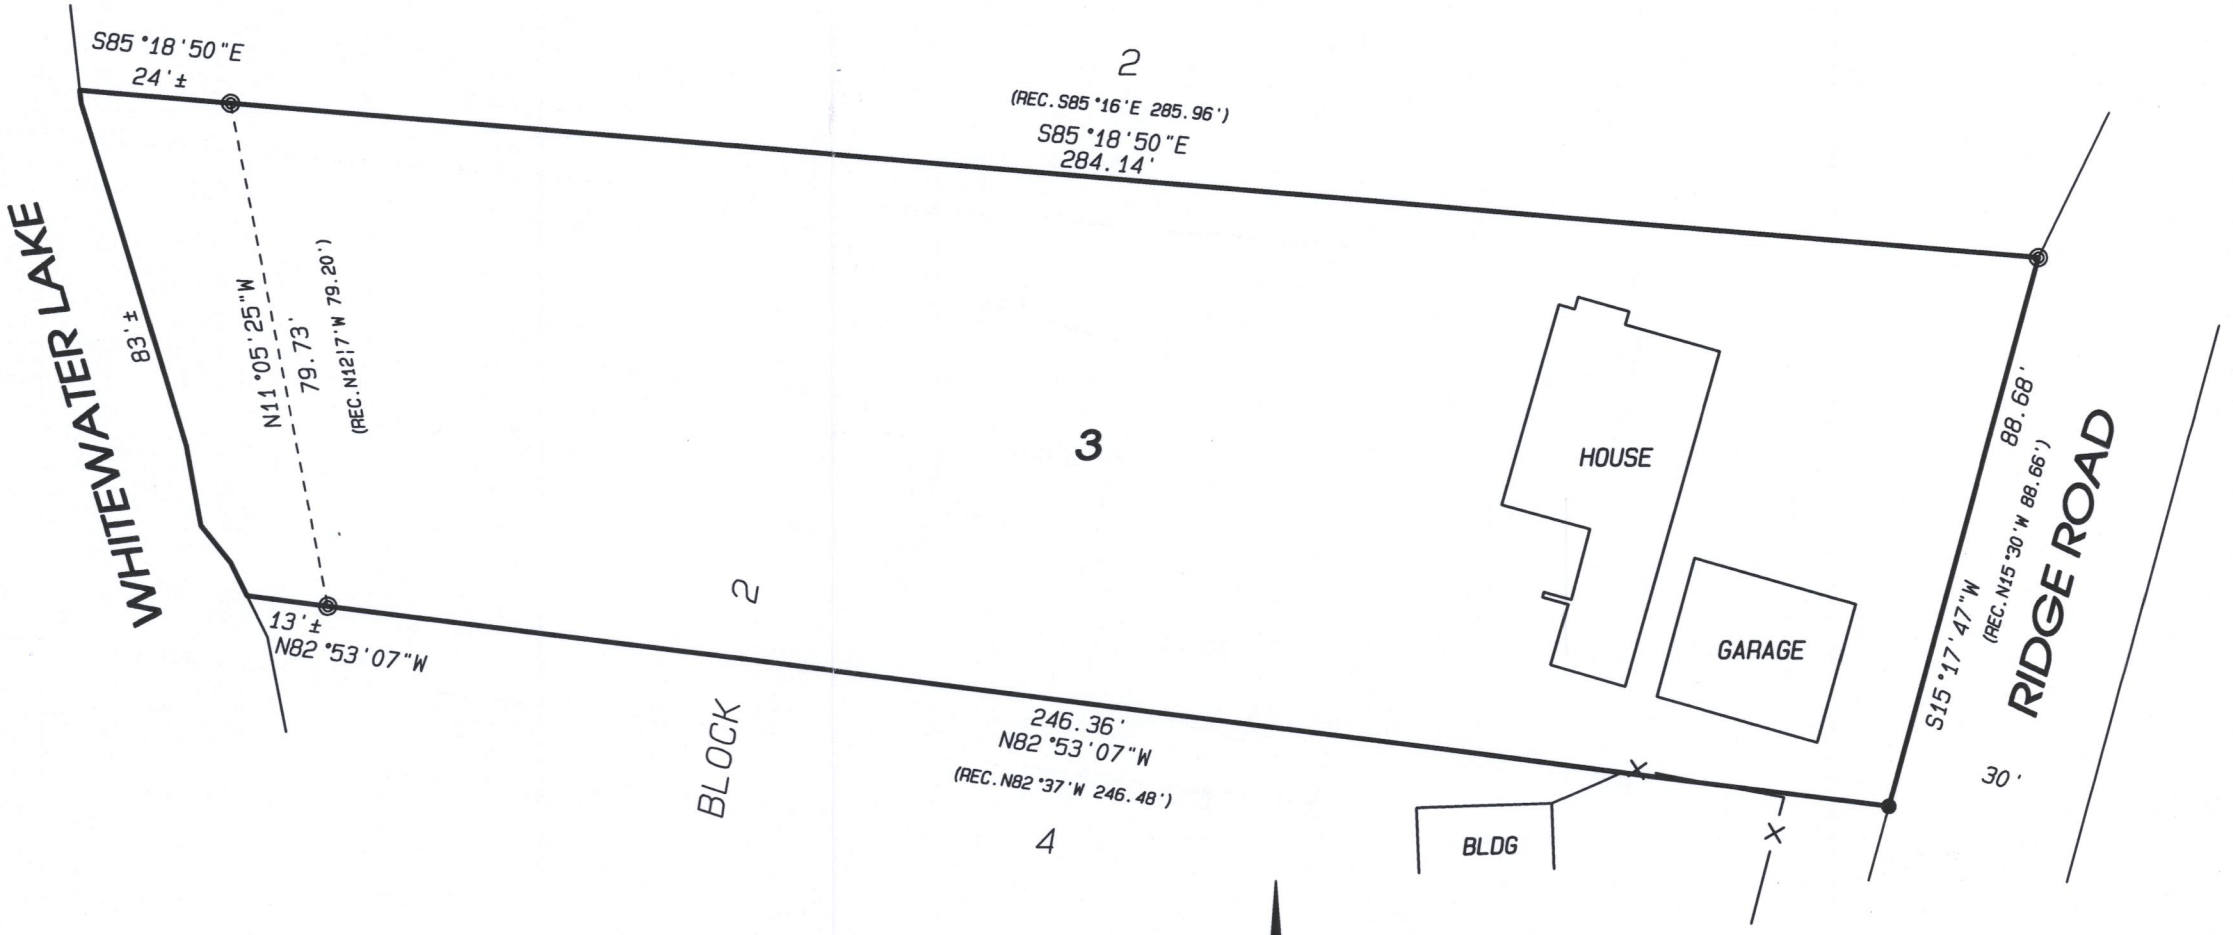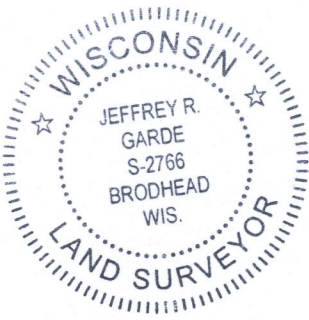

NOTES:

FIELD WORK COMPLETED JULY 25, 2022.


SURVEYS BY DAVID ABELL DATED JANUARY 17, 1996 AND JUNE 25, 1996 WERE USED IN RETRACING THE BOUNDARIES FOR THIS SURVEY.

THIS SURVEY IS SUBJECT TO ANY AND ALL EASEMENTS AND AGREEMENTS, RECORDED AND UNRECORDED.

ASSUMED S85°18'50"E ALONG THE NORTH LINE OF SAID LOT 3.

LEGEND:

- FOUND 3/4" IRON PIN
- ⊙ FOUND 1" IRON PIPE
- x-x- FENCE

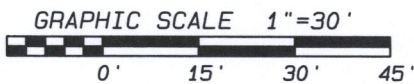

Project No. 122 - 309 For: PRO LANDSCAPE



109 W. Milwaukee St.
Janesville, WI 53548
www.combsurvey.com
tel: 608 752-0575
fax: 608 752-0534

- LAND SURVEYING
- LAND PLANNING
- CIVIL ENGINEERING

415-1590

DMH-37