

LAND-MARK SURVEYING

Mark L. Miritz
Wisconsin Professional Land Surveyor S-2582



N9330 Knuteson Drive
Whitewater, WI 53190
Phone: (262) 949-1239
MARKMIRITZ@
LAND-MARKSURVEYING.COM

PLAT OF SURVEY

**LOT 2 AND LOT 3, BLOCK 1, INDIAN TRAIL SUBDIVISION,
LOCATED IN PART OF THE SOUTHEAST 1/4 OF SECTION 27,
TOWN 4 NORTH, RANGE 15 EAST, TOWN OF WHITEWATER,
WALWORTH COUNTY, WISCONSIN.**

**OWNERS:
THOMAS S. SPEAR
ANN M. SPEAR
N6442 DELANEY ROAD
DELAVER, WI 53115**

**UNIMPROVED
HENRY STREET
(66' WIDE)**

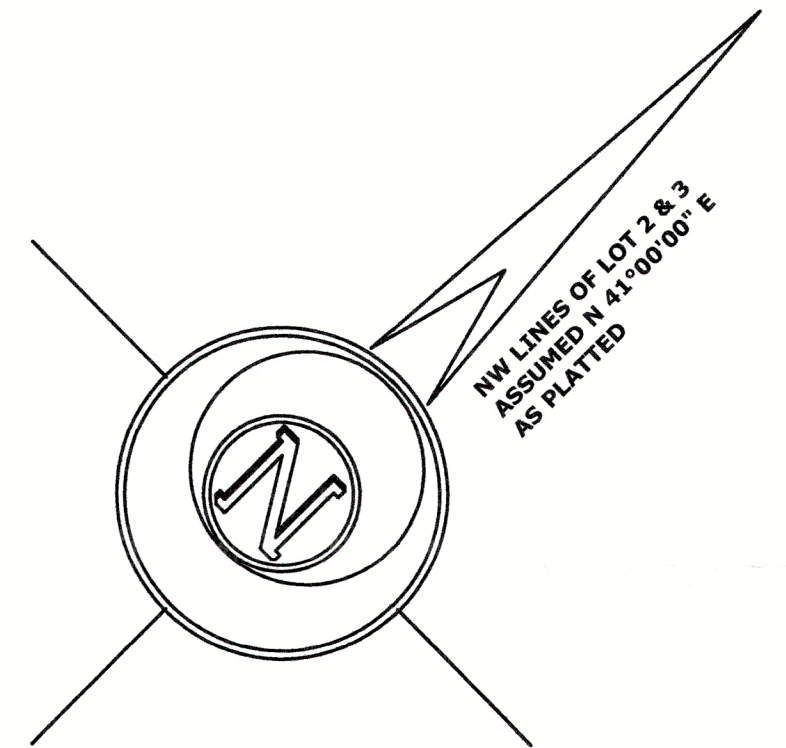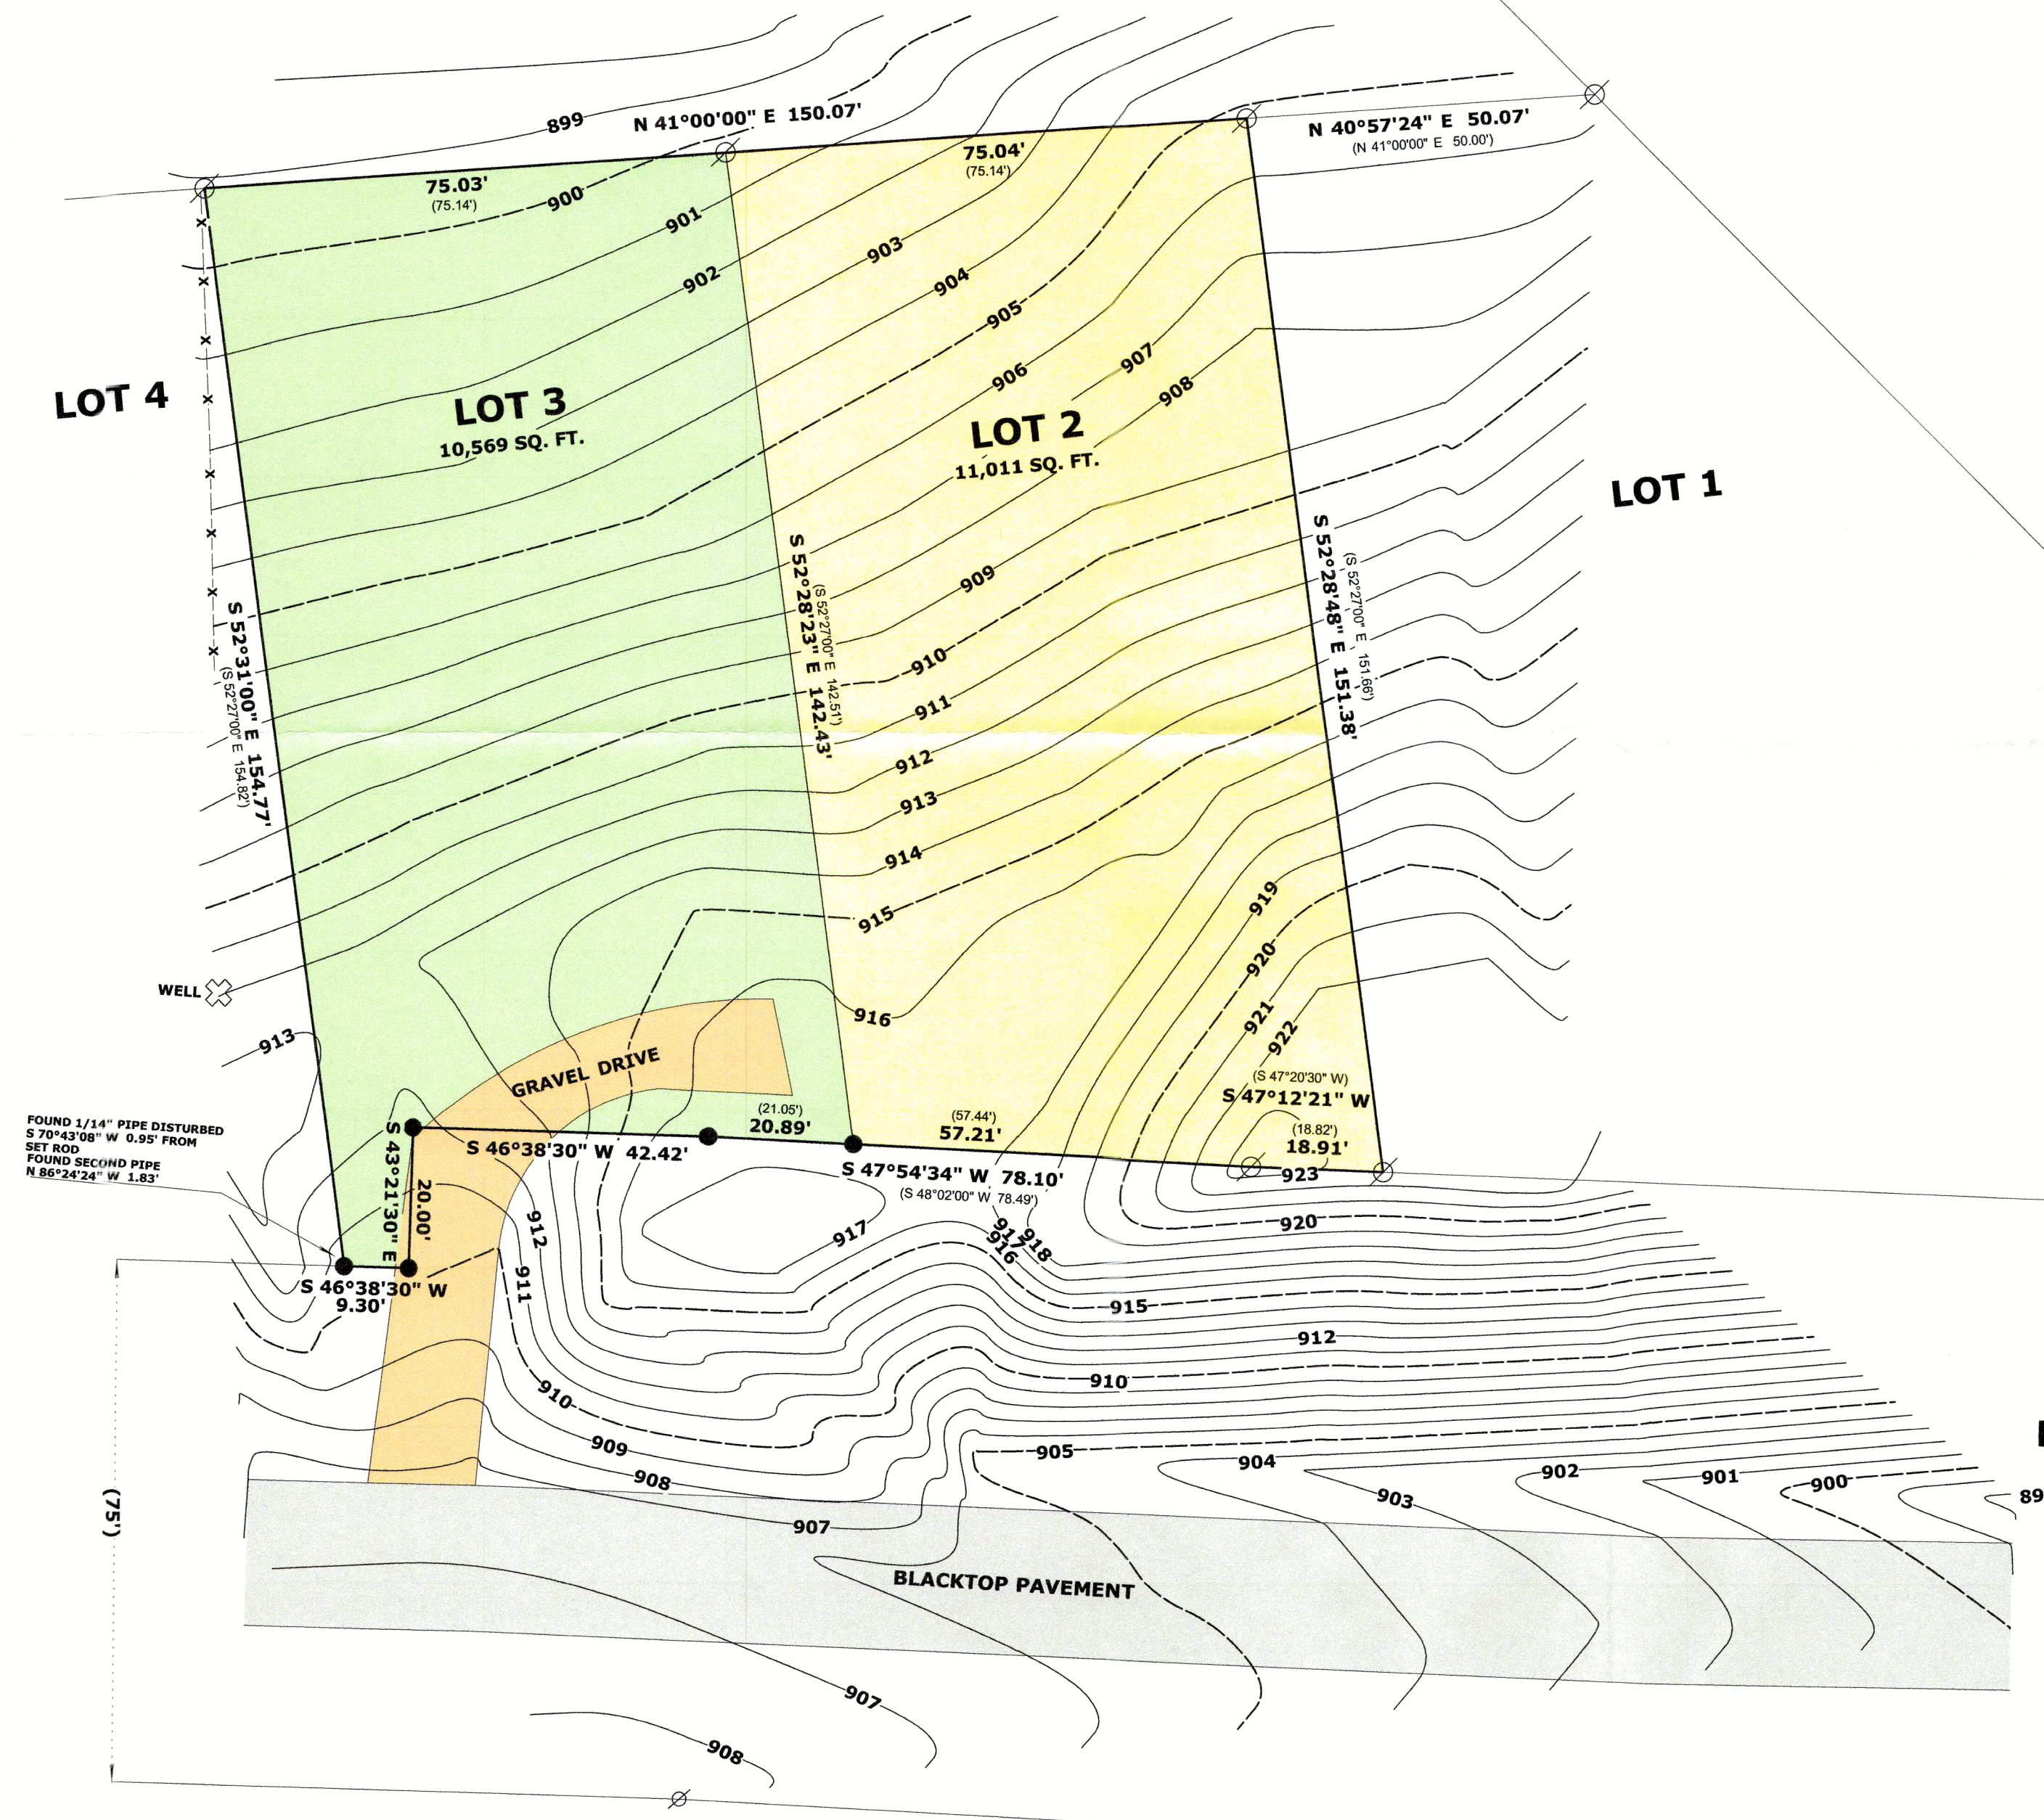

LEGEND

- FOUND IRON PIPE 1 1/2"
- SET IRON ROD, 18" LONG, WEIGHING 1.5 LBS./LINEAL FT., 3/4" DIA.
- RECORDED AS DIMENSION
- EXISTING FENCE

SCALE: 1 INCH= 20 FEET

"I hereby certify that the above described property has been surveyed by me or under my direction and that the above map is a true representation thereof and shows the size and location of the property, its exterior boundaries, the location of all visible structures and dimensions of all principal buildings thereon, boundary fences, apparent easements, roadways and visible encroachments, if any." "This survey is made for the use of the present owners of the property, and also those who purchase, mortgage, or guarantee the title thereto within one year from date hereof."

Mark L. Miritz
MARK L. MIRITZ
WISCONSIN PROFESSIONAL
LAND SURVEYOR S-2582

DATE: MAY 5, 2023 JOB NO. 18.314

DTS-2 DTS-3

415-1602