



HAROLD H. KOLB
REGISTERED PROFESSIONAL LAND SURVEYOR
LAKE GENEVA, WISCONSIN

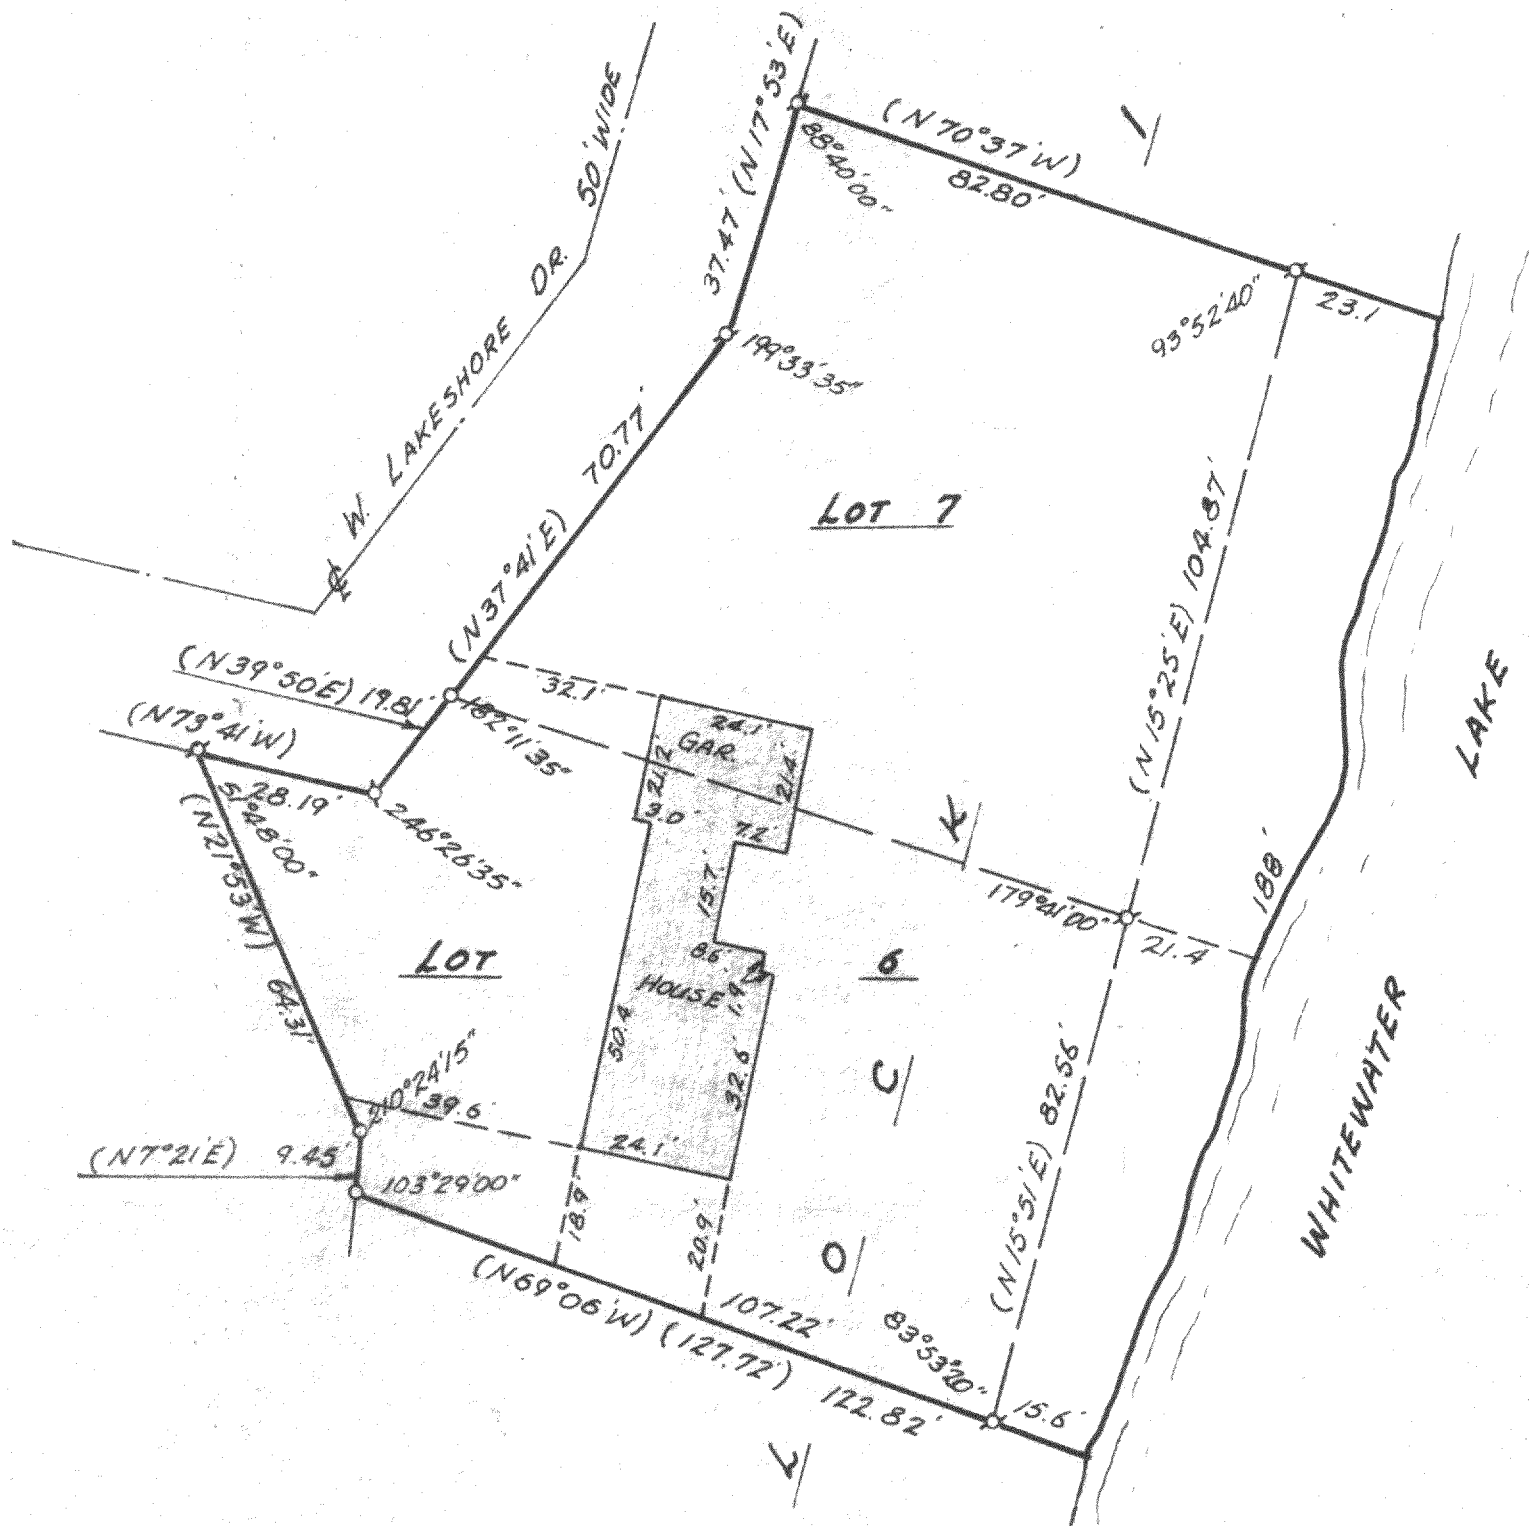


PLAT OF SURVEY OF
Lots 6 and 7, Block 1, Meraine Park,
T4N, R15E, Walworth County, Wisconsin.

ACCURACY - Distances $\pm .01'$
Angles $\pm 05''$
Error of closure less than
1 part in 3000

Ordered by: Steck Realty
Whitewater, Wisconsin

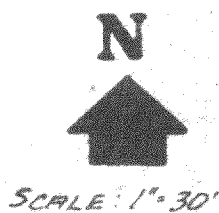

- LEGEND**
- φ - IRON PIPE FOUND
 - - IRON PIPE PLACED
 - - CONCRETE MONUMENT
 - x - SPIKE
 - () - RECORDED AS

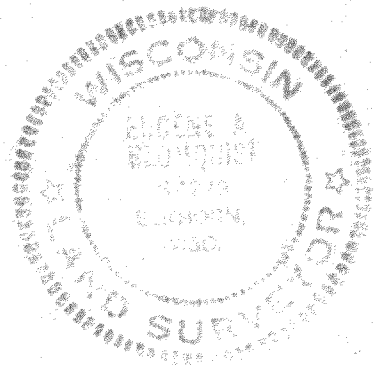

I, Eugene A. Bloomquist, DO HEREBY CERTIFY THAT I HAVE
SURVEYED THE PROPERTY HEREON DESCRIBED ACCORDING
TO THE OFFICIAL RECORDS, AND THAT THE PLAT HEREON
IS A CORRECT REPRESENTATION OF THE LOT LINES

Eugene A. Bloomquist
EUGENE A. BLOOMQUIST
WISCONSIN REGISTERED LAND SURVEYOR, S-1279
DATE: Aug 5, 1976

DMA-6,7

415-163