


Note: Lot line was projected beyond the recorded location of the lake shore. This may not be the line of true riparian ownership.

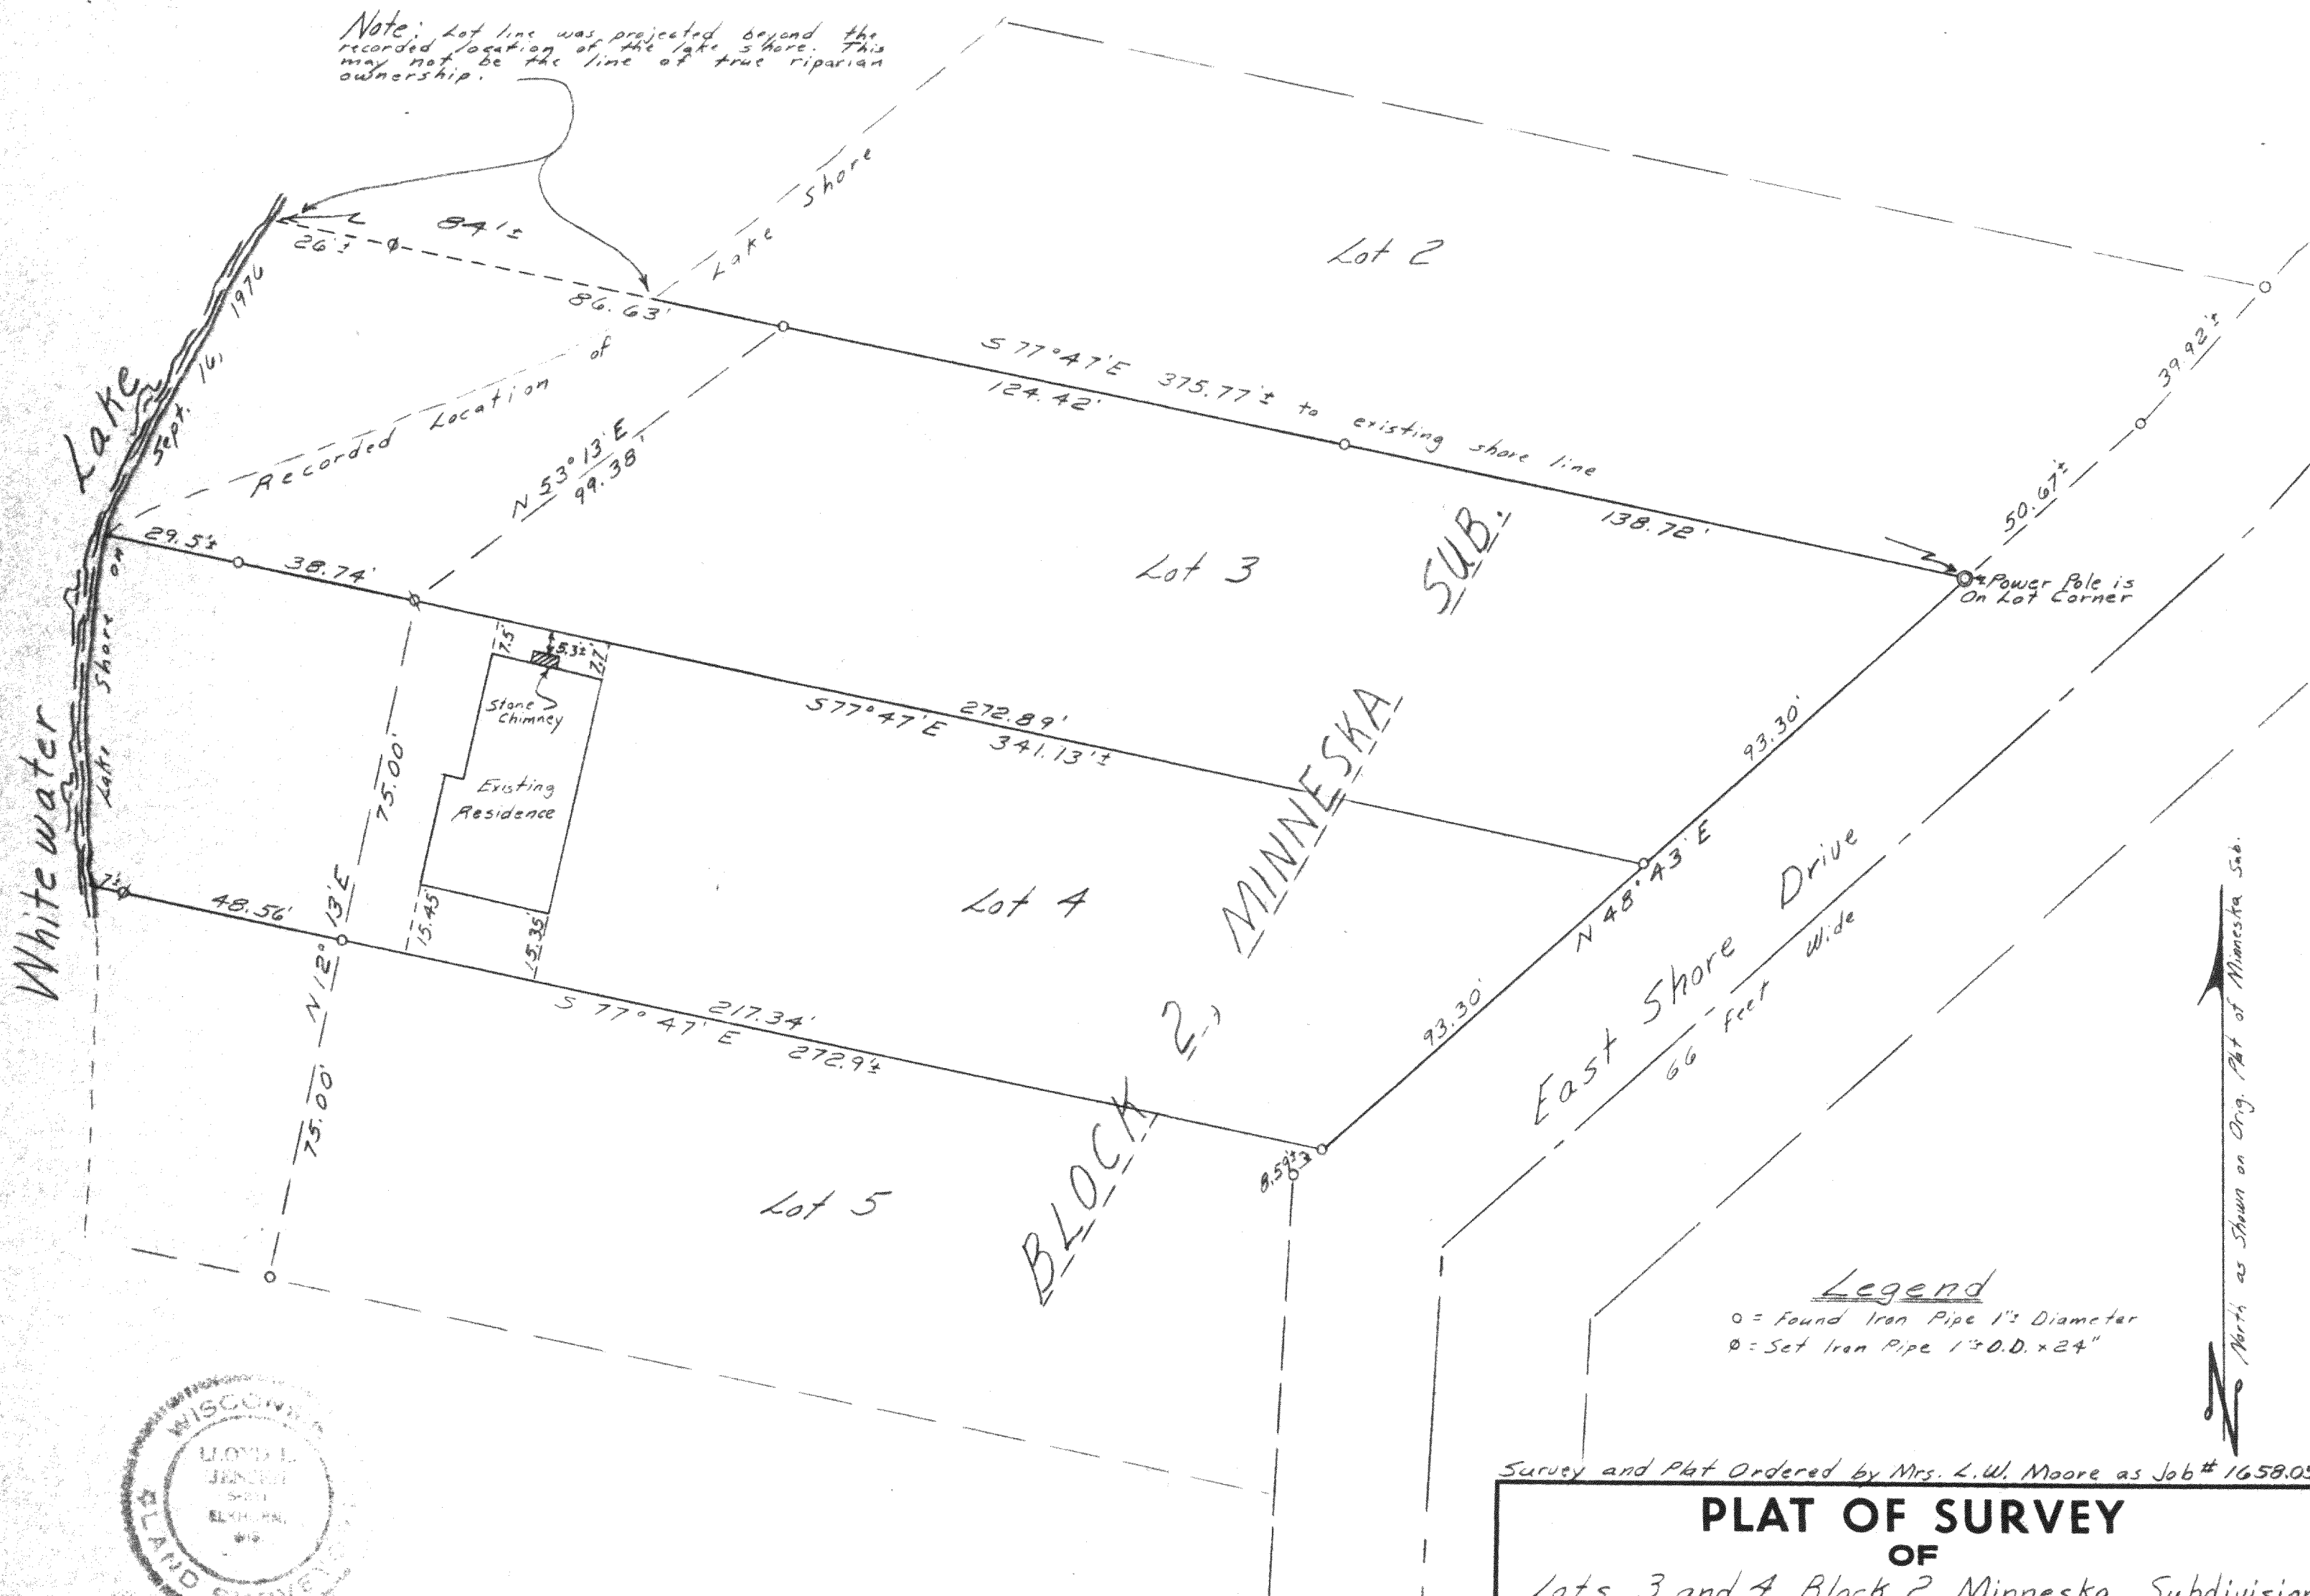

PLAT OF SURVEY OF

Lots 3 and 4, Block 2, Minneska Subdivision
 Located in the N.E. 1/4 of Section 35,
 Town 4 North, Range 15 East,
 Walworth County, Wisconsin

SCALE 1" = 30'

DATE 22 Sept 1976

I, Lloyd L. Jensen, Surveyor, do hereby certify that under my direction
 Lots 3 and 4, Block 2 of Minneska Subdivision have been surveyed and
 mapped, and that this Plat of Survey is a true and accurate representation
 of the lot lines and building location to the best of my knowledge and belief.

Dated this 27th day of Sept. 1976.

Lloyd L. Jensen
 Lloyd L. Jensen 5-211

PM-27,27A