




0' 20'

SCALE 1" = 20'


LEGEND:

- (100.00') RECORDED DISTANCE
- 100.00' MEASURED DISTANCE
- 1" FOUND IRON PIPE, UNLESS NOTED
- ⊙ 3/4" x 18" IRON ROD SET, 1.13 lbs./L.F.
- ⊕ WELL
- ⊙ ST SEPTIC TANK
- ⊙ S SEPTIC VENT
- ⊗ LIGHT POLE
- ⊠ E ELECTRIC TRANSFORMER
- ⊙ E ELECTRIC PEDESTAL
- ⊠ T TELEPHONE PEDESTAL
- ⊙ T CABLE TV PEDESTAL

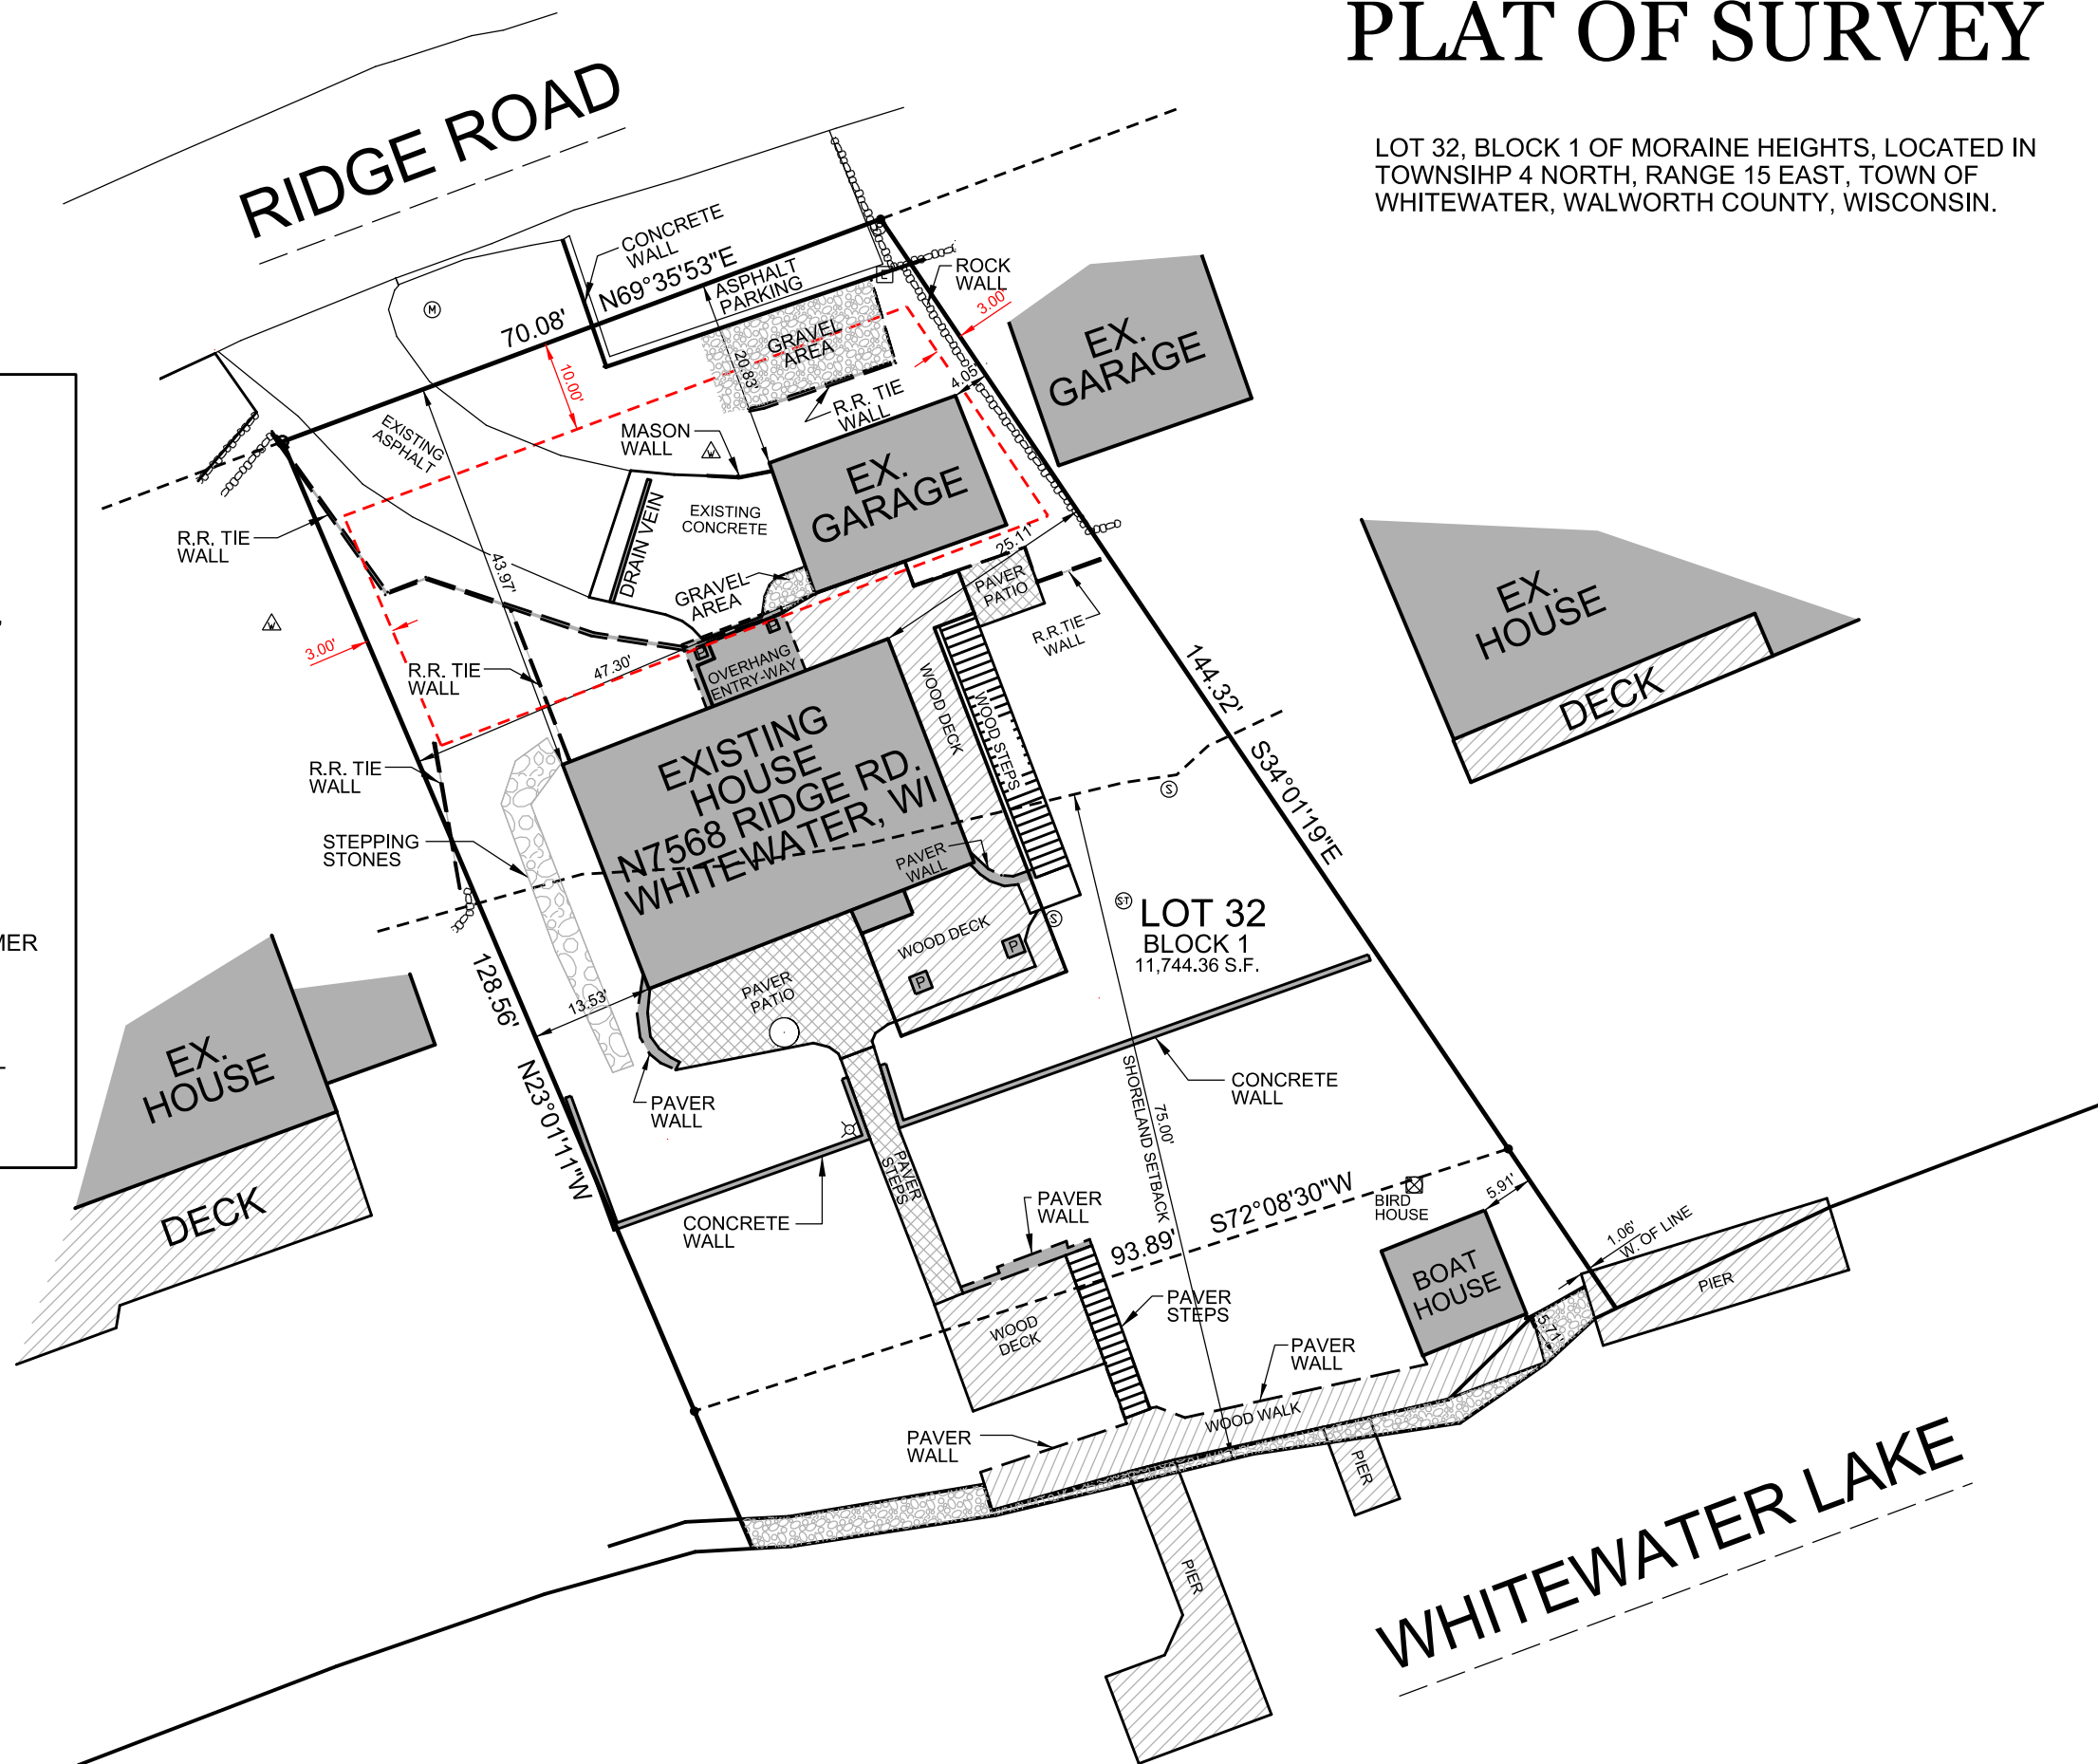

# PLAT OF SURVEY

LOT 32, BLOCK 1 OF MORAIN HEIGHTS, LOCATED IN TOWNSHIP 4 NORTH, RANGE 15 EAST, TOWN OF WHITEWATER, WALWORTH COUNTY, WISCONSIN.

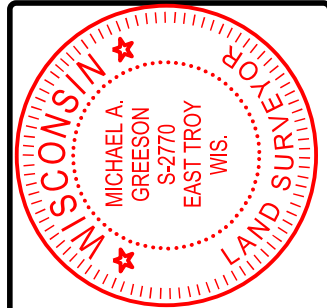

THIS SURVEY IS MADE FOR THE USE OF THE PRESENT OWNERS OF THE PROPERTY, AND ALSO THOSE WHO PURCHASE, MORTGAGE OR GUARANTEE TITLE TO WITHIN ONE (1) YEAR FROM DATE HERETO.

I, MICHAEL A. GREESON P.L.S. #2770, HEREBY CERTIFY THAT THIS SURVEY WAS MADE IN ACCORDANCE WITH THE MINIMUM STANDARDS FOR PROPERTY SURVEYS (CHAPTER A-E 7) FOR THE STATE OF WISCONSIN AND HAS BEEN PREPARED UNDER MY DIRECTION AND CONTROL AND IS CORRECT TO THE BEST OF MY KNOWLEDGE AND BELIEF.

SURVEY MADE FOR:  
 CAL WEBER BLDRS  
 W6946 TERRITORIAL RD  
 ELKHORN, WI

DATE	ITEM
09/02/2025	PLAT OF SURVEY

**V<sup>2</sup>G**  
 SURVEYING, LLC  
 123 WOLF RUN - SUITE 4  
 MUKWONAGO, WI 53149  
 (262) 378-5097

FILE NAME: 2025-111 C WEBER BLDRS N7568 RIDGE RD. WHITEWATER.DGN