


PLAT OF SURVEY

LOT 26, BLOCK 2, INDIAN TRAIL SUBDIVISION, LOCATED IN THE NORTHWEST 1/4 OF THE SOUTHWEST 1/4 OF SECTION 26 AND THE NORTHEAST 1/4 OF THE SOUTHEAST 1/4 AND THE SOUTHEAST 1/4 OF THE SOUTHEAST 1/4 OF SECTION 27, TOWN 4 NORTH, RANGE 15 EAST, WALWORTH COUNTY, WISCONSIN.
SURVEYED FOR: LISA GATTO
SURVEY ADDRESS: N7770 KETTLE MORaine DRIVE

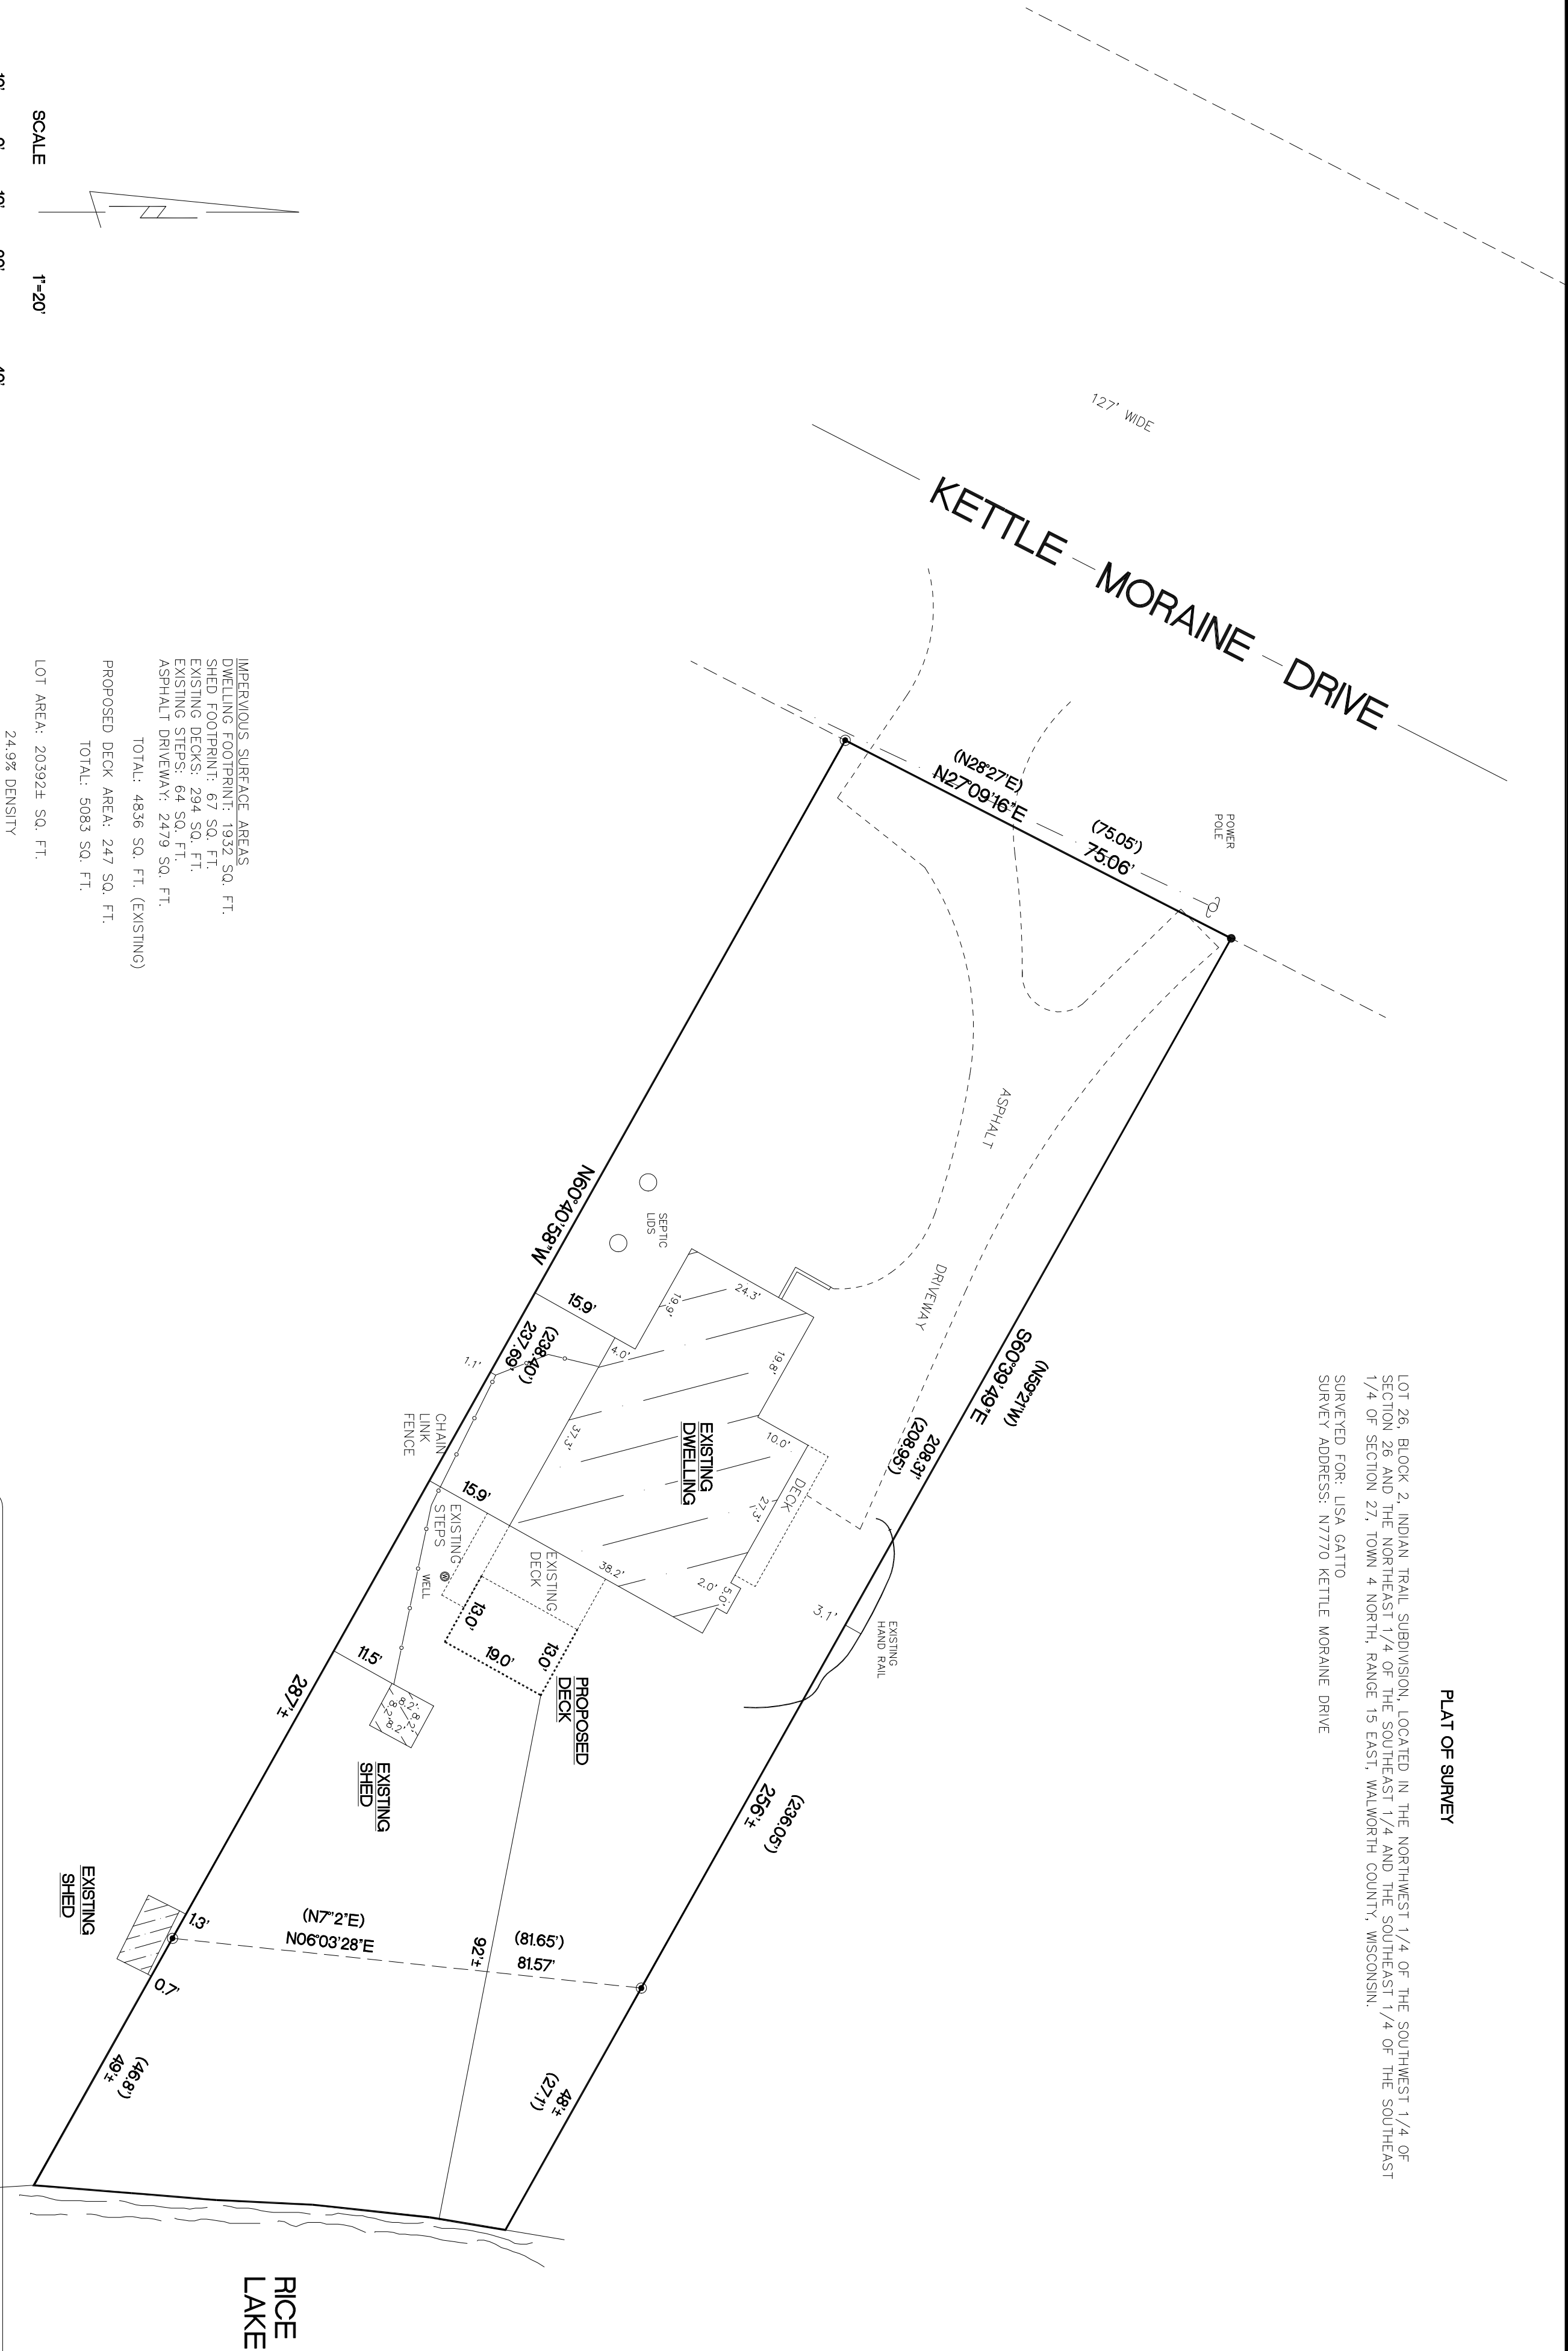

- FOUND 2" O.D. IRON PIPE
- SET 1 1/4" O.D. IRON PIPE
- () RECORDED AS DIMENSIONS

"I hereby certify that I have surveyed the above property and that the above map is a true representation thereof and shows the size and location of the property, its exterior boundaries, and the location of all principal buildings, fences, easements, roadways and encroachments if any.
"This survey is made for the use of the present owners of the property, and also those who purchase, mortgage or guarantee the title thereto within one year from date hereof."

Kettle Moraine Surveying Inc.
P.O. Box 357
Eagle WI 53119
(262)594-3484
kettlemorainesurveying.com

THIS IS NOT AN ORIGINAL SURVEY UNDER THE LAND SURVEYING ACT, CHAPTER 193, WISCONSIN STATUTES.

DATE 5/26/2026 FIELD WORK BY TEP DRAWN BY TEP JOB NUMBER 26066

