


PLAT OF SURVEY

OF LOT 2, CERTIFIED SURVEY MAP No. 3980, RECORDED IN VOLUME 24, PAGES 256-259 AS DOCUMENT No. 684820, BEING PART OF THE SW 1/4 OF THE SE 1/4 AND THE SE 1/4 OF THE SE 1/4 OF SECTION 8, T. 4 N., R. 15 E. OF THE 4TH P.M., TOWN OF WHITEWATER, WALWORTH COUNTY, WISCONSIN.

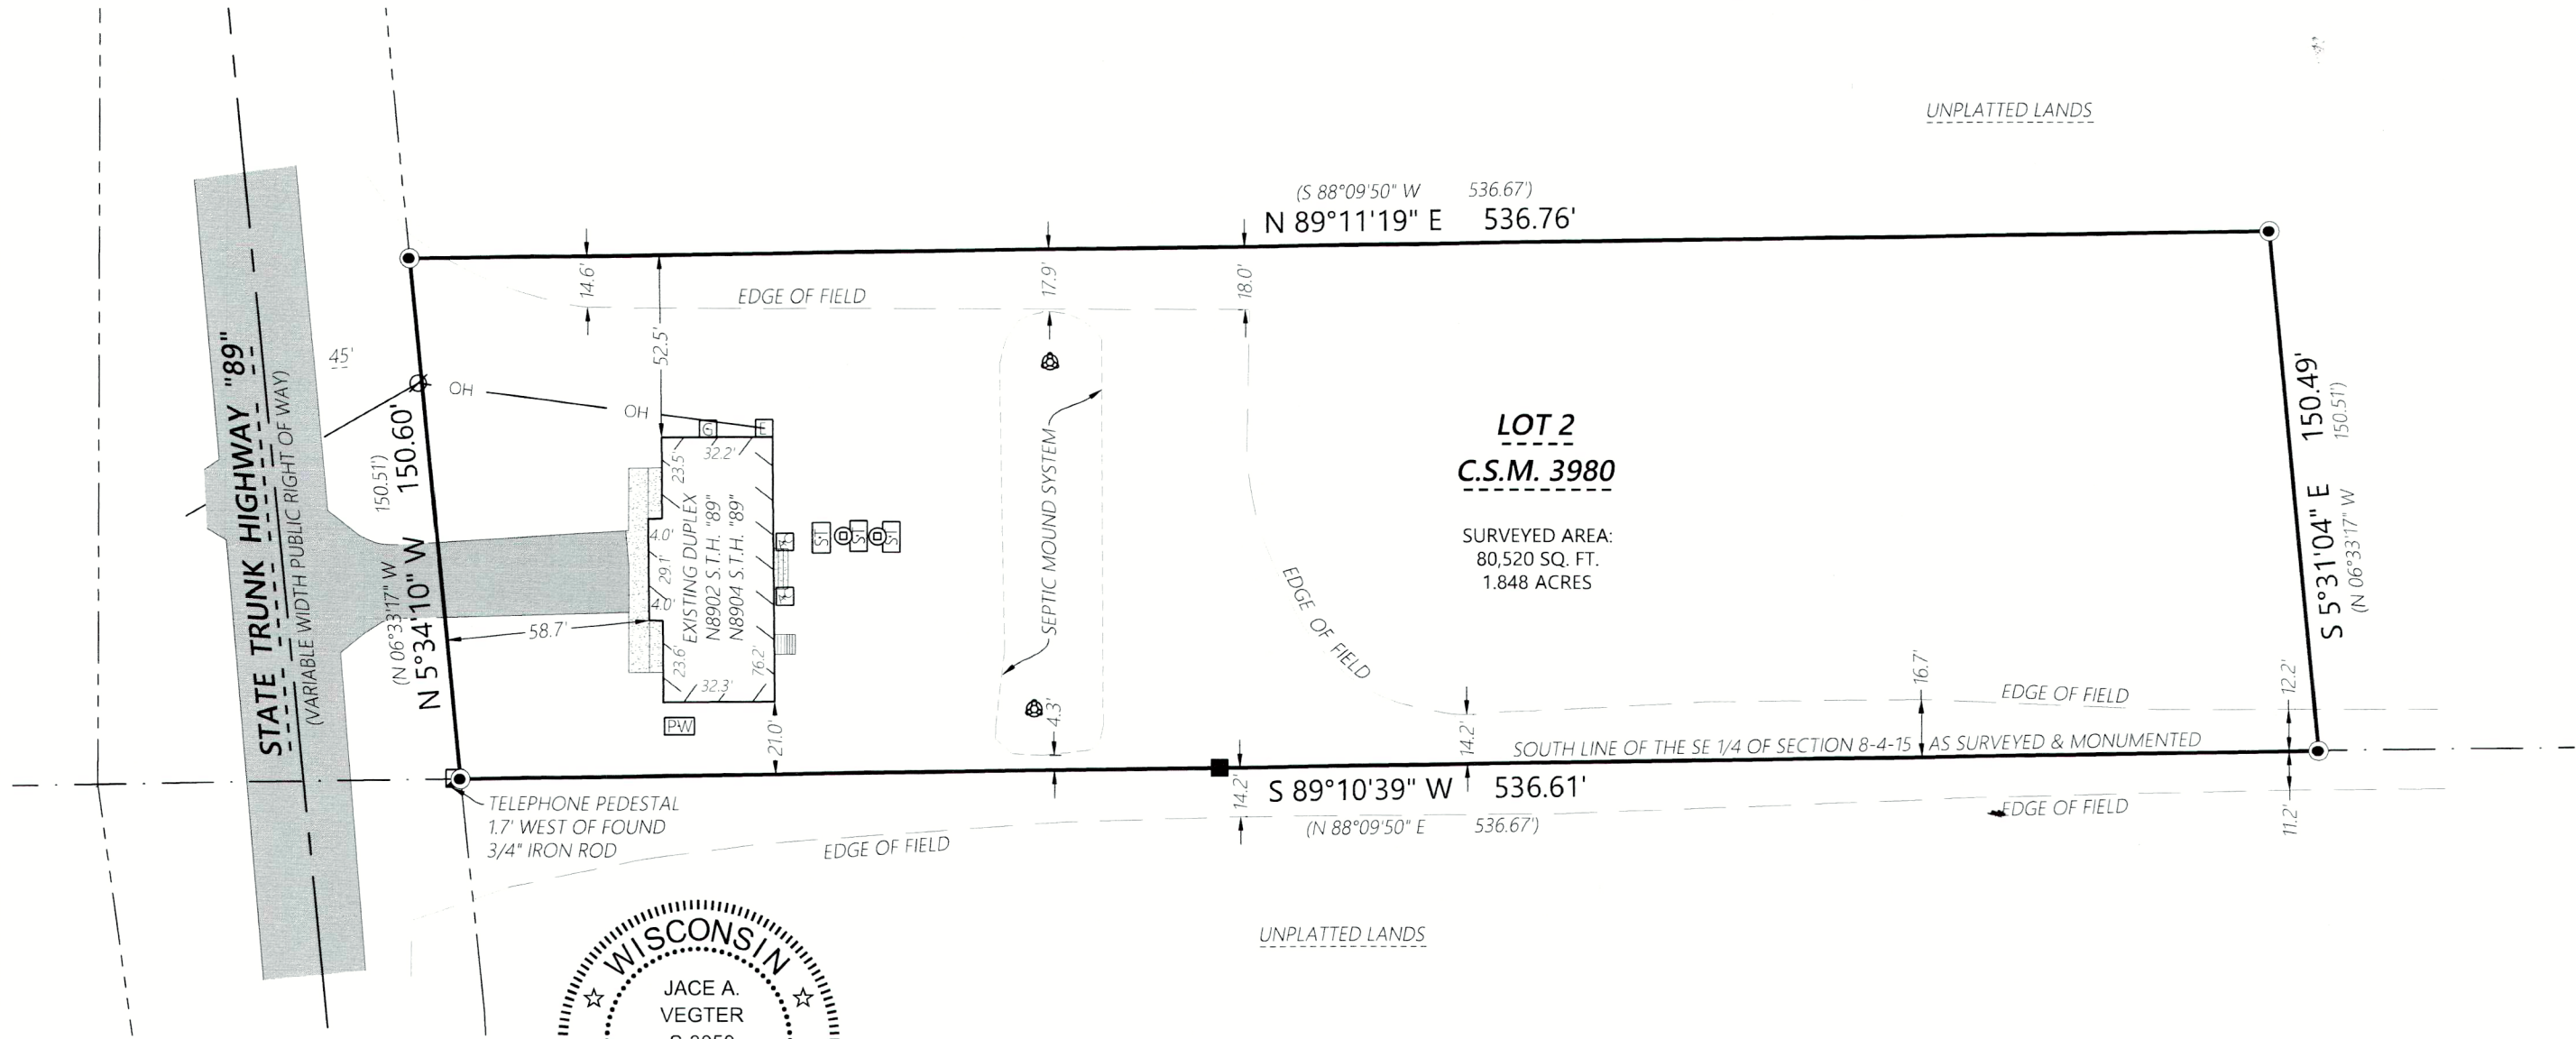

Jace Vegter

Jace A. Vegter, P.L.S.
Wisconsin Professional Land Surveyor S-3050

State of Wisconsin } ss
County of Rock

I hereby certify that I have supervised the survey of the property described above and to the best my knowledge and belief, the plat drawn hereon complies with Chapter A-E 7 of the State of Wisconsin Administrative Code, Minimum Standards for Property Surveys and correctly represents said survey and its location.

Given under my hand and seal at Milton, Wisconsin this 10th day of June, 2026


Last day of field work June 9, 2026



If the surveyor's signature is not red in color, the plan is a copy that should be assumed to contain unauthorized alterations. The certification contained on this document shall not apply to any copies.

LEGEND

- | | | | |
|-----------|-----------------------------|----|---------------------------|
| ● | 3/4" Iron Rod Found | Ø | Existing Utility Pole |
| ■ | Wooden Lath Set on Line | PW | Existing Well |
| (XXX.XX) | Record Information | ST | Existing Septic Tank |
| — — — — — | Existing Boundary Line | ⊗ | Existing Septic Vent |
| - - - - - | Existing Right-of-Way | ⊙ | Existing Cleanout |
| — · — · — | Existing Centerline | ⊠ | Existing Air Conditioner |
| — · — — — | Existing Section Line | G | Existing Gas Meter |
| E | Existing Electric Meter | | Existing Asphalt Pavement |
| ■ | Existing Telephone Pedestal | | Existing Concrete |
| — OH — | Existing Overhead Power | | Existing Wood Deck |

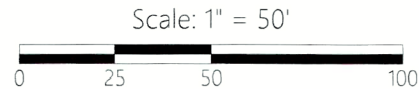

DISTANCE UNITS BASED ON THE UNITED STATES SURVEY FOOT

BEARINGS BASED ON THE WISCONSIN COORDINATE REFERENCE SYSTEM, WALWORTH ZONE. THE EAST LINE OF S.T.H. "89" BEARING N 5°34'10" W

SURVEY NOTE

SURVEYED PROPERTY SUBJECT TO ANY AND ALL EASEMENTS AND AGREEMENTS RECORDED AND UNRECORDED.

FOR THE EXCLUSIVE USE OF:
Dawn Kienbaum
W132N6545 Westview Drive
Menomonee Falls, WI 53051

ORDER NO: 35943
FIELD CREW: JAV
DRAWN BY: JAV
SHEET 1 OF 1

Batterman
engineers, surveyors, planners
BELOIT | ELKHORN | JANESVILLE
2857 S. Bartels Dr., Beloit, WI 53511
608.365.4464 | www.rhbatterman.com



DA3980-2

415-1787