


PLAT OF SURVEY
OF LOT 1 OF CERTIFIED SURVEY MAP NUMBER 1269,
BEING PART OF THE SW 1/4 OF THE NW 1/4 OF SECTION 6, T. 4 N., R. 15 E.,
OF THE 4TH P.M., TOWN OF WHITEWATER, WALWORTH COUNTY, WISCONSIN

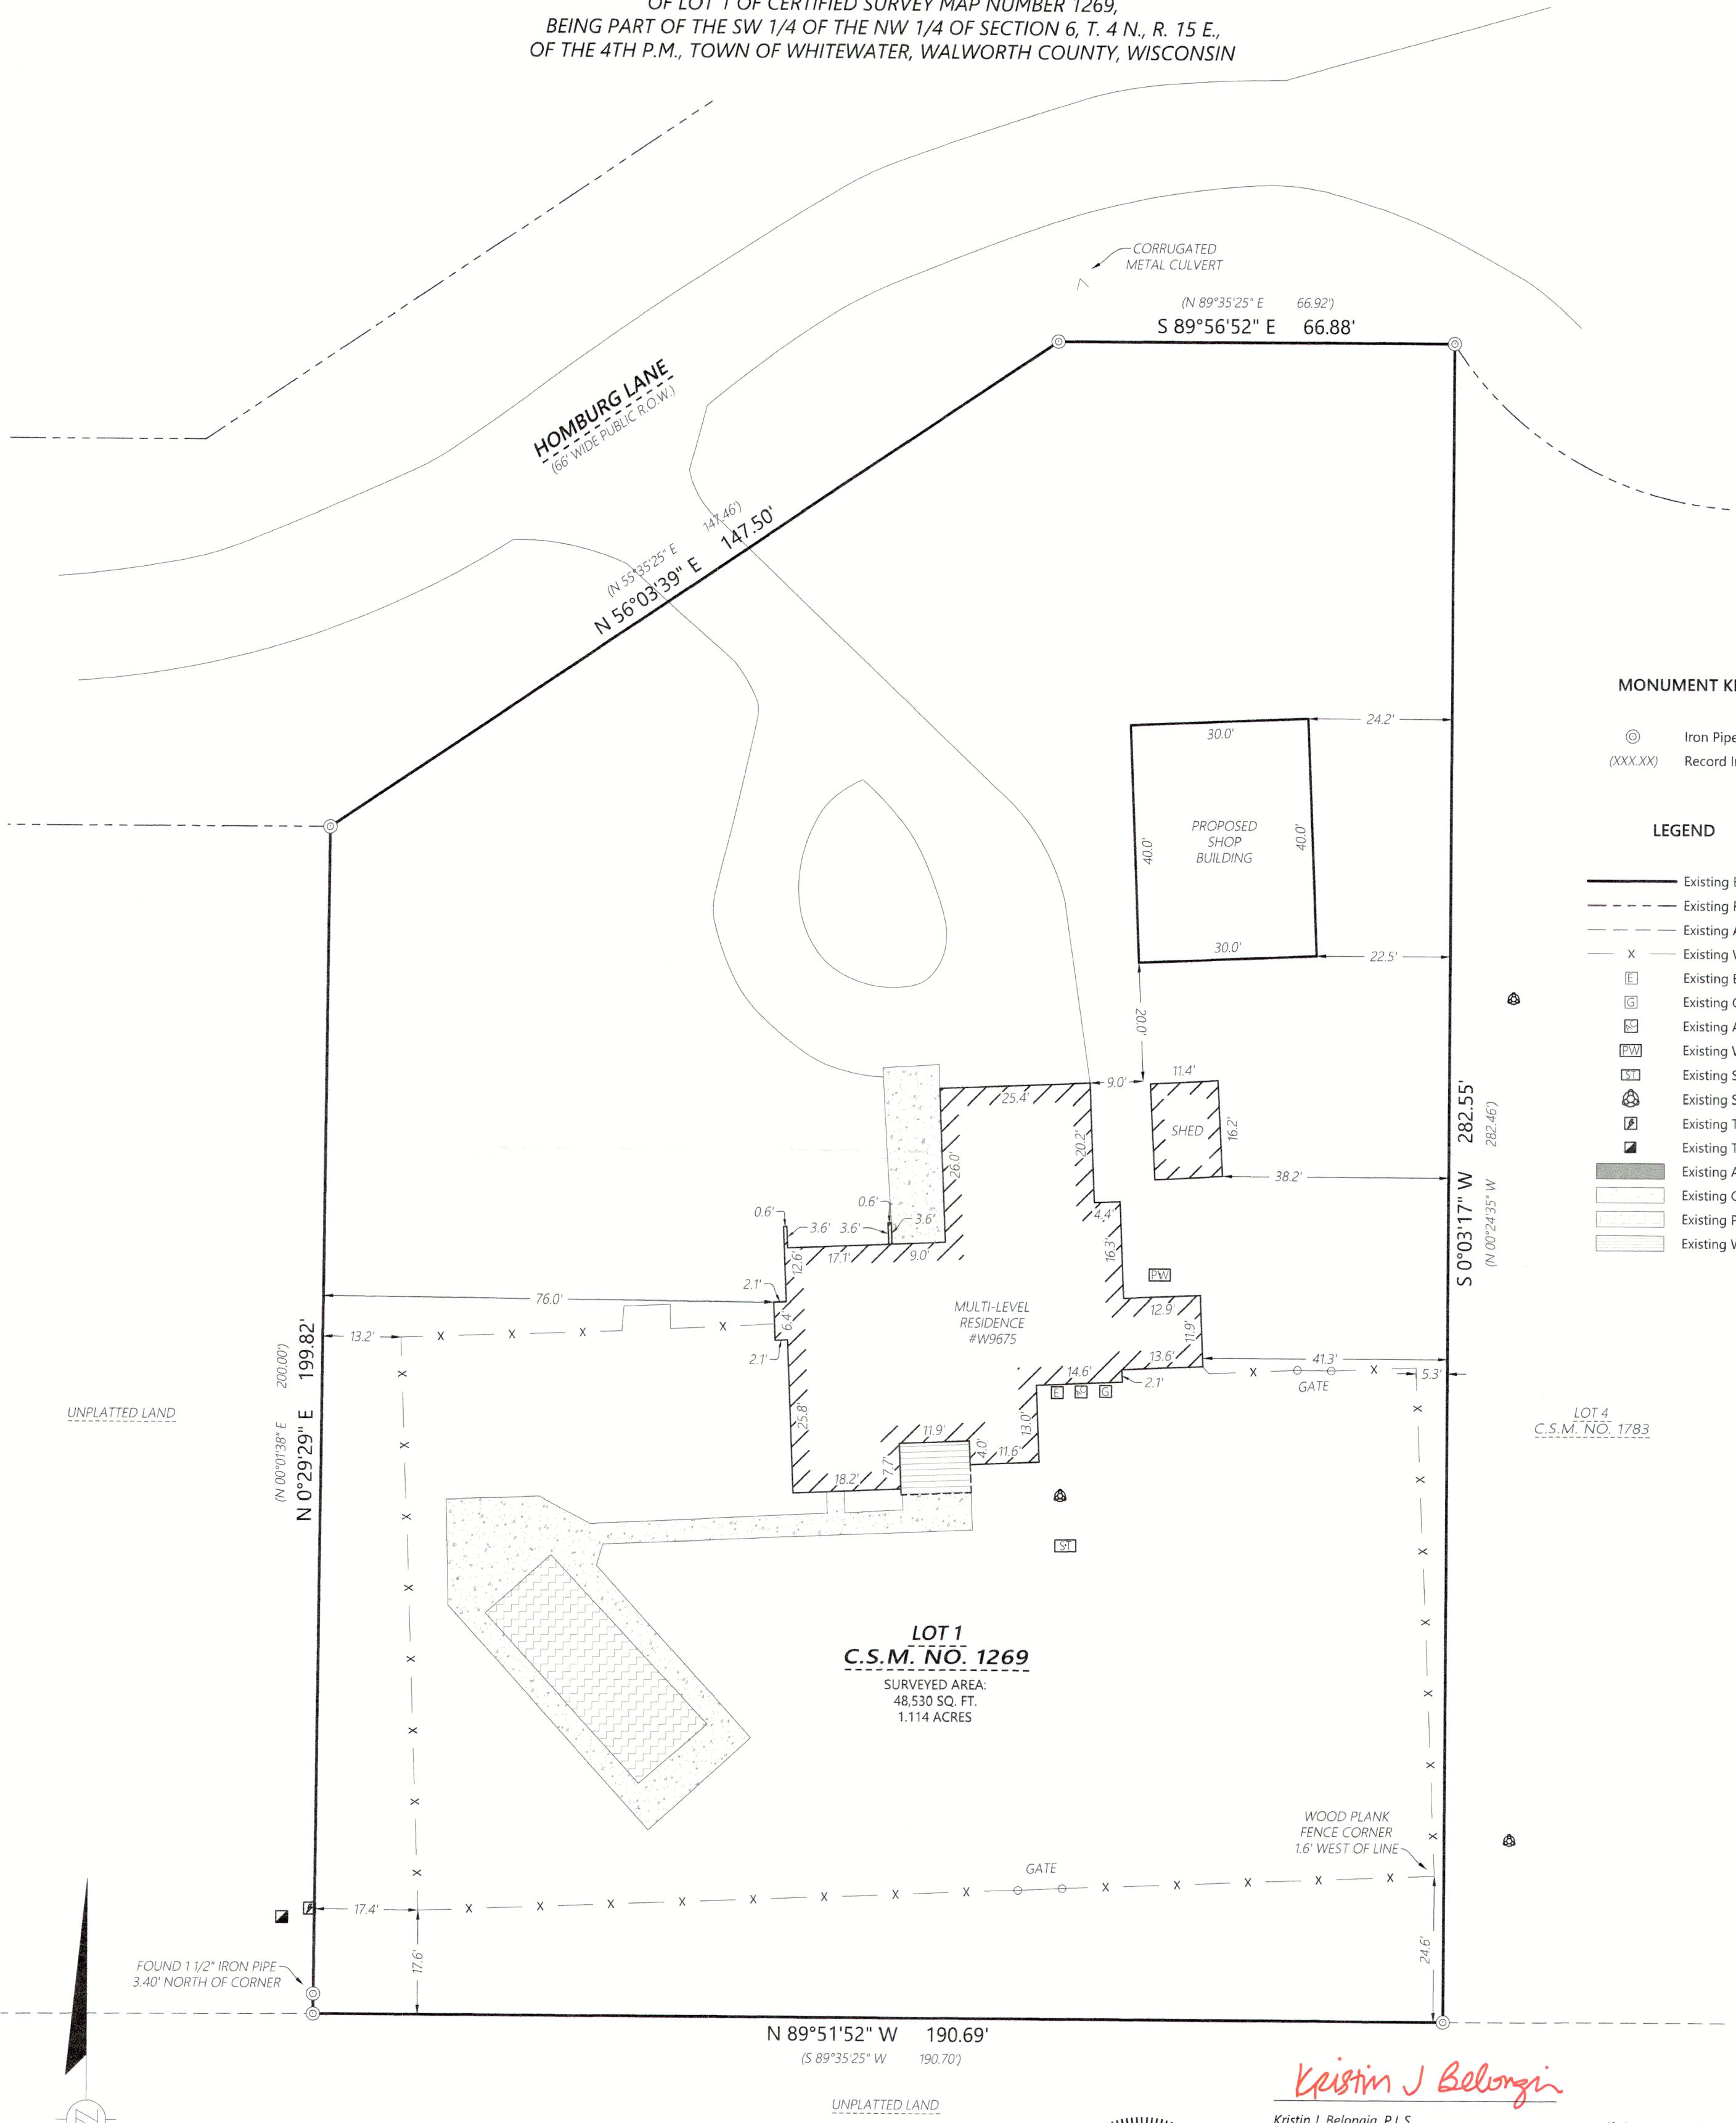

MONUMENT KEY

- Iron Pipe Found
- Record Information

LEGEND

- Existing Boundary Line
- Existing Right-of-Way
- Existing Adjacent Property
- Existing Wood Plank Fence
- Existing Electric Meter
- Existing Gas Meter
- Existing Air Conditioner
- Existing Well
- Existing Septic Tank
- Existing Septic Vent
- Existing Transformer
- Existing Telephone Pedestal
- Existing Asphalt Pavement
- Existing Concrete
- Existing Pool
- Existing Wood Deck

LOT 1
C.S.M. NO. 1269
SURVEYED AREA:
48,530 SQ. FT.
1.114 ACRES

SURVEY NOTES

1. SURVEYED PROPERTY SUBJECT TO ANY AND ALL EASEMENTS AND AGREEMENTS RECORDED AND UNRECORDED.



Kristin J. Belongia

Kristin J. Belongia, P.L.S.
Wisconsin Professional Land Surveyor S-2943

State of Wisconsin } ss
County of Walworth }

I hereby certify that I have supervised the survey of the property described above and to the best of my knowledge and belief, the plat drawn hereon complies with Chapter A-E 7 of the State of Wisconsin Administrative Code, Minimum Standards for Property Surveys and correctly represents said survey and its location.
Given under my hand and seal at Elkhorn, Wisconsin this 12th day of May, 2026
Last day of field work April 8th, 2026

If the surveyor's signature is not red in color, the plan is a copy that should be assumed to contain unauthorized alterations. The certification contained on this document shall not apply to any copies.

ORDER NO: 35867

FIELD CREW: BMR
DRAWN BY: BMR
SHEET 1 OF 1

FOR THE EXCLUSIVE USE OF:

Kyle Rackers
W9675 Homburg Lane
Whitewater, WI 53190

PLAT OF SURVEY

Batterman
engineers surveyors planners
BELOIT | ELKHORN | JANESVILLE
2857 S. Bartells Dr., Beloit, WI 53511
608.365.4464 | www.rbatterman.com

