


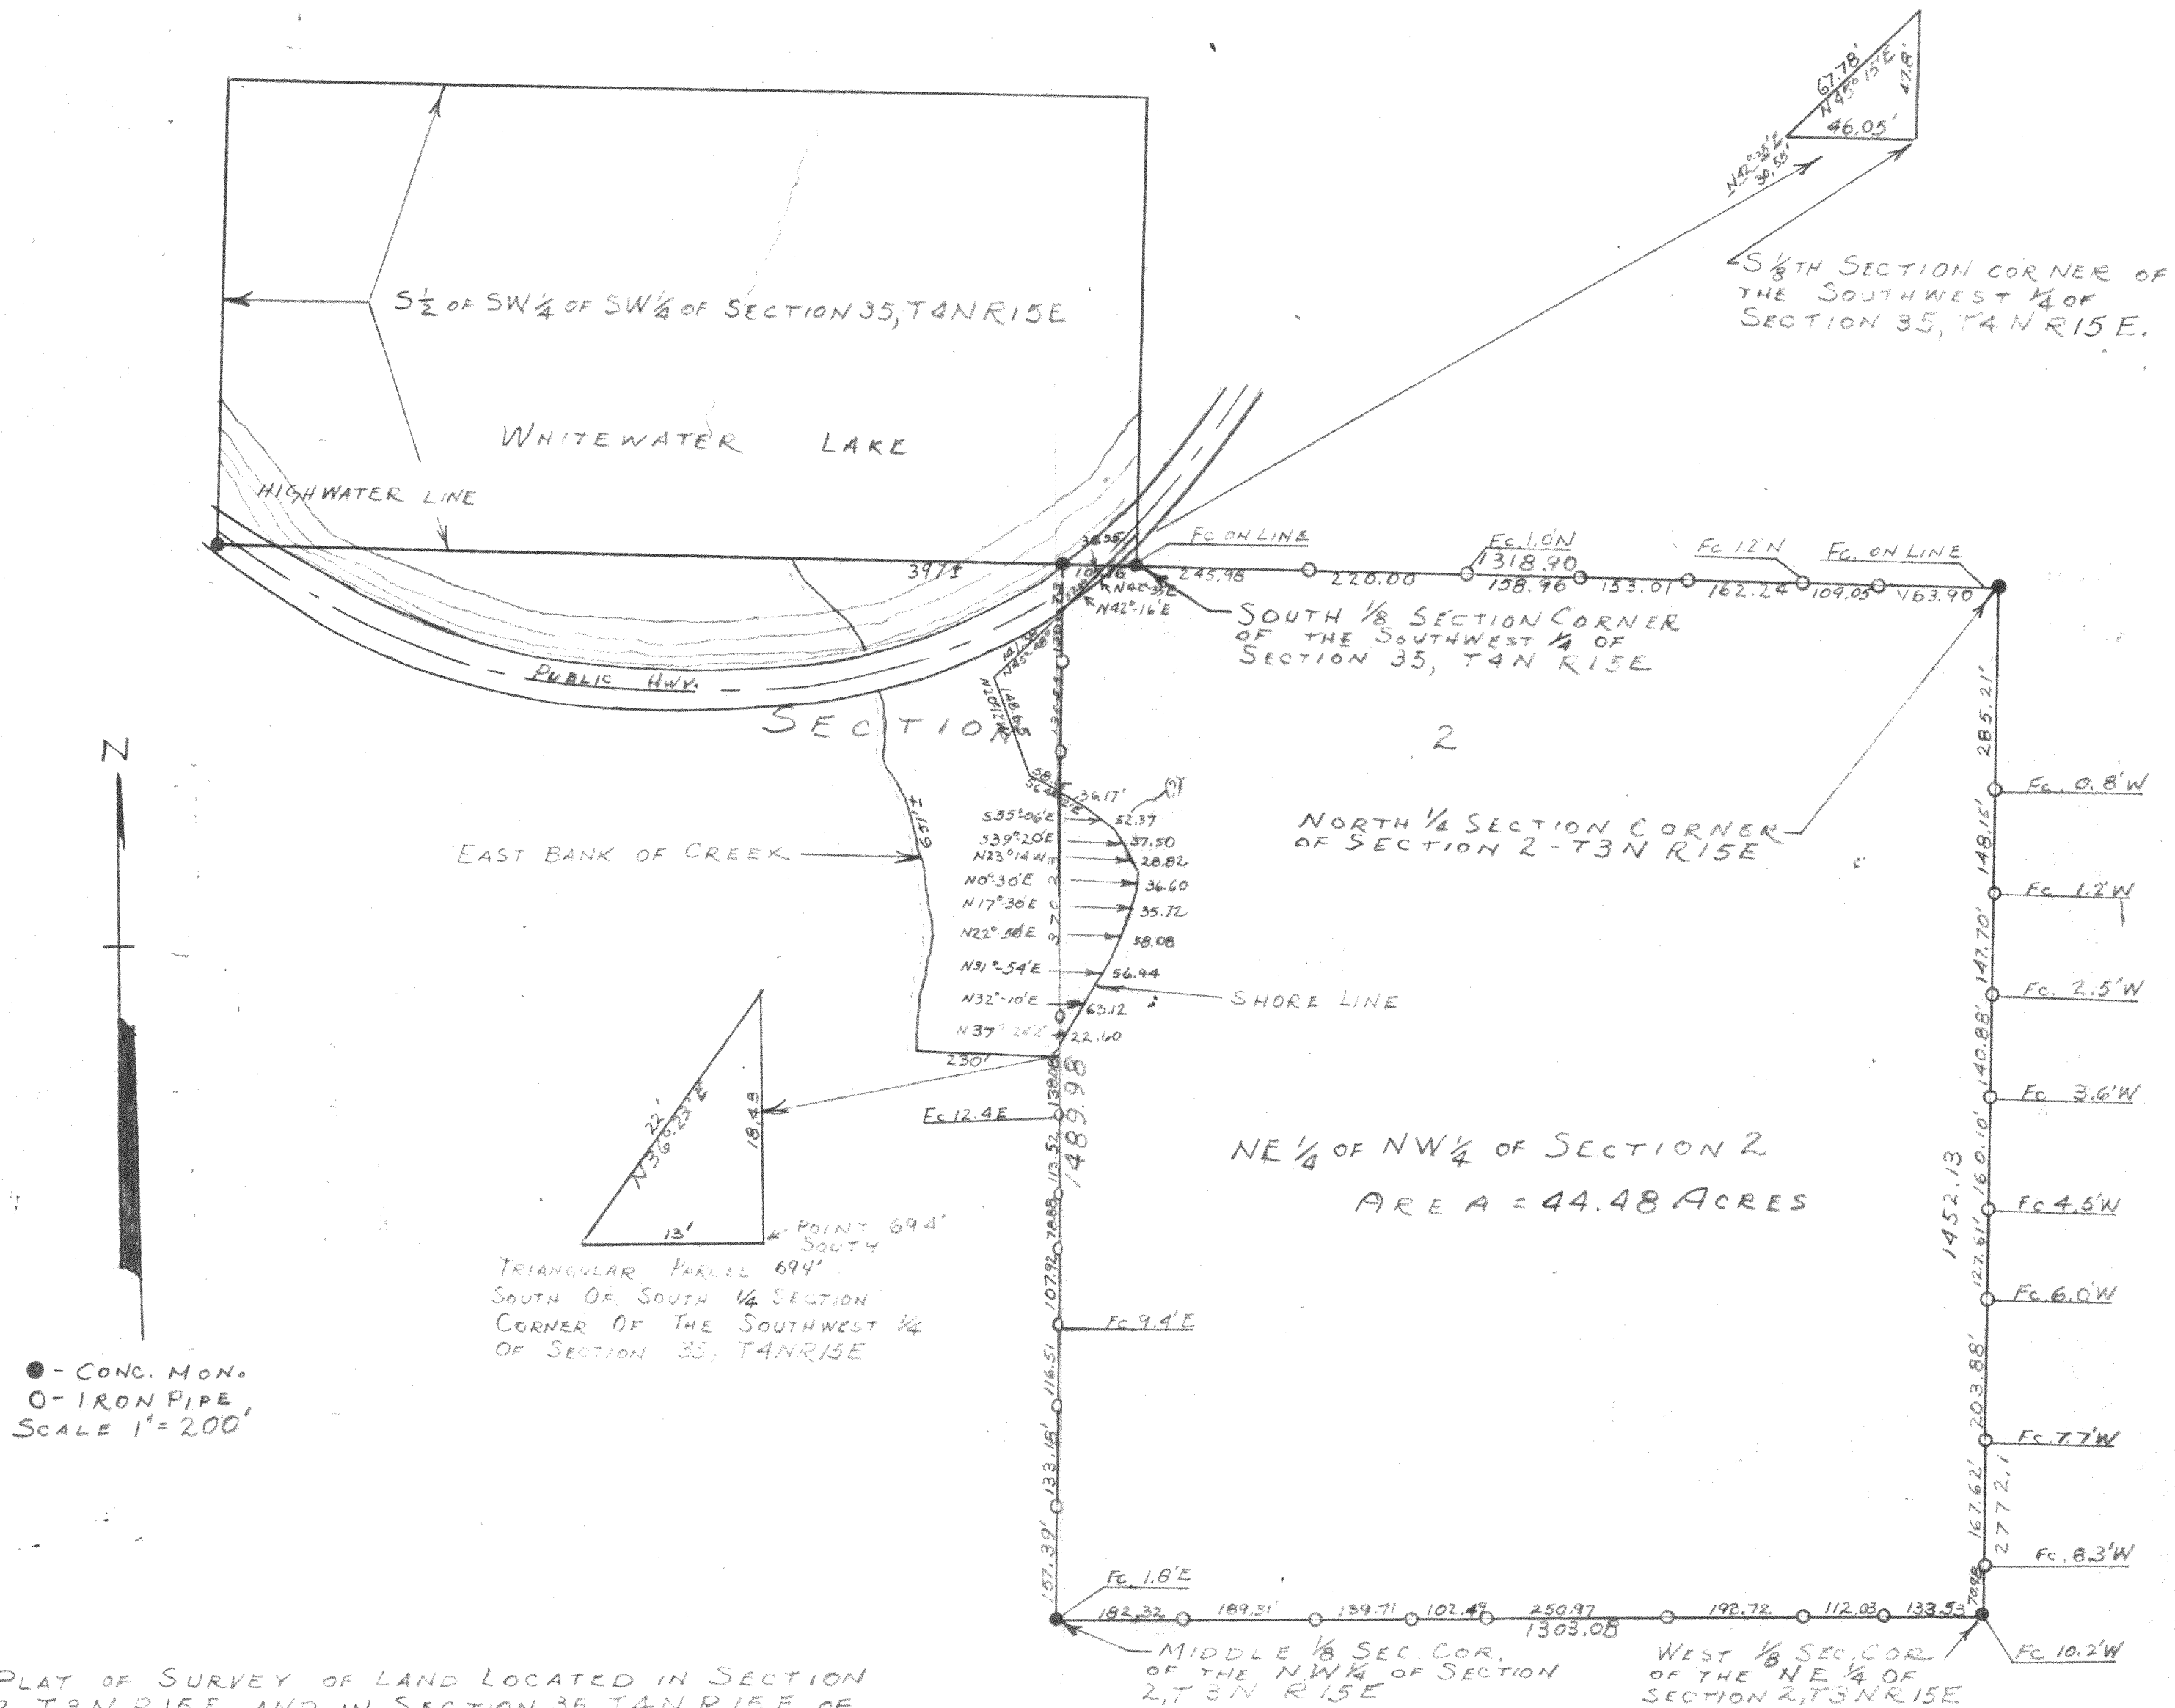

PLAT OF SURVEY OF LAND LOCATED IN SECTION
 2, T3N R15E AND IN SECTION 35, T4N R15E OF
 WALWORTH COUNTY, WISCONSIN

July 1951

LLOYD L. JENSEN
 WALWORTH COUNTY SURVEYOR
 (COPIED 1957 BY G.T.D.)

W-35-25-W-35-26 + R-2-8 415-18.1J