


PLAT OF SURVEY OF A parcel of land located in the NE $\frac{1}{4}$ of Section 13, T4N R13E, Walworth County, Wisconsin, described as follows: Commence at the North $\frac{1}{4}$ Corner of said Section 13, thence N88°-52'-28"E 727.50 feet to the point of beginning; thence continue N88°-52'-28"E 592.82 feet; thence S0°-02'-45"W 1317.64 feet; thence S88°-28'W 330.31 feet; thence N0°-03'-33"E 419.69 feet; thence S88°-52'-28" West 262.50 feet; thence N0°-02'-10"E 900.30 feet to the point of beginning; parcel contains 15.42 Acres of land.

Also an ingress and egress easement described as follows: Begin at the said North $\frac{1}{4}$ Corner; thence S0°-02'-10"W 50.01 feet; thence N88°-52'-28"E 727.50 feet; thence N0°-02'-10"E 50.01 feet; thence S88°-52'-28"W 727.50 feet to the point of beginning.

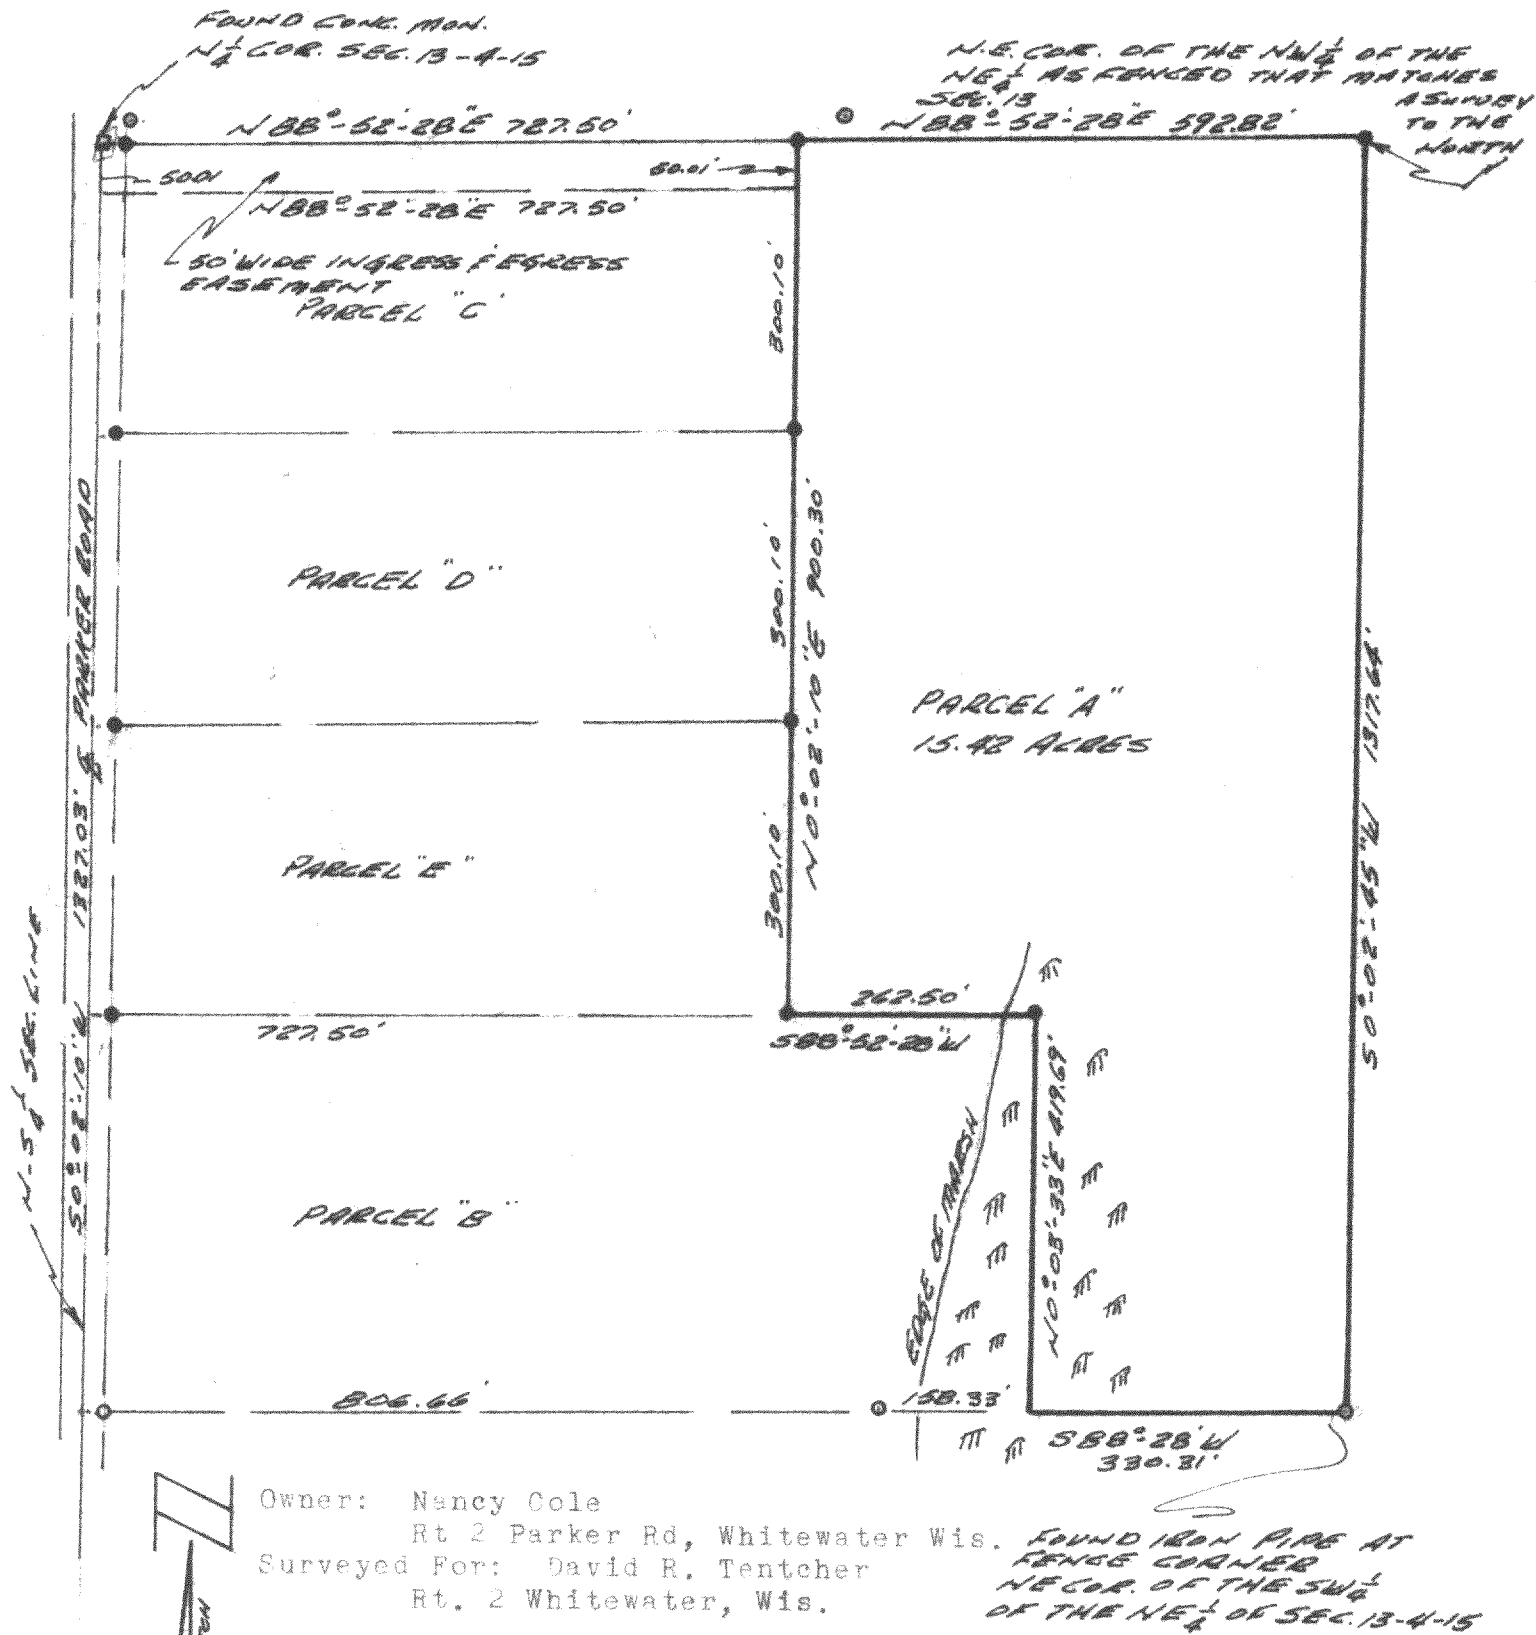


I certify that I surveyed the above described property & that the plat shown hereon is an accurate survey & a true representation thereof & correctly shows the boundary lines of said property.

SCALE 1" = 200'

- ~IRON ROD SET
- ~IRON PIPE FOUND

Aug. 3, 1977

P.O.# 1977.042

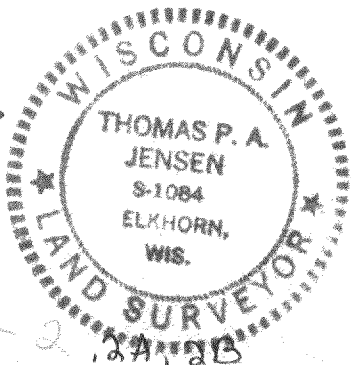

Thomas P.A. Jensen S-1084
JENSEN SURVEYING & MAPPING
ELKHORN, WISCONSIN

415-193