


HAROLD H. KOLB

REGISTERED PROFESSIONAL LAND SURVEYOR
LAKE GENEVA, WISCONSIN

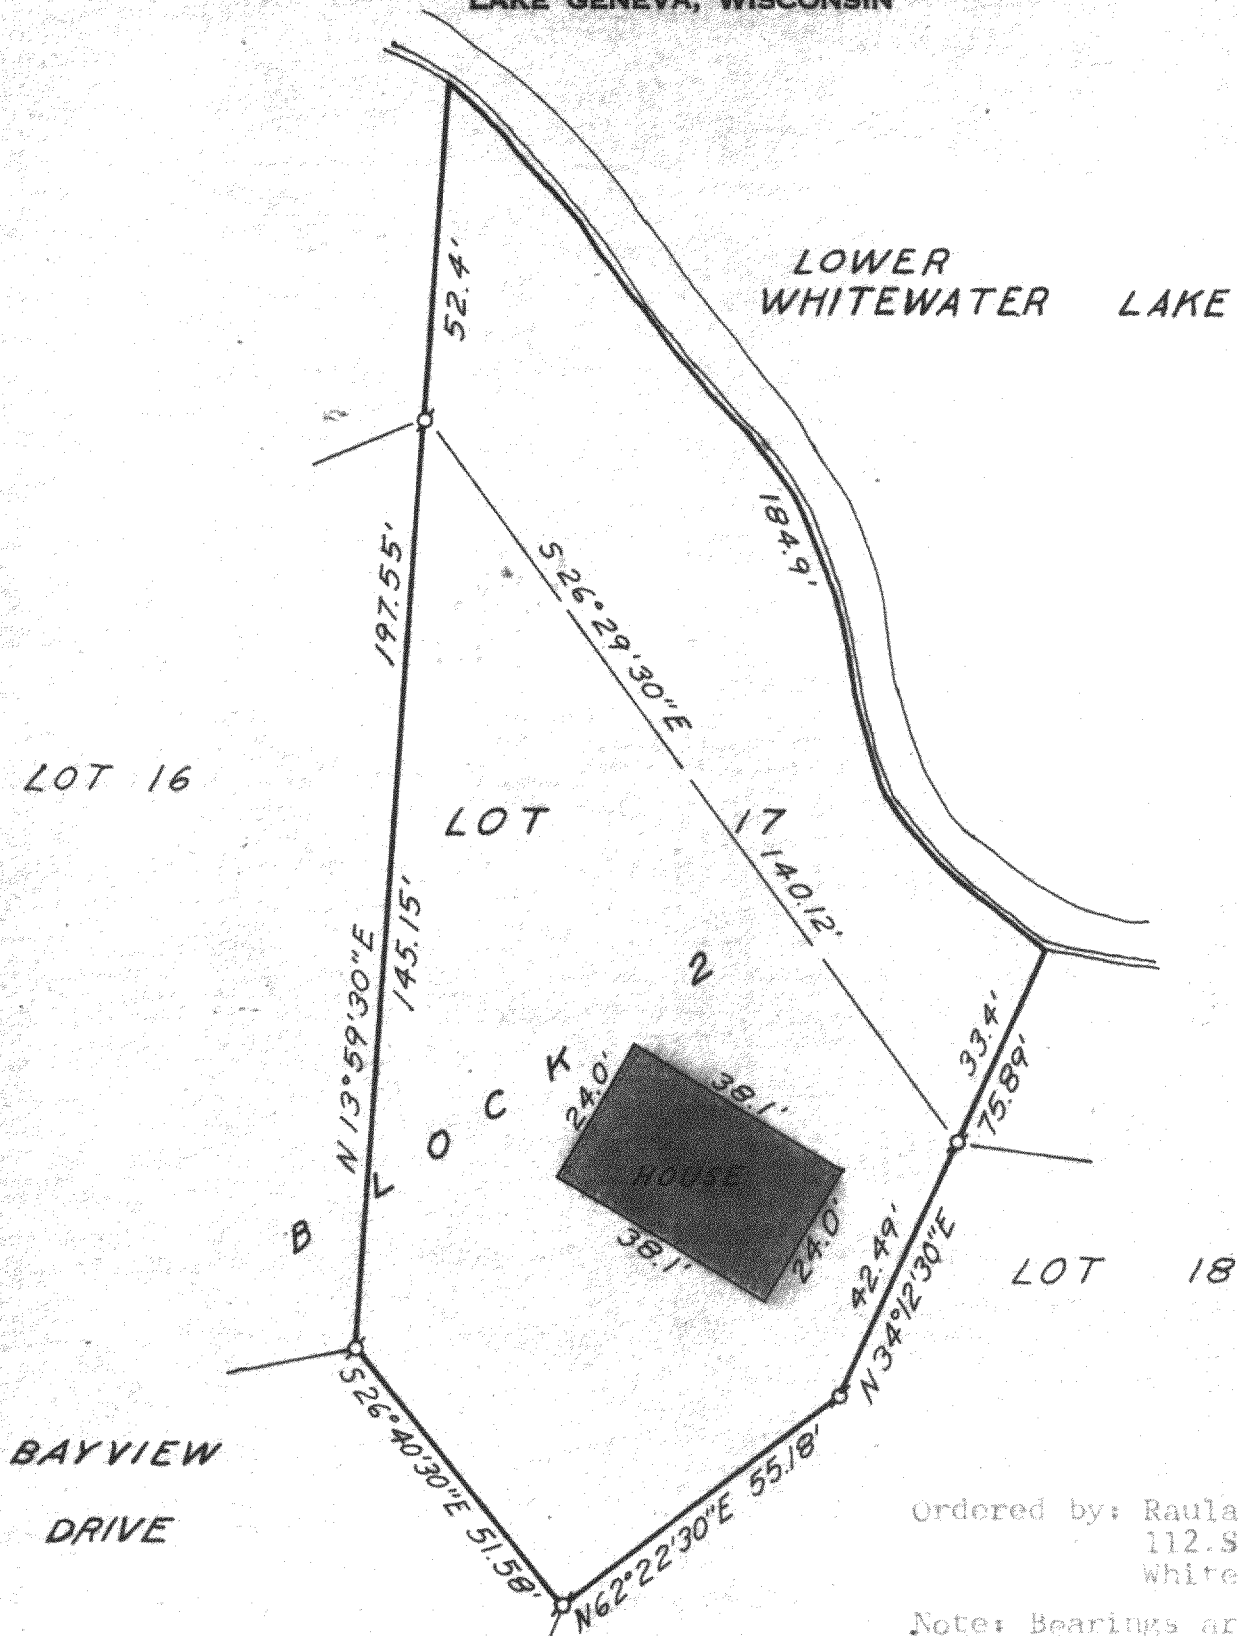

PLAT OF SURVEY OF

LOT 17, BLOCK 2, OF LUDTKE SUBDIVISION, SECTION
26, T 4 N, R 15 E, WALWORTH COUNTY, WISCONSIN.

N



SCALE 1"=30'

LEGEND

- O — IRON PIPE PLACED, 1" x 24" 1.13 LB./LIN. FT.
- — CONCRETE MONUMENT, 5" DIA. x 30"
- — IRON PIPE FOUND

Eugene A. Blomquist
EUGENE A. BLOMQUIST
WISCONSIN REGISTERED LAND SURVEYOR, S-1279

DATE Nov. 10, 1978