


KOLB LAND CONSULTING, INC.
LAND SURVEYING • SUBDIVIDING • LAND PLANNING

LAKE GENEVA, WISCONSIN 53147


WHITEWATER, WISCONSIN 53190

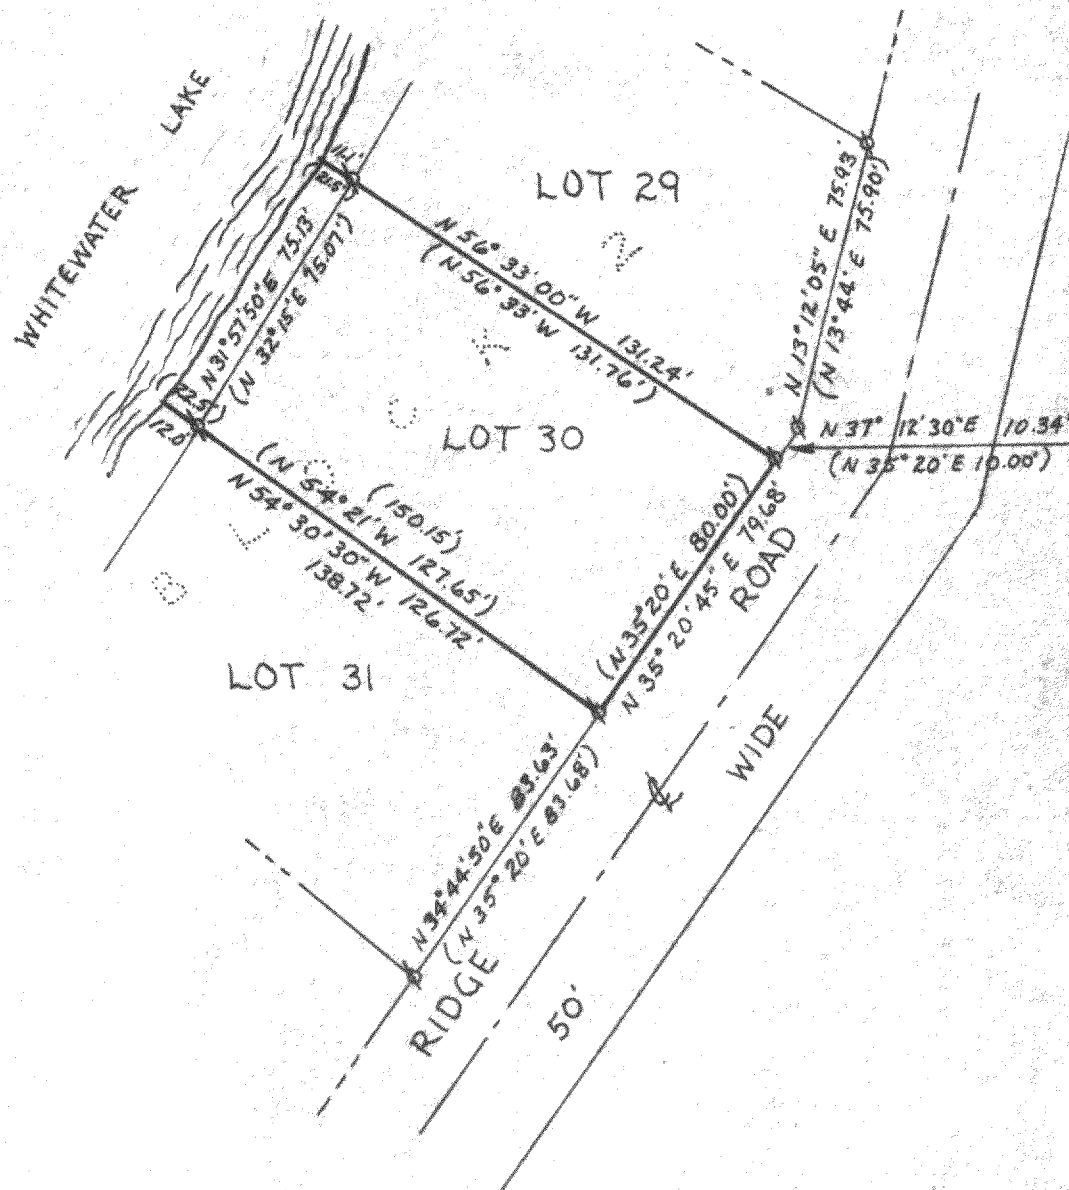

PLAT OF SURVEY OF

Lot 30, Block 2, Mordine Heights Subdivision,
located in the Northwest 1/4 of Section 35, T4N,
R15E, Walworth County, Wisconsin.

Note: Bearings assumed as platted.

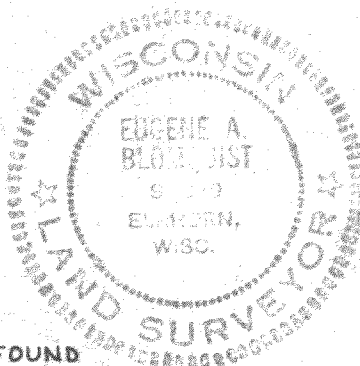

SCALE: 1"=50'

LEGEND

- ⊙ - IRON PIPE FOUND
- () - PLATTED AS

I, Eugene A. Blomquist, do hereby certify
that I have surveyed the property hereon
described according to the official records,
and that plat hereon is a correct
representation of the lot lines.

EUGENE A. BLOMQUIST
WISCONSIN REGISTERED LAND SURVEYOR, S-1279

DATE May 30, 1979

DMH-63

415-212