



PLAT OF SURVEY

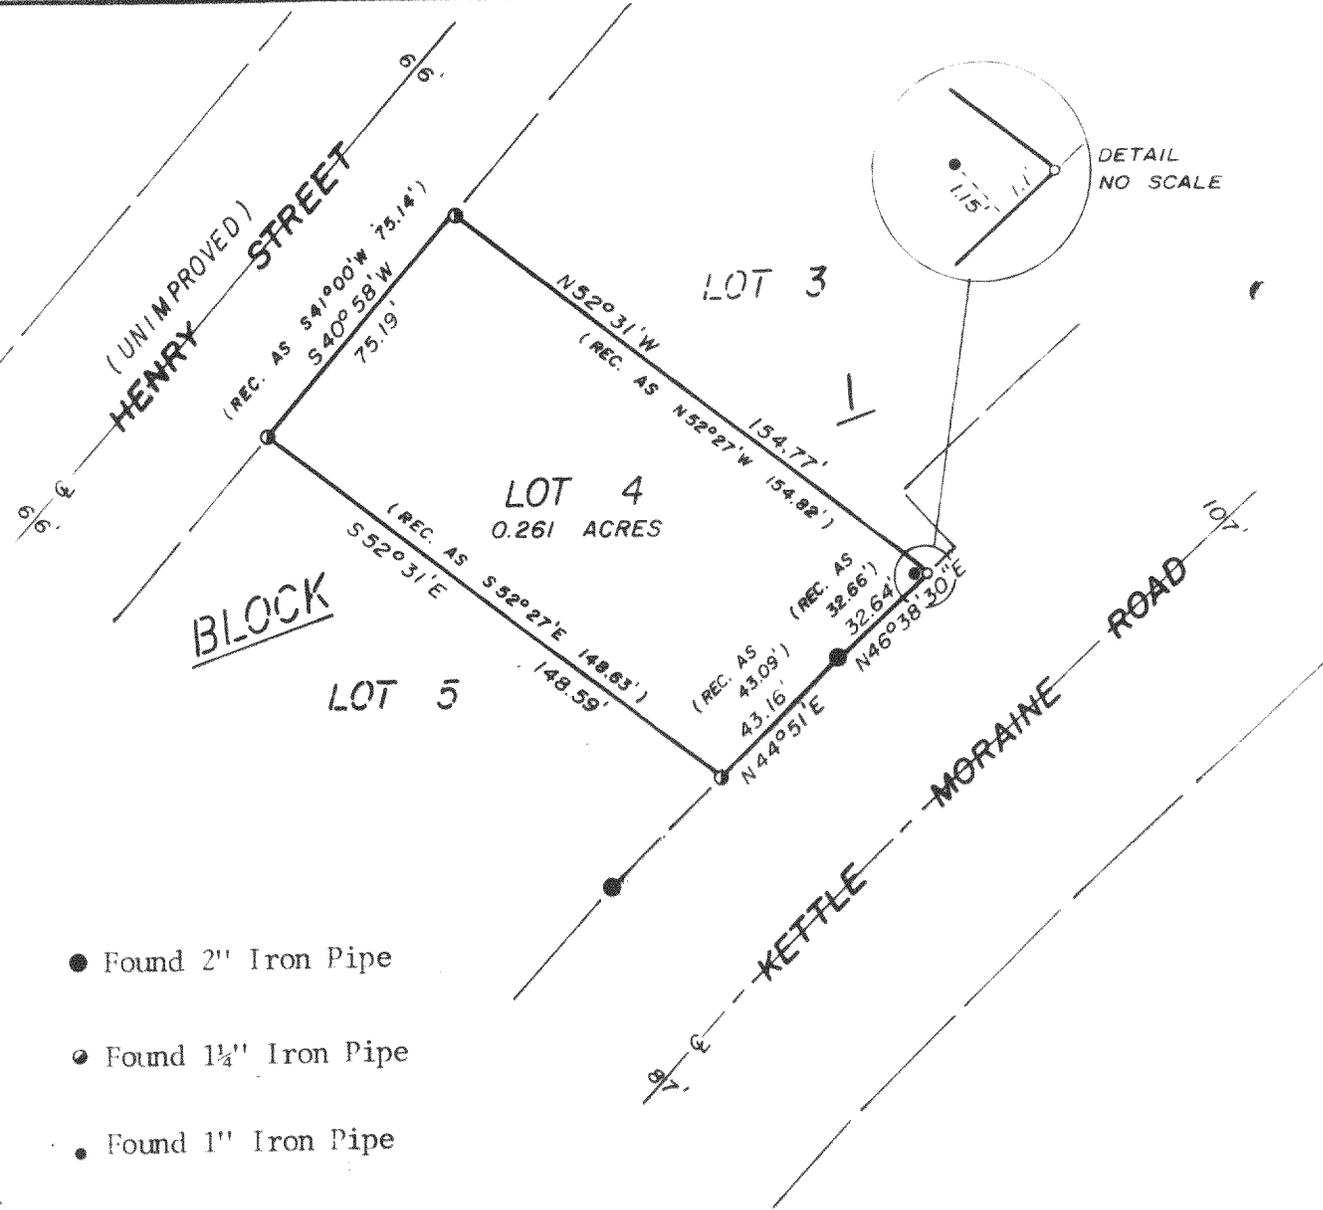

- Found 2" Iron Pipe
- Found 1 1/2" Iron Pipe
- Found 1" Iron Pipe
- Set 1"x24" Iron Pipe

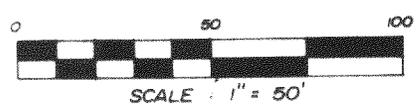

DESCRIPTION

Lot 4, Block 1, INDIAN TRAIL SUBDIVISION in the NE 1/4 of the SE 1/4 of Section 27, T4N, R15E, Town of Whitewater, Walworth County, Wisconsin

CERTIFICATION

I certify that the property described above has been surveyed under my responsible direction and supervision and that the above map is a correct representation of the size and location of the property and the location and dimensions of all visible structural improvements, if any.

This survey is made for the exclusive use of the present owners of the property and also those who purchase, mortgage or guarantee the title thereto, and is certified for one year from date hereto.

Date 5-19-80

James B. Woodman
Registered Land Surveyor, S-1239
WOODMAN
S-1239
FORT ATKINSON,
WIS.

WISCONSIN
LAND SURVEYOR

Prepared for: Rauland Agency
Attn: Mr. Harry Devitt
112 South First Street
Whitewater, WI 53190

DITS-4


JN 80S-42

STRAND & WOODMAN ASSOCIATES
210 Madison Ave., Fort Atkinson, WI 53538

Land Surveyors & Engineers
Phone (414) 563-8162

415-221-2

PLAT OF SURVEY

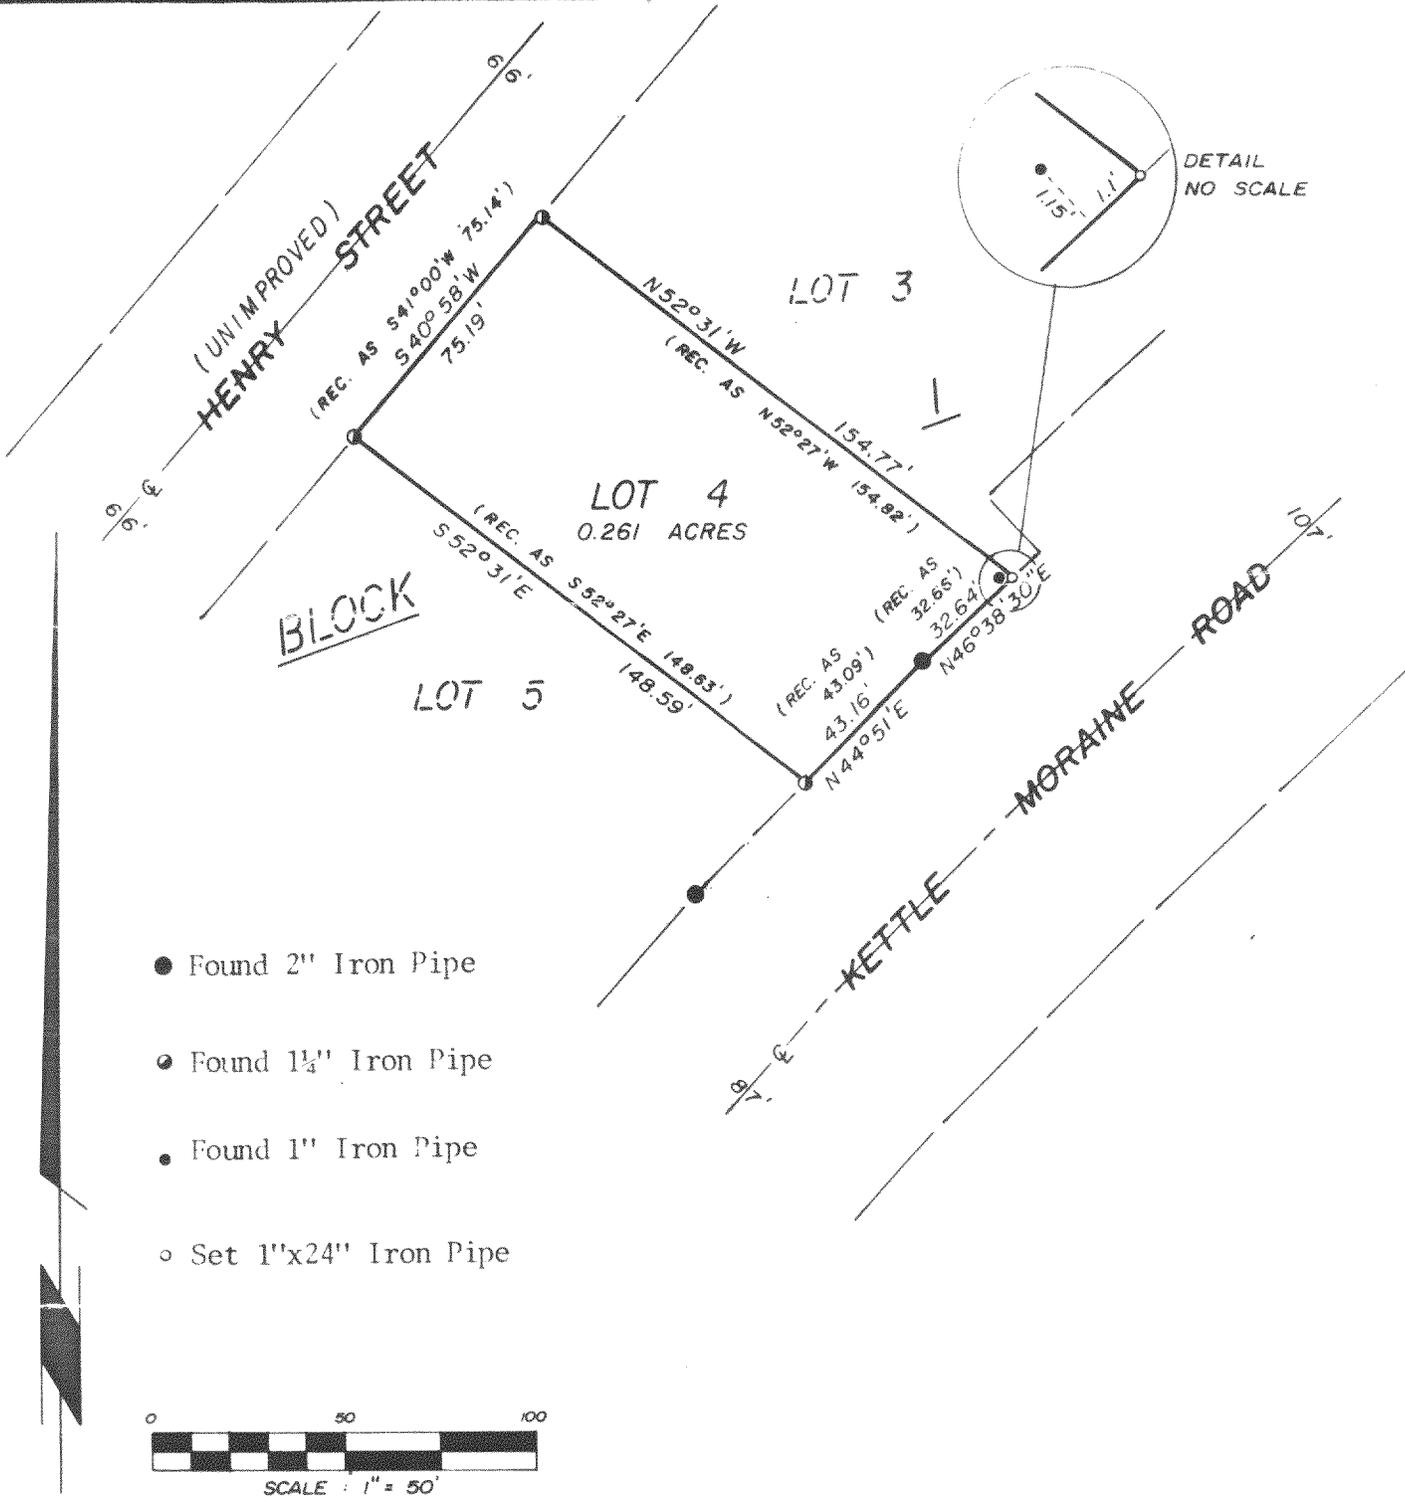

DESCRIPTION

Lot 4, Block 1, INDIAN TRAIL SUBDIVISION in the NE¼ of the SE¼ of Section 27, T4N, R15E, Town of Whitewater, Walworth County, Wisconsin

CERTIFICATION

I certify that the property described above has been surveyed under my responsible direction and supervision and that the above map is a correct representation of the size and location of the property and the location and dimensions of all visible structural improvements, if any.

This survey is made for the exclusive use of the present owners of the property and also those who purchase, mortgage or guarantee the title thereto, and is certified for one year from date hereto.

Date 5-19-80

James B. Woodman
 Registered Land Surveyor, S-1239
 WOODMAN
 S-1239
 FORT ATKINSON,
 WIS.

Prepared for: Rauland Agency
 Attn: Mr. Harry Devitt
 112 South First Street
 Whitewater, WI 53190

JN 80S-42

STRAND & WOODMAN ASSOCIATES
 210 Madison Ave., Fort Atkinson, WI 53538

Land Surveyors & Engineers
 Phone (414) 563-8162

415-221