


PLAT OF SURVEY

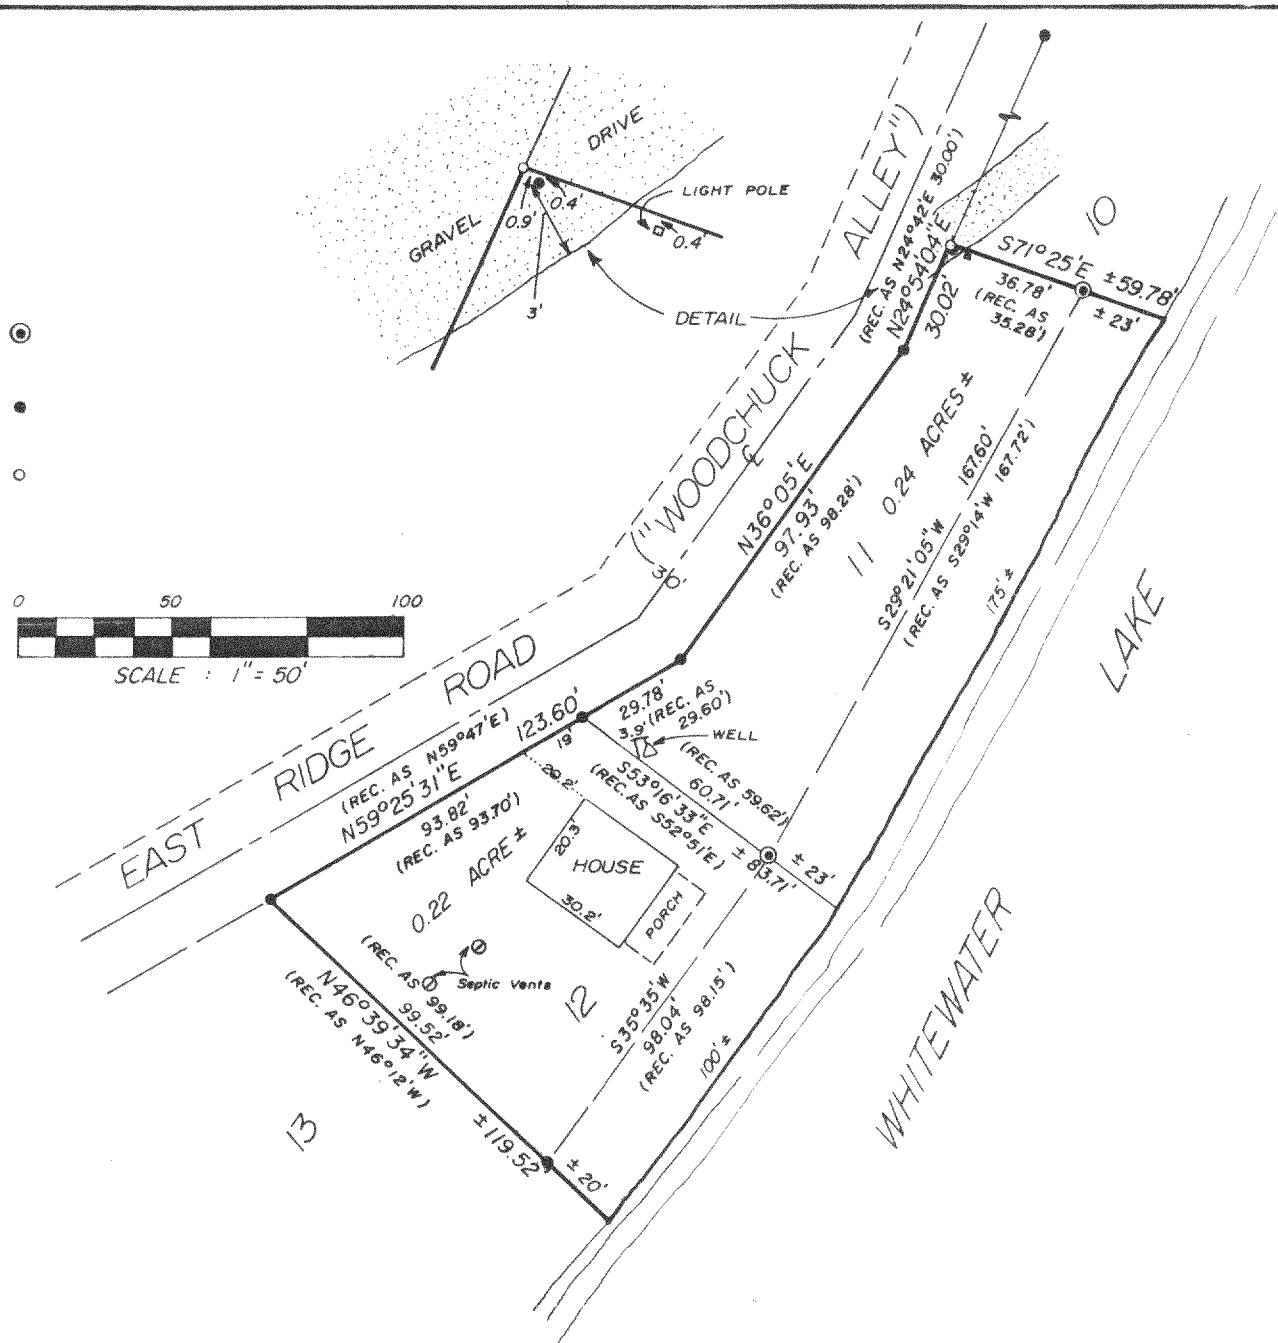

DESCRIPTION


Lot 11 and 12, Block 1, MORaine HEIGHTS in Section 35, T4N, R15E, Town of Whitewater, Walworth County, Wisconsin

CERTIFICATION

I hereby certify that the property described above has been surveyed under my responsible direction and supervision and that this map is a correct representation of the lot lines and dimensions and the principle lines of the permanent structures thereon.

Date 8-19-80

[Signature]
James B. Woodman
Registered Land Surveyor, S-1239

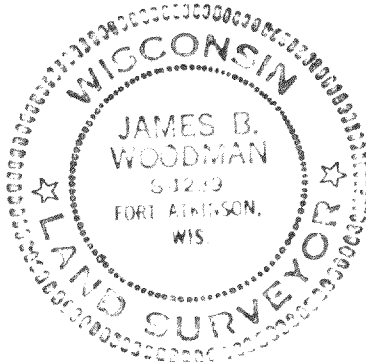

Prepared for: Rauland Agency
Attn: Harry Devitt
112 South First Street
Whitewater, WI 53190

00S-88

STRAND & WOODMAN ASSOCIATES
210 Madison Ave., Fort Atkinson, WI 53538

Land Surveyors & Engineers
Phone (414) 563-8162

DME-H-12

415-222V