

CIRCLE DRIVE · 50' WIDE

106.84' (N 76°28' W 106.80')

80°05'45"

95°20'30"

UNDERGROUND TELEPHONE CABLE PEDESTAL POWER POLE

GRAVEL

POWER LINES

TENNIS COURT

108'

206.78' (N 3°39' E 206.85')

28.9'

24.0'

CONC. PATIO

19.8'

5.5'

38.4'

HOUSE

30.4'

38.4'

6.7'

30.4'

1.7'

BLACKTOP DRIVE

POWER LINES

184°06'45"

POWER POLE

10' SETBACK LINE

POWER LINES

ROAD

24.0'

30.0'

PROPOSED GARAGE

24.00'

10.0'

15.9'

28.2'

62°52'55"

122.18'

(N 4°08' E 121.80')

107.22'

(N 58°49' W)

10' SETBACK LINE

117°34'05"

TOWNLINE ROAD · 66' WIDE

N

SCALE: 1" = 20'

LEGEND

○ - IRON PIPE FOUND

○ - IRON PIPE PLACED

● - CONCRETE MONUMENT

x - SPIKE


() - AS PLATTED

□ - WOOD STAKE

POWER POLE

UNDERGROUND CABLE PEDES

ACCURACY: DISTANCES; $\pm 0.01'$
 ANGLES; $\pm 05''$
 ERROR OF CLOSURE: LESS THAN ONE
 PART IN 3,000

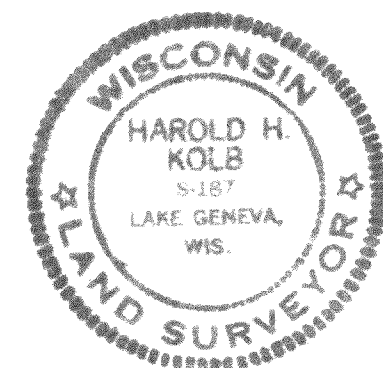

Harold H. Kolb
 HAROLD H. KOLB
 WISCONSIN REGISTERED LAND SURVEYOR, S-187
 DATE *JUNE 29, 1976*
 REVISED: OCT. 3, 1980

LEGEND

- — IRON PIPE FOUND
- — IRON PIPE PLACED
- — CONCRETE MONUMENT
- X — SPIKE
- { } — AS PLATTED
- — WOOD STAKE

44-1547

DCH-1