



Plat of Survey

Survey For
Location

First State Savings of Wisconsin
5412 Lower Ridge Road

Description

LOT 1 in BLOCK 1 in MOHAWK HEIGHTS SUBDIVISION, located in the S.W. 1/4 of the S.E. 1/4 of Section 26, and the S.W. 1/4 of Section 35, and the S.E. 1/4 of Section 36, and the S.W. 1/4 of Section 35, T. 1 N., R. 15 E., Walworth County, as recorded in the Register of Deeds office in and for the County of Walworth, on the 20th day of October, 1948, Vol. 12 of Plats on page 19, 20 and 21.

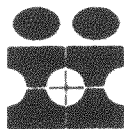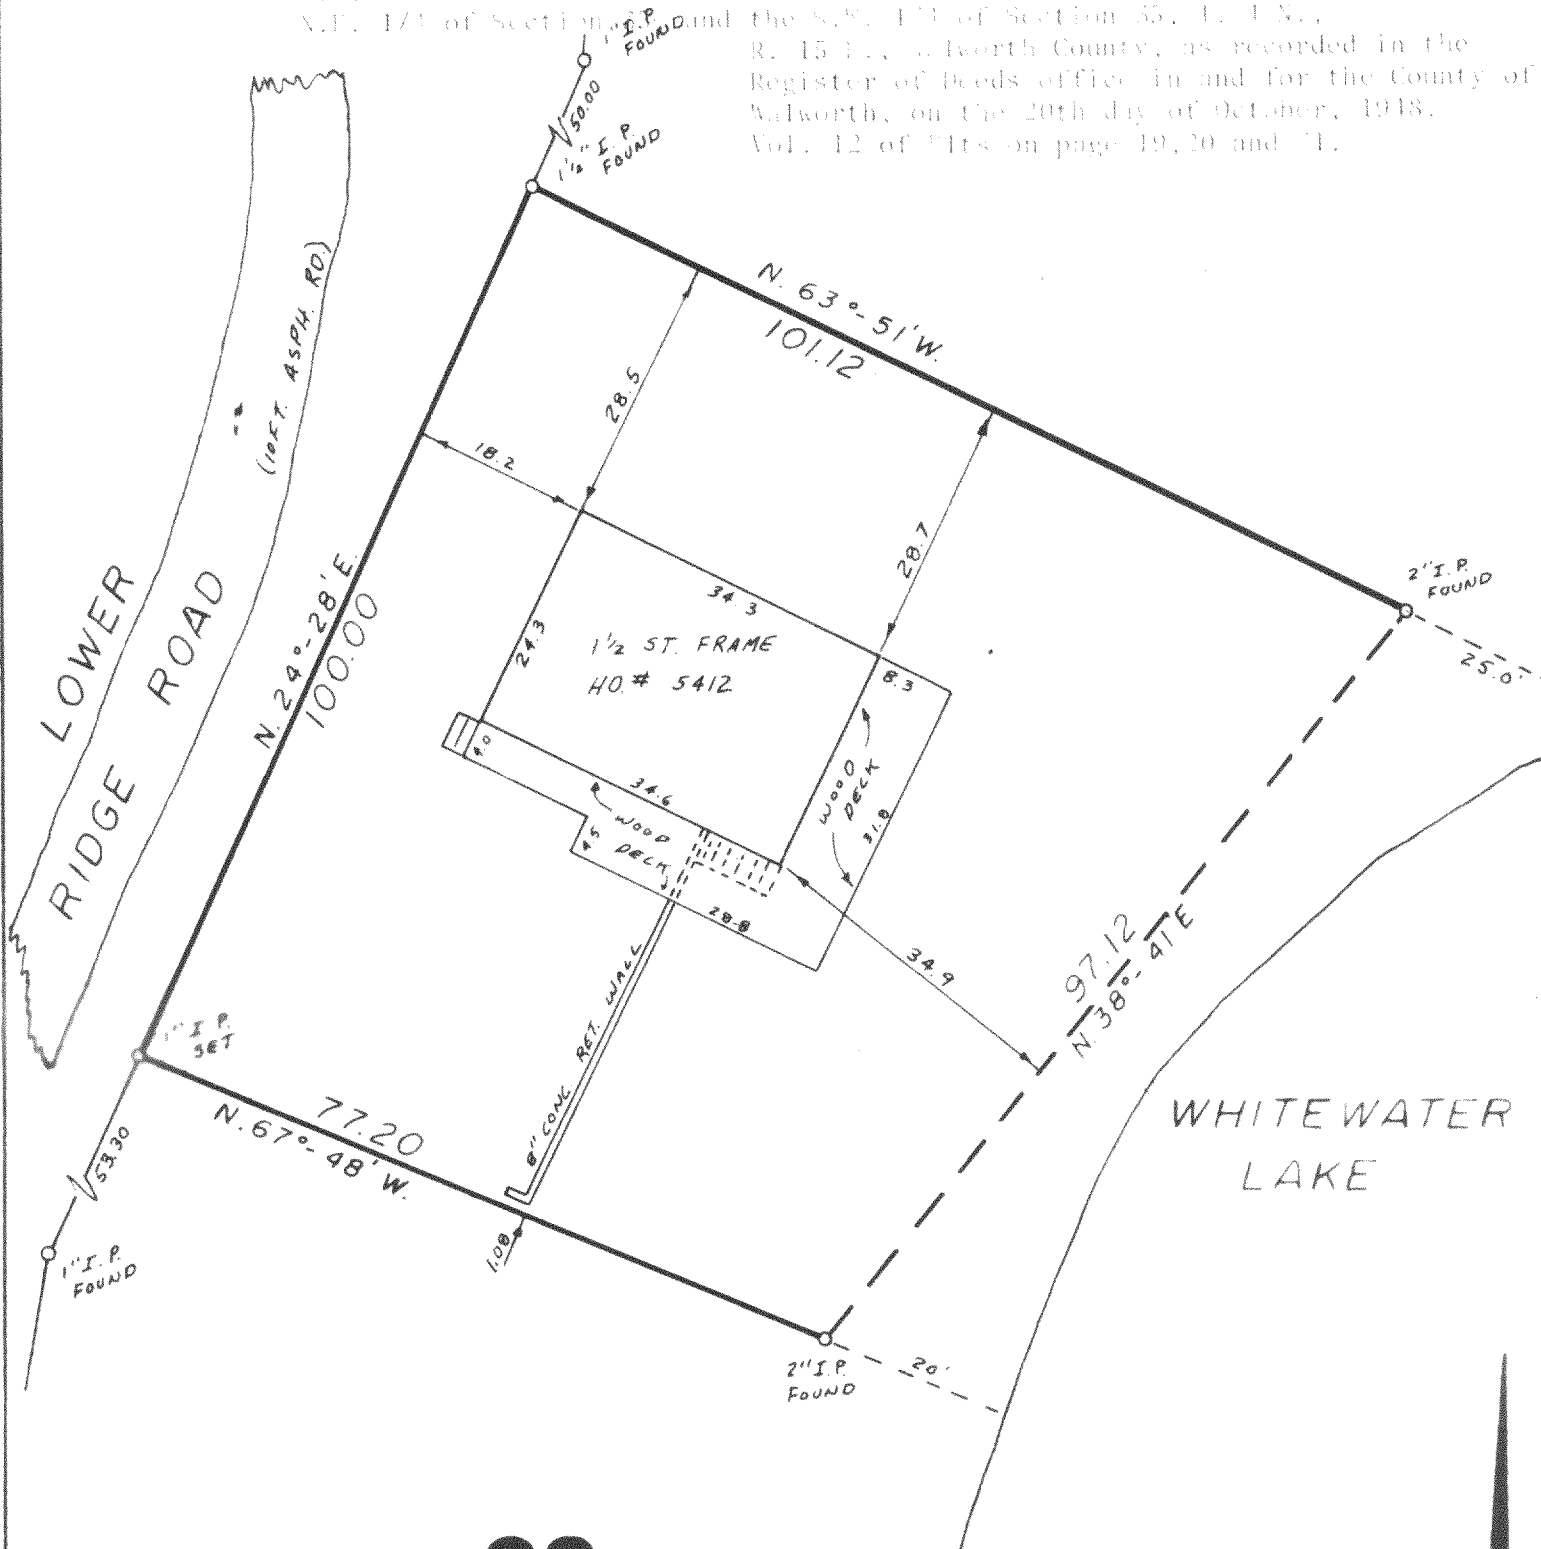

INMAN SURVEY

WEST OFFICE:
P.O. BOX 286
EAST TROY, WI 53120
(414) 642-3113

EAST OFFICE:
11221 W. FOREST HOME AVE
MILWAUKEE, WI 53130
(414) 425-2060

Scale 1" = 20'

SURVEY CERTIFICATE

State of Wisconsin) ss I certify that I have surveyed the above described (property) and the above map is a true
Milwaukee County representation thereof and shows the size and location of the Property, its exterior boundaries, the location and
dimensions of all visible structures thereon, fences, apparent easements and roadways and visible encroach-
ments, if any.

This survey is made for the exclusive use of the present owners of the Property, and also those who purchase,
mortgage, or guarantee the title thereto within one (1) year from date hereof;

Thomas Inman
THOMAS INMAN, Registered Land Surveyor

DATE: 11-30-82
JOB NO.: 9987




Plat of Survey

Survey For
Location

First State Savings of Wisconsin
5112 Lower Ridge Road

Description:

LOT 1 in BLOCK 1 in MORaine HEIGHTS SUBDIVISION, located in the S.W. 1/4 of the S.E. 1/4 of Section 16, and the S.W. 1/4 of Section 36, and the N.E. 1/4 of Section 16 and the S.E. 1/4 of Section 36, T. 15 N., R. 13 E., Walworth County, as recorded in the Register of Deeds office in and for the County of Walworth, on the 20th day of October, 1993, Vol. 12 of "Trs" on page 19, 20 and 21.

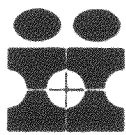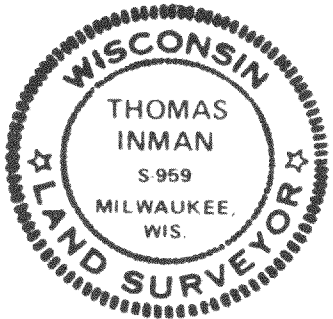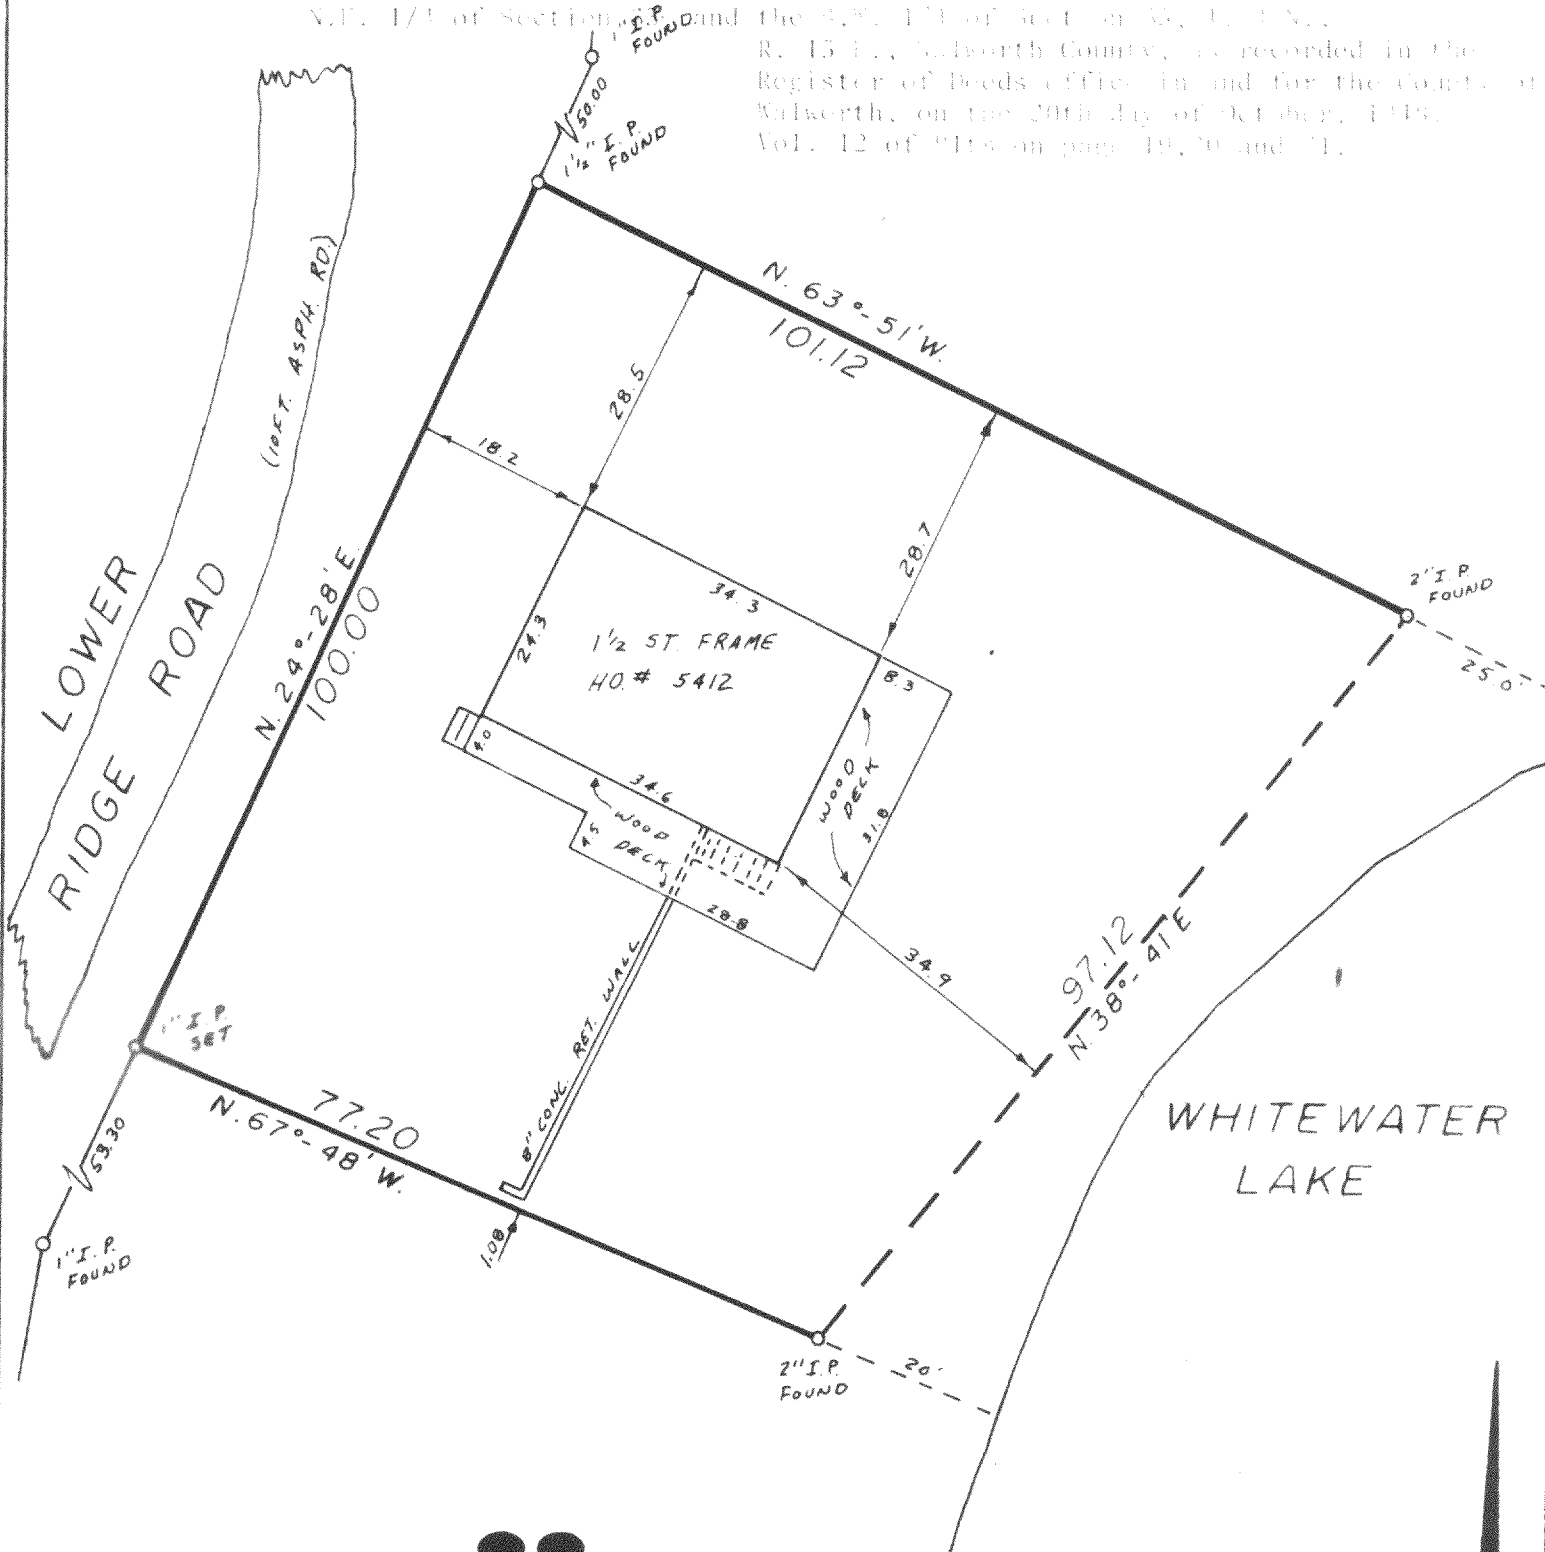

INMAN SURVEY

WEST OFFICE:
P.O. BOX 286
EAST TROY, WI 53120
(414) 642-3113

EAST OFFICE:
11221 W. FOREST HOME AVE
MILWAUKEE, WI 53136
(414) 425-2060

Scale 1" = 20'

SURVEY CERTIFICATE

State of Wisconsin)
Milwaukee County ss I certify that I have surveyed the above described (property) and the above map is a true representation thereof and shows the size and location of the Property, its exterior boundaries, the location and dimensions of all visible structures thereon, fences, apparent easements and roadways and visible encroachments, if any.

This survey is made for the exclusive use of the present owners of the Property, and also those who purchase, mortgage, or guarantee the title thereto within one (1) year from date hereof.

Thomas Inman
THOMAS INMAN, Registered Land Surveyor

DATE: 11-30-82
JOB NO.: 9987




Plat of Survey

Survey For
Location

First State Savings of Wisconsin
5112 Lower Ridge Road

Description

LOT 1 in BLOCK 1 in MORaine HEIGHTS SUBDIVISION, located in the N.W. 1/4 of the S.E. 1/4 of Section 26, and the N.W. 1/4 of Section 35, and the N.E. 1/4 of Section 36 and the S.W. 1/4 of Section 35, T. 1 N., R. 15 E., Walworth County, as recorded in the Register of Deeds office in and for the County of Walworth, on the 20th day of October, 1948, Vol. 12 of Plats on page 19, 20 and 21.

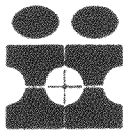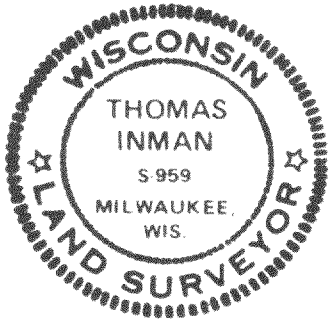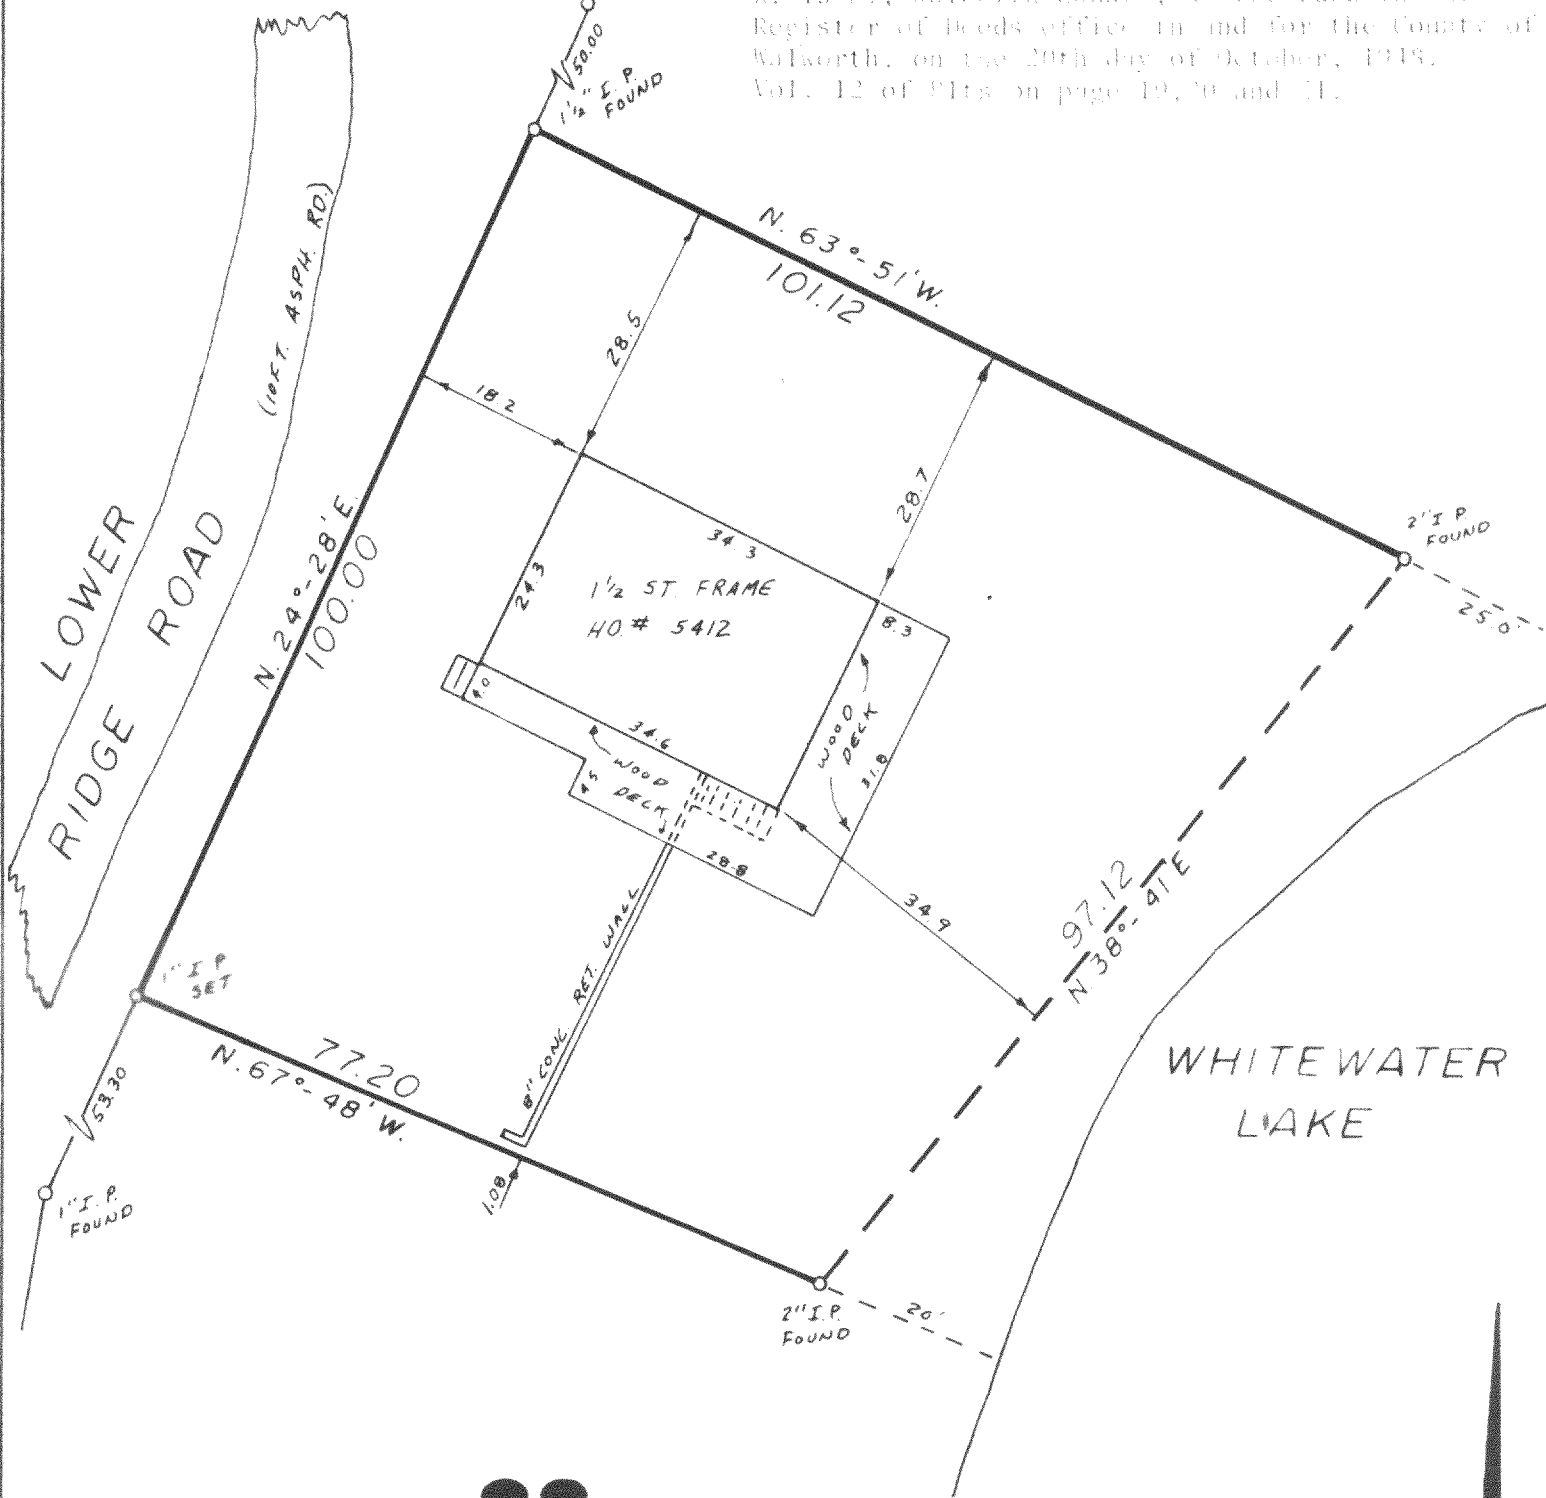

INMAN SURVEY

WEST OFFICE:
P.O. BOX 286
EAST TROY, WI 53120
(414) 642-3113

EAST OFFICE:
11221 W. FOREST HOME AVE
MILWAUKEE, WI 53130
(414) 425-2060

Scale 1" = 20'

SURVEY CERTIFICATE

State of Wisconsin) ss
Milwaukee County I certify that I have surveyed the above described (property) and the above map is a true representation thereof and shows the size and location of the Property, its exterior boundaries, the location and dimensions of all visible structures thereon, fences, apparent easements and roadways and visible encroachments, if any.

This survey is made for the exclusive use of the present owners of the Property, and also those who purchase, mortgage, or guarantee the title thereto within one (1) year from date hereof;

Thomas Inman
THOMAS INMAN, Registered Land Surveyor

DATE: 11-30-82
JOB NO.: 9987

415-227-1