


PLAT OF SURVEY
OF
LOT 3 BLOCK 2 GUTZMERS SUBD.
LOCATED IN SECTION 25, TAN RISE
WIAL. CO. WIS.

WHITEWATER LAKE

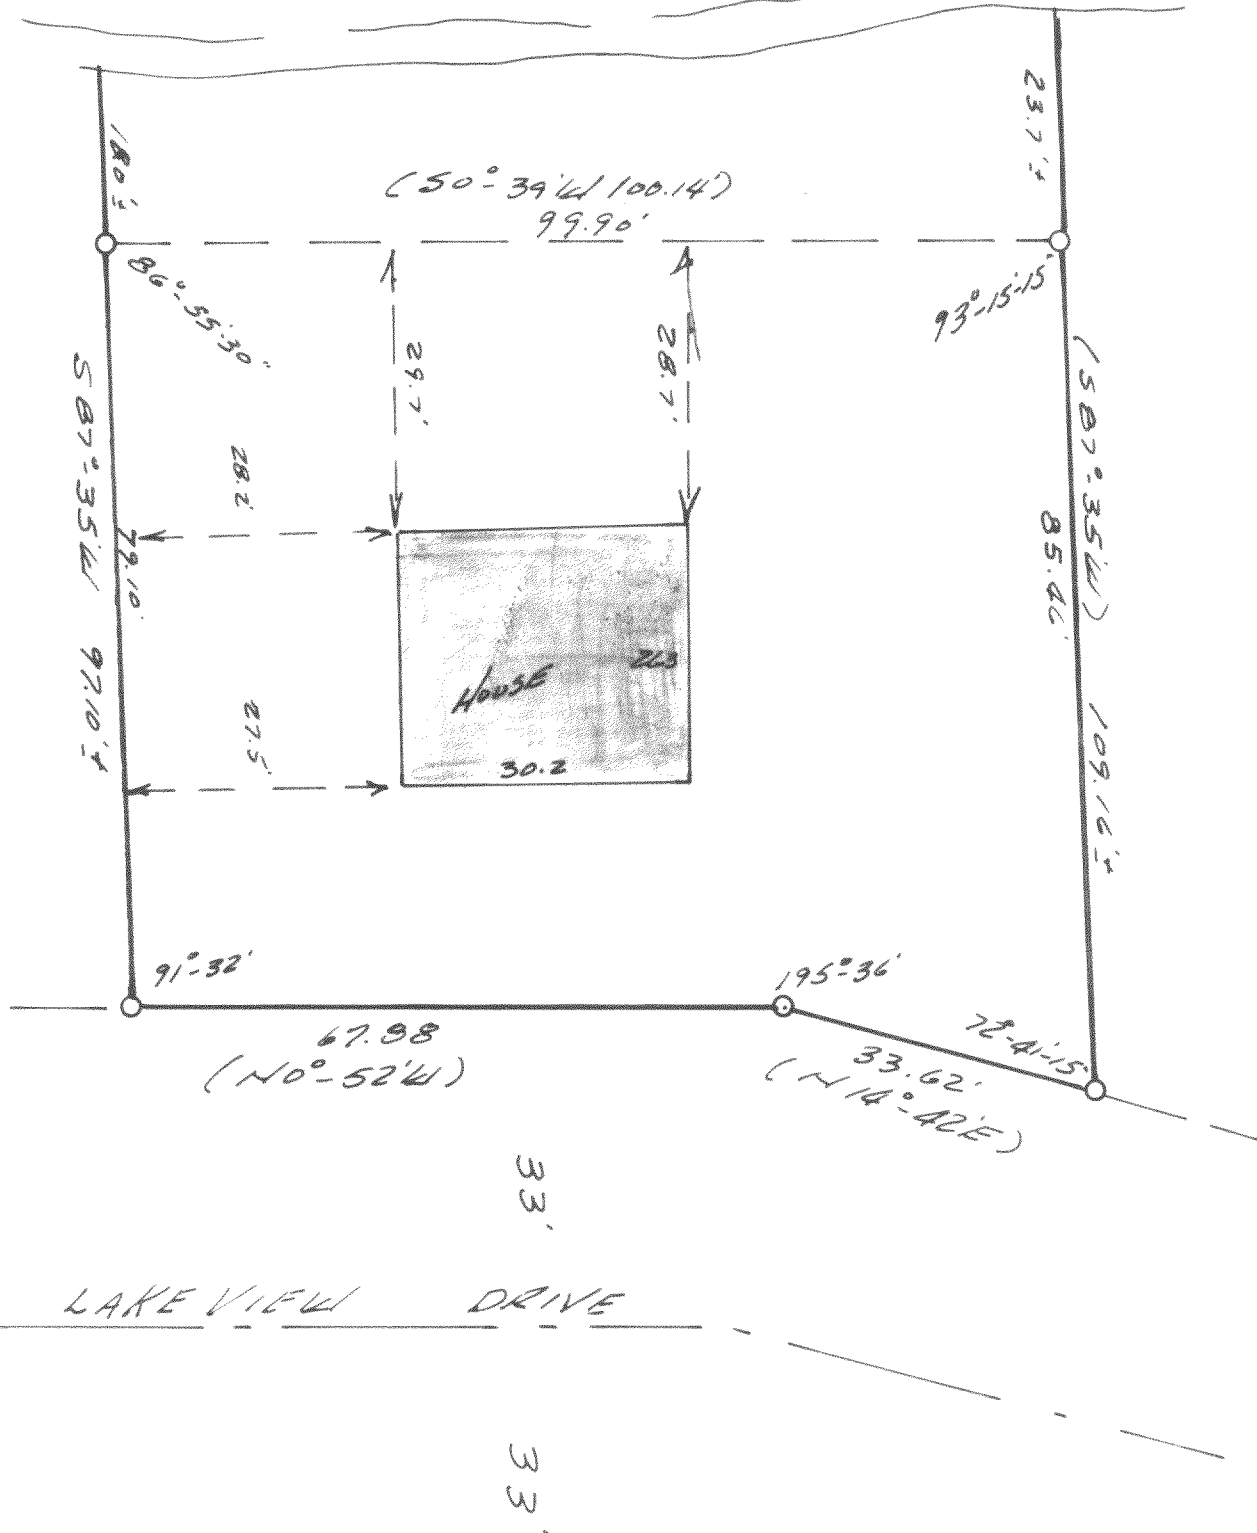

LENSEN SURVEYING & MAPPING INC.
ELKHORN, WIS.

THOMAS P.A. LENSEN
THOMAS P.A. LENSEN

JUNE 23, 1983

ASSUMED FROM PLAT NORTH

SURVEYED FOR JERRY PARRA
6130 N. NAGLE
CHIC. ILL. 60646

415-236-J

I HEREBY CERTIFY THAT I HAVE SURVEYED THE ABOVE DESCRIBED PROPERTY AND THAT THE ABOVE MAP IS A TRUE REPRESENTATION THEREOF. I SHOWS THE SIZE & LOCATION OF THE PROPERTY, ITS EXTERIOR BOUNDARIES, THE LOCATION OF ALL VISIBLE STRUCTURES, & DIMENSIONS OF ALL PRINCIPAL BLDGS. THEREON, BOUNDARY LINES, APPARENT EASEMENTS, EROSIONS, & VISIBLE ENCROACHMENTS, IF ANY.

THIS SURVEY IS MADE FOR THE USE OF THE PRESENT OWNERS OF THE PROPERTY, AND ALSO THOSE WHO PURCHASE, MORTGAGE, OR GUARANTEE THE TITLE THEREIN WITHIN ONE YEAR FROM DATE HEREOF.

SCALE
1" = 20'
IRON PIPE
FOUND

D65-12