


PLAT OF SURVEY

of
Lot 10 Country Acres, a subdivision located in the NW 1/4
 of Section 25, T4N, R15E, Town of Whitewater, Walworth County, Wisconsin.

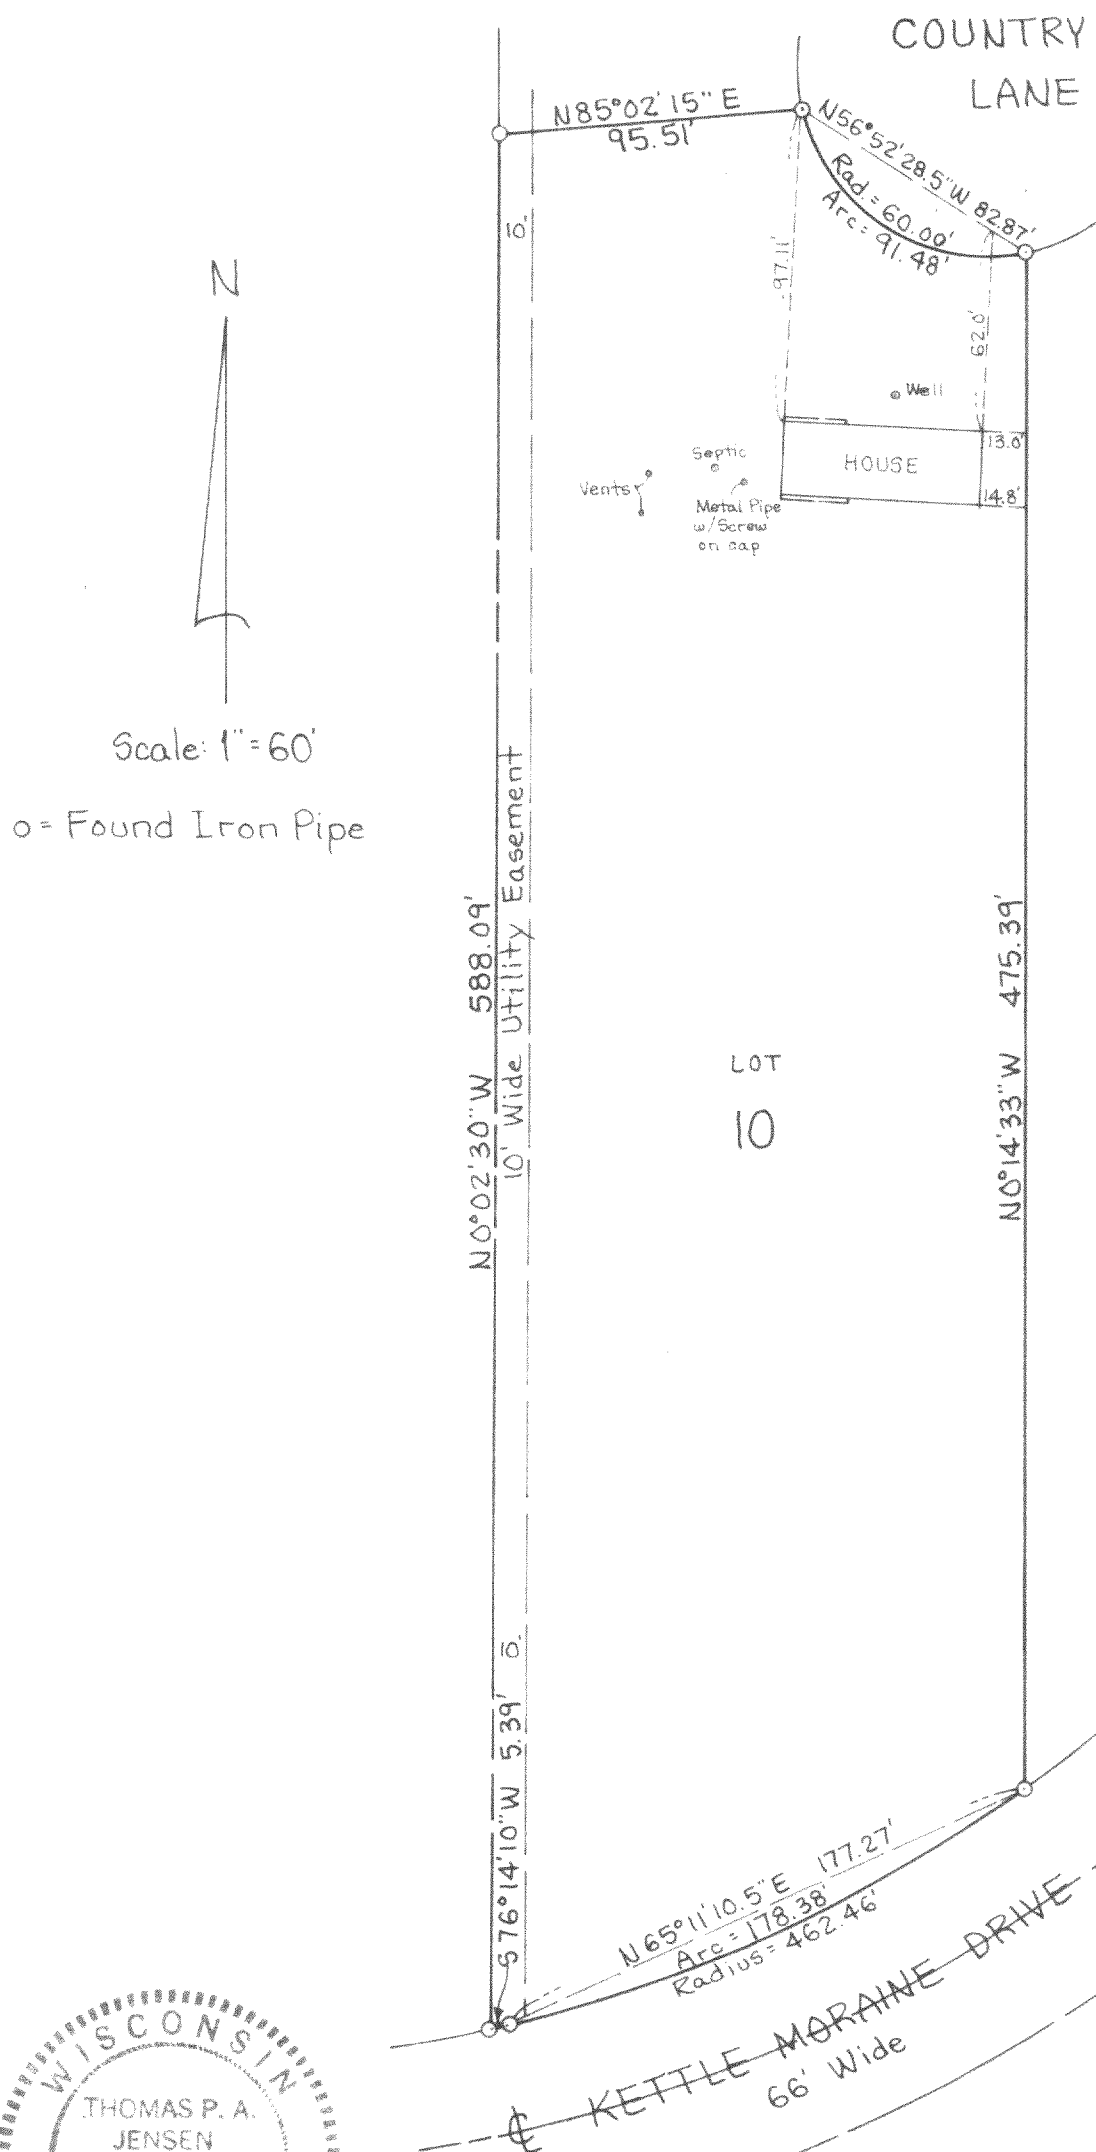


Scale: 1" = 60'

o = Found Iron Pipe

Surveyed for:
 David Starks
 Rt. 2
 Whitewater, Wi. 53190
 Phone: (414) 473-8057

Surveyed by:
 Jensen Surveying & Mapping, S.C.
 P.O. Box 322
 Elkhorn, Wi. 53121
 Phone: (414) 723-3434

Mapping date:
 April 17, 1984

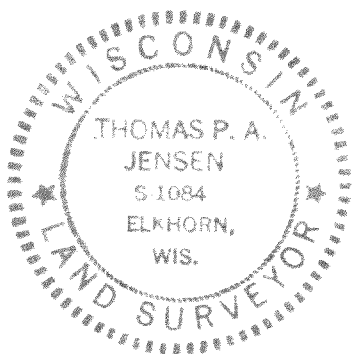

I hereby certify that the above described property has been surveyed under my direction, that the plat shown hereon is an accurate survey, a true representation thereof, correctly shows the exterior boundary lines on said property and the correct measurements thereof and buildings thereon.

Thomas P. A. Jensen
 THOMAS P. A. JENSEN

