


PLAT OF SURVEY

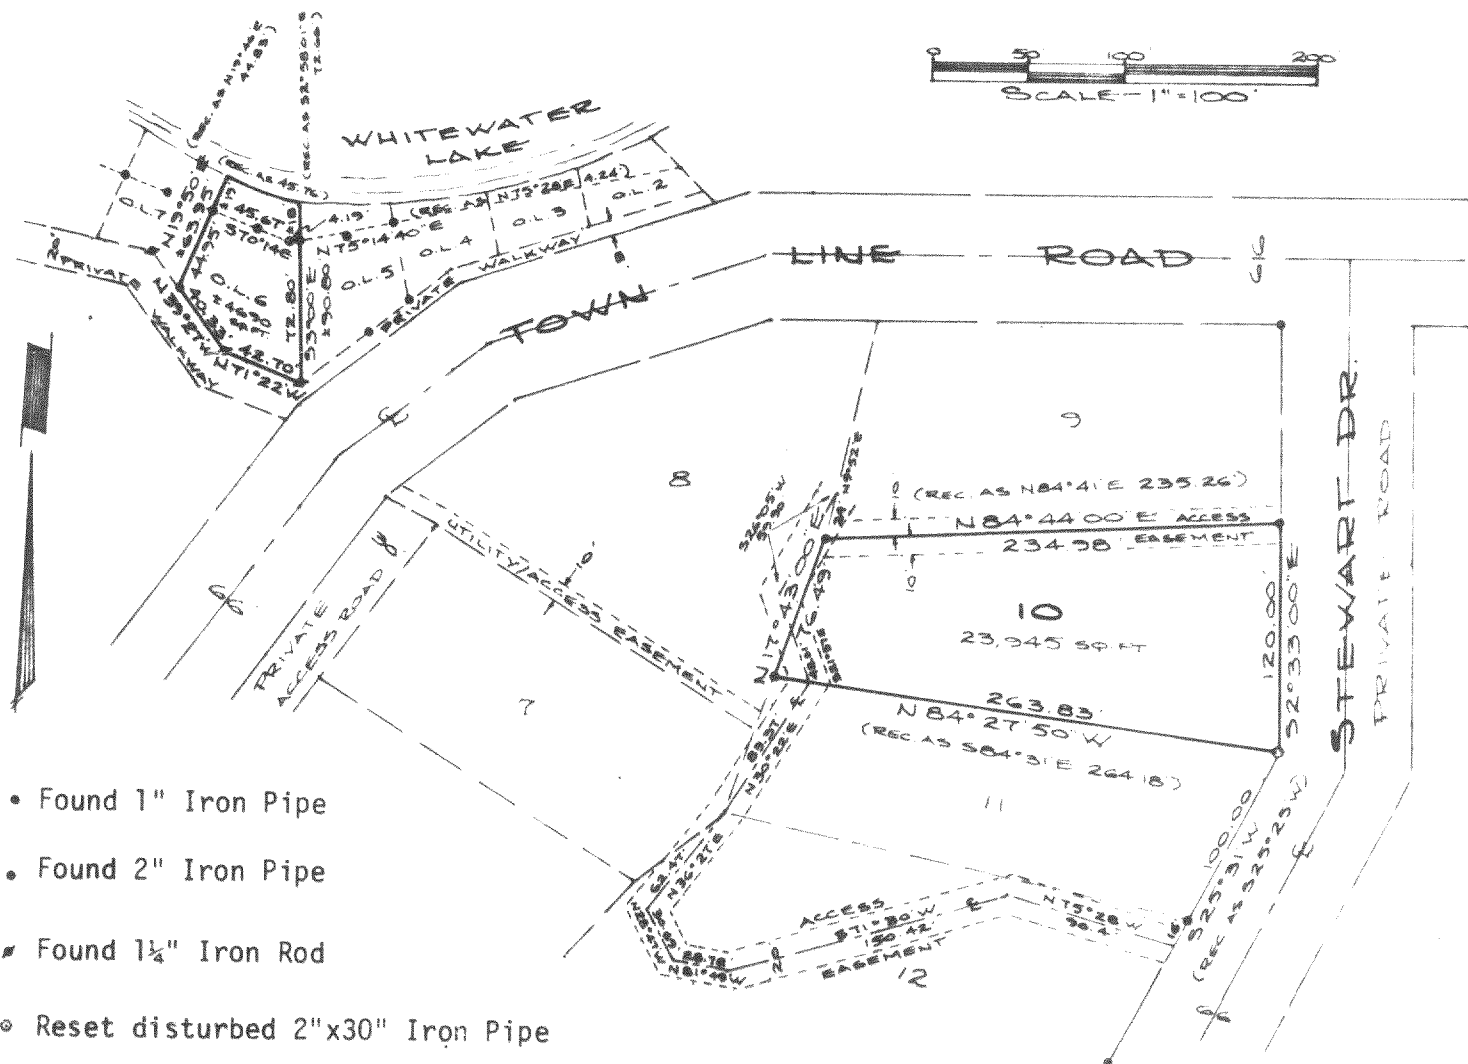

DESCRIPTION

Lot 10, STEWART RIDGE and Outlot 6, A RESUBDIVISION OF LOT 17, STEWART RIDGE SUBDIVISION in the SW 1/4 of Section 35, T4N, R15E, Town of Whitewater, Walworth County, Wisconsin, together with and subject to easements shown as recorded in Volume 330 pages 671 and 672.


CERTIFICATION

I hereby certify that the property described above has been surveyed under my responsible direction and supervision and that this map is a correct representation of the lot lines and dimensions and the principle lines of the permanent structures thereon.

Date 12-17-84

James B. Woodman
Registered Land Surveyor, S-1239

Prepared for: Luchini Shelters
RR#2 E. Lake Shore Drive
Whitewater, WI 53190

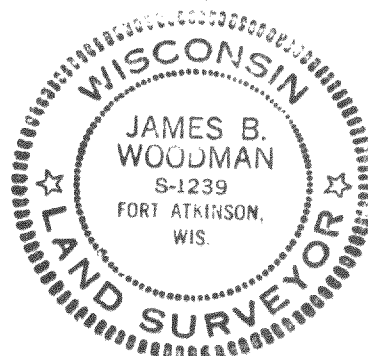

DSR-00010, DSR-00021

Sheet 1 of 1

JN 84S-155

JAMES B. WOODMAN & ASSOCIATES
210 Madison Avenue, Fort Atkinson, WI 53538

Registered Land Surveyors
Phone (414) 563-8162 415-242