


FARRIS, HANSEN & ASSOCIATES INC. ELTHORN WISCONSIN

O = IRON PIPE SURVEY STK. FOUND
(XXX) = RECORD DIMENSION

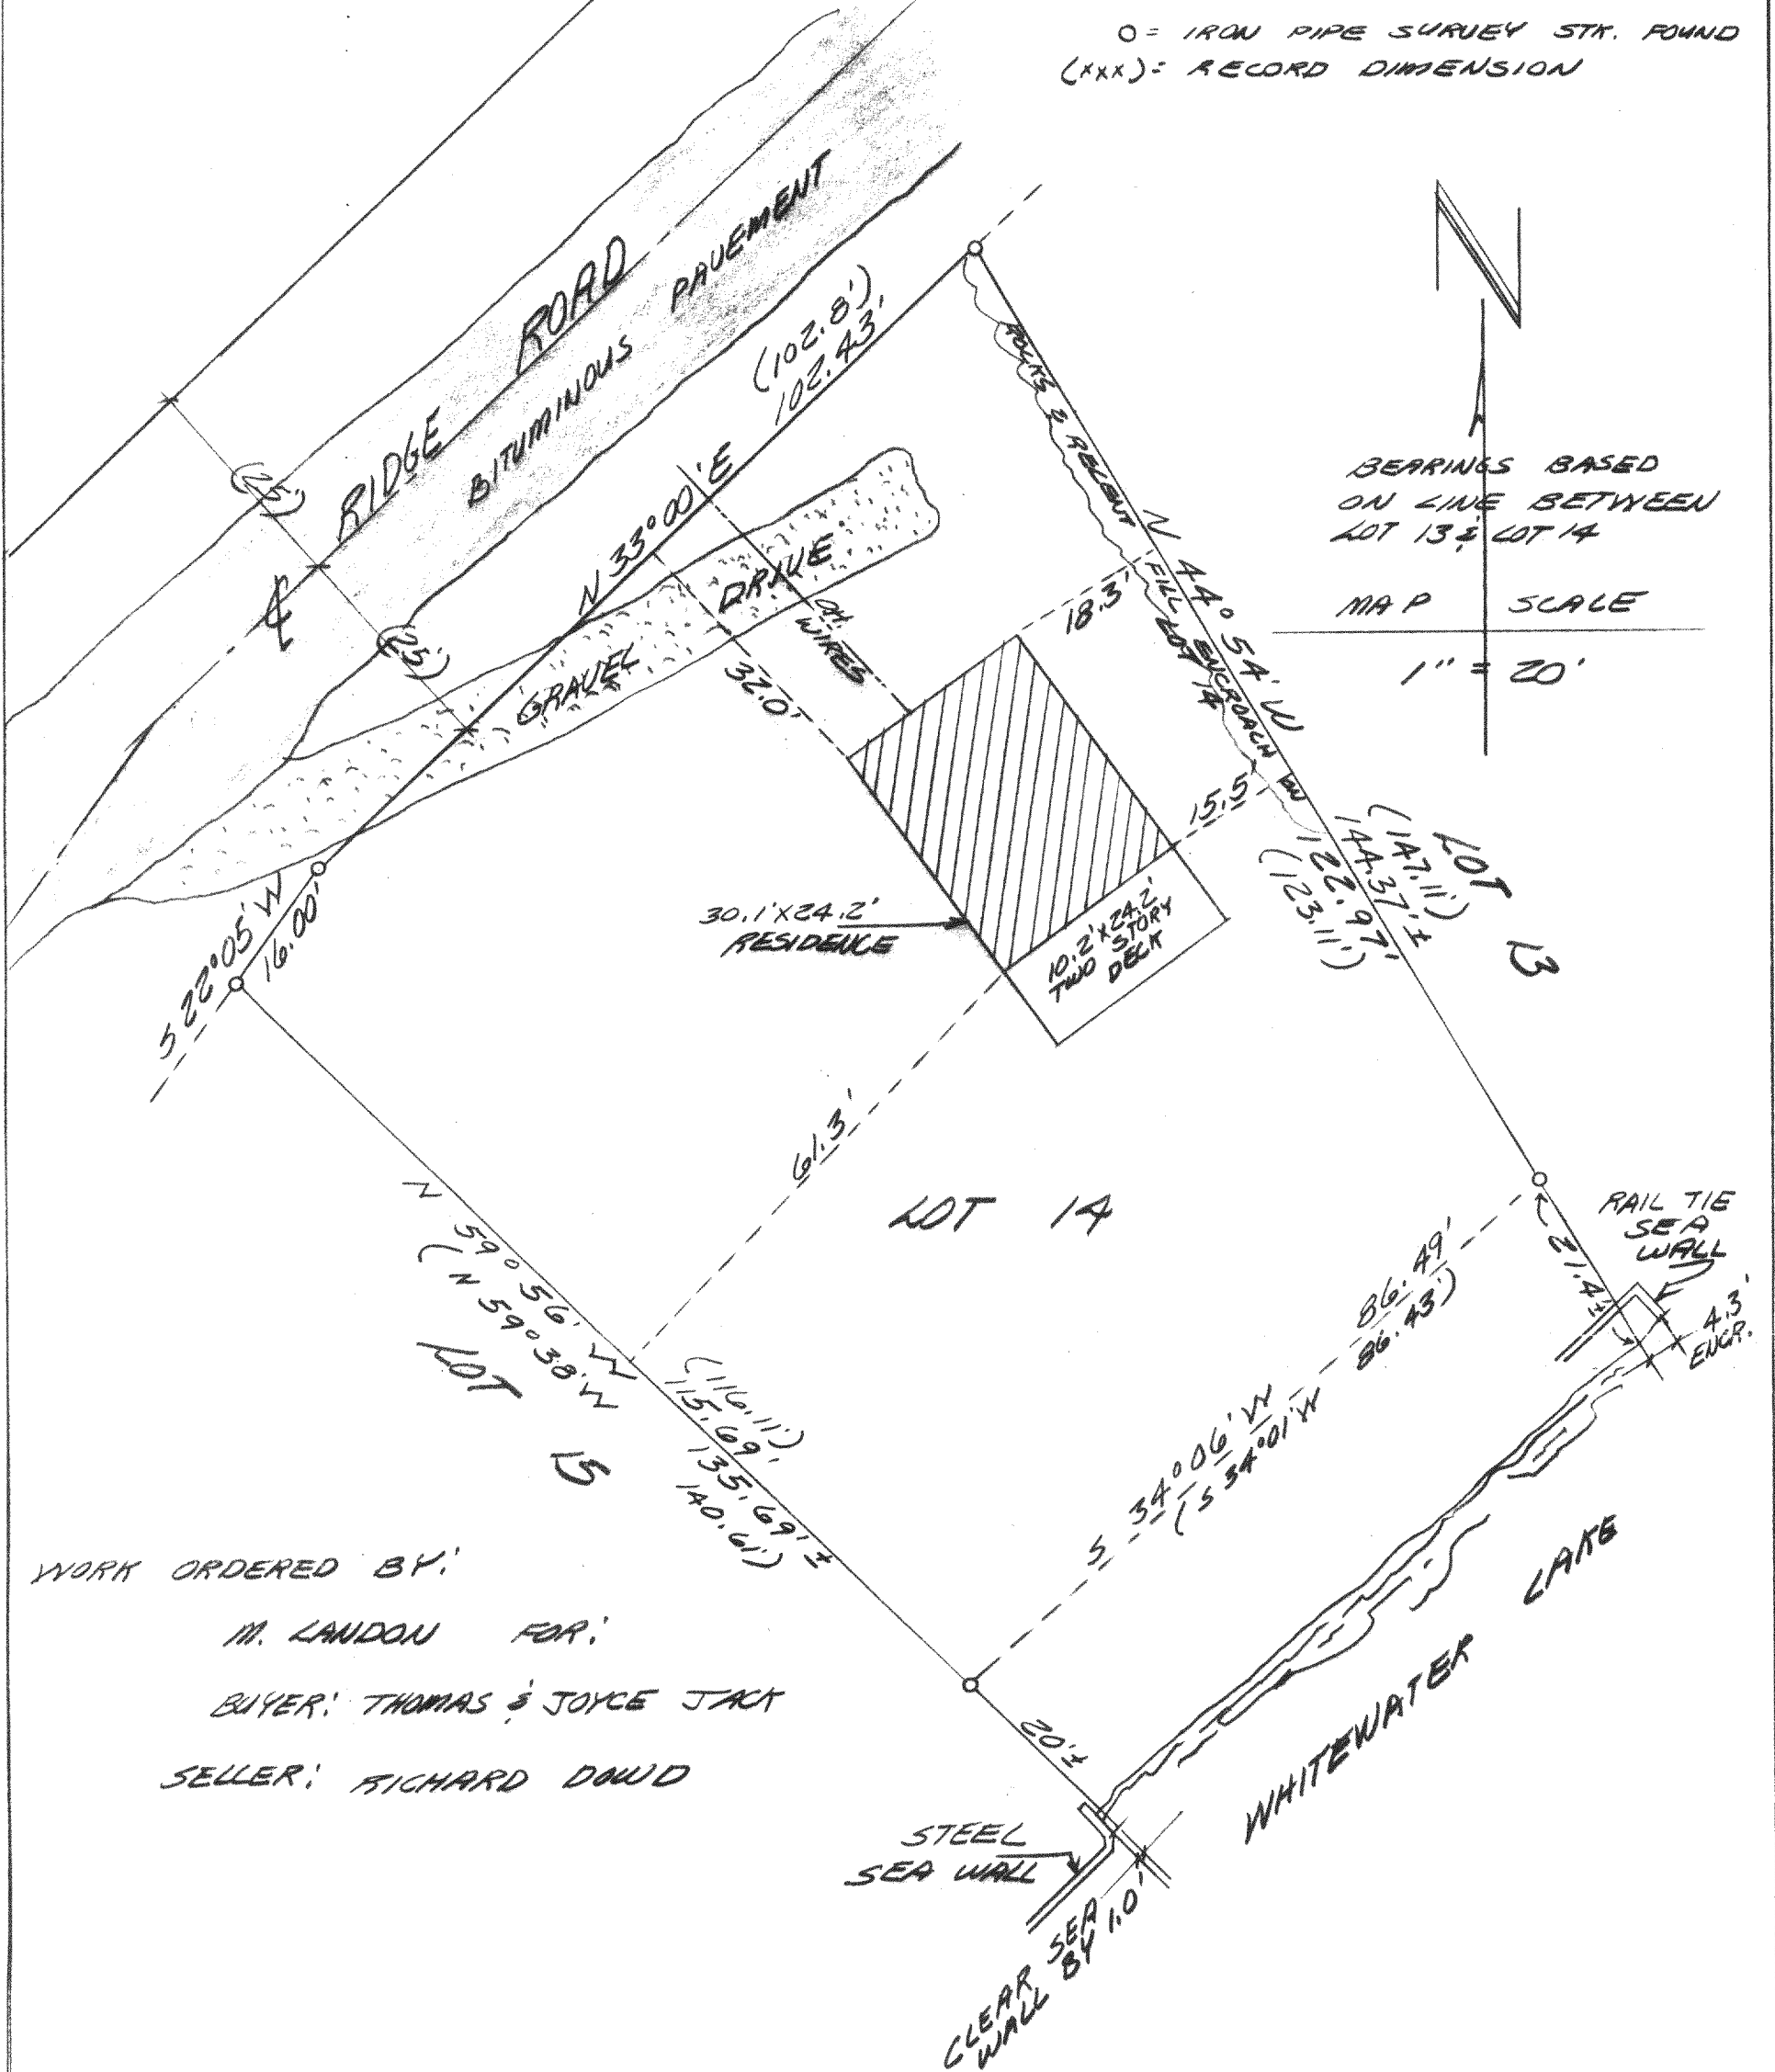

WORK ORDERED BY:


M. LANDON FOR:

BUYER: THOMAS & JOYCE JACK

SELLER: RICHARD DAUD

PLAT OF SURVEY OF LOT 14, BLOCK 1 MORaine HEIGHTS SUBDIVISION IN SEC. 35, T. 4 N., R. 15 E., TOWN OF WHITEWATER, WALWORTH COUNTY, WISCONSIN

I hereby certify that I have surveyed the above described property and that the above map is a true representation thereof and shows the size and location of the property, its exterior boundaries, the location of all visible structures and dimensions of all principal buildings thereon, boundary fences, apparent easements, roadways and visible encroachments, if any.
This survey is made for the use of the present owners of the property, and also those who purchase, mortgage, or guarantee the title thereto within one (1) year from date hereof.

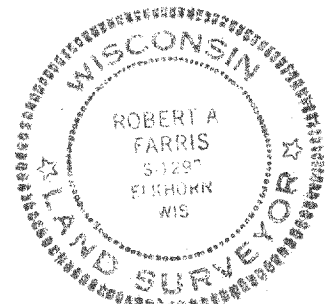

DATED 5/23/85

PROJECT 1612-A