
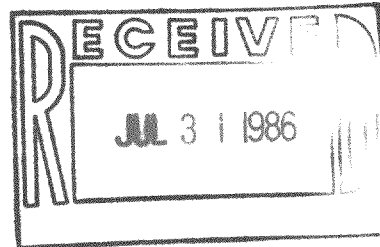


PLAT OF SURVEY AND FOUNDATION RECERTIFICATION
FOR
EDWARD LANGE
OF

Lot 2 of Walworth County Certified Survey Map No. 1480 as recorded in Volume 7 of Certified Survey Maps on page 56 in the office of the Register of Deeds for Walworth County, said land being located in the Southwest 1/4 of the North-

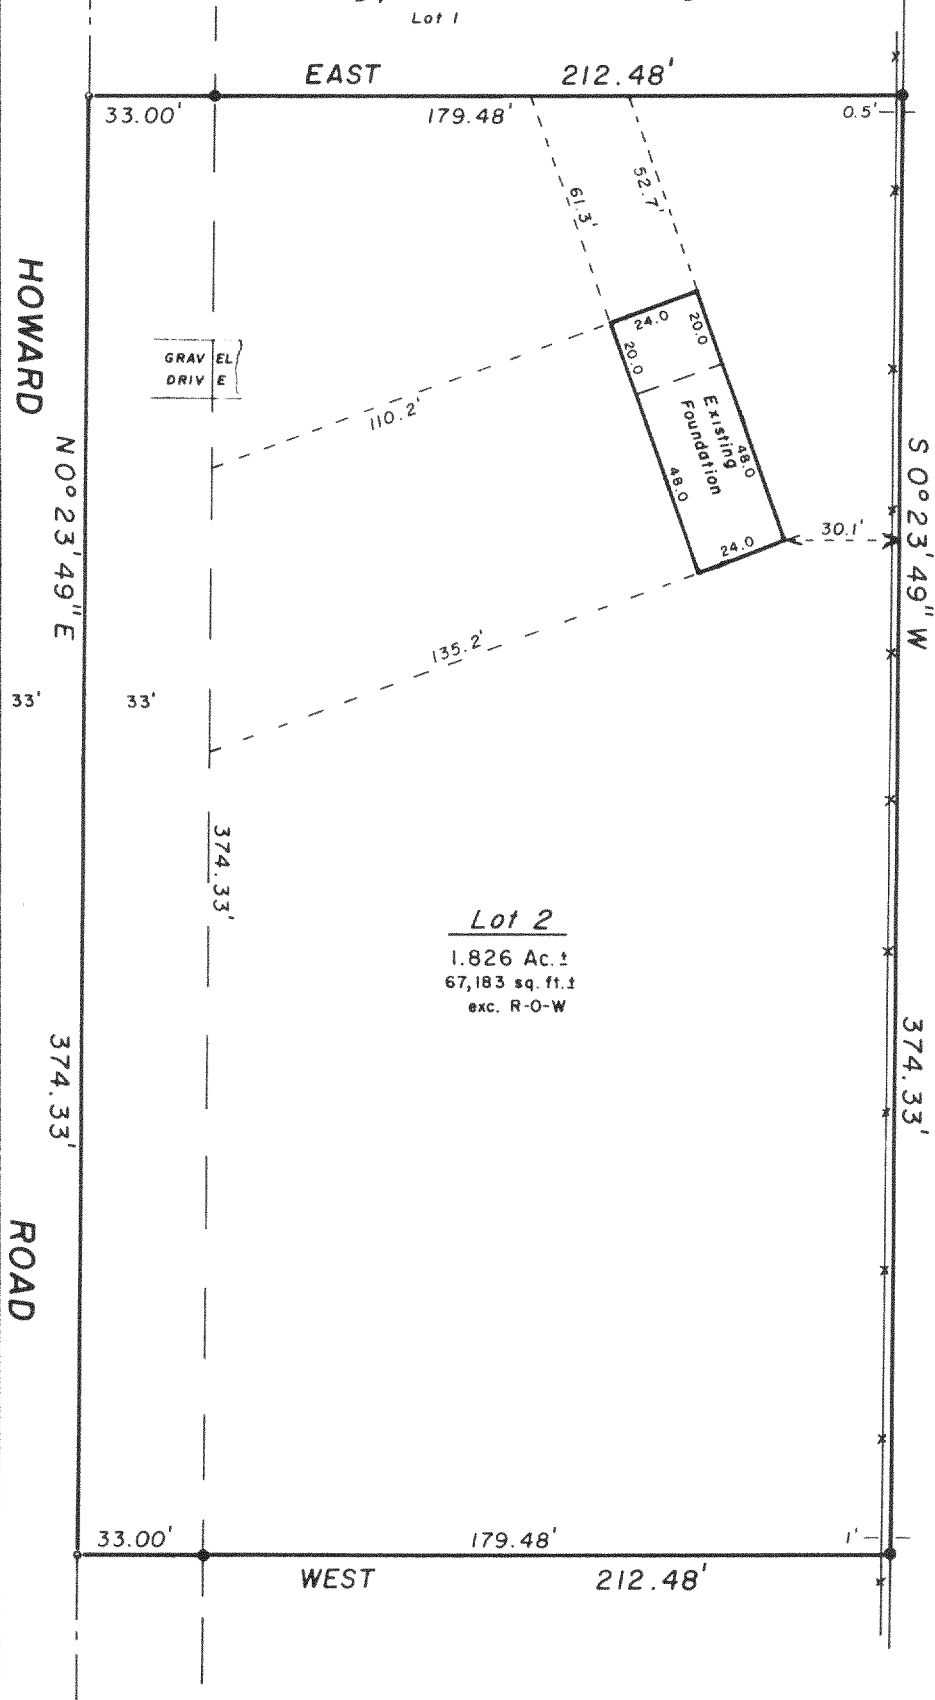


Bearings are based on
the recorded map.

"I hereby certify that I have surveyed the above described property and that the above map is a true representation thereof and shows the size and location of the property, its exterior boundaries, the location of all visible structures and dimensions of all principal buildings thereon, boundary fences, apparent easements, roadways and visible encroachments, if any.

"This survey is made for the use of the present owners of the property, and also those who purchase, mortgage, or guarantee the title thereto within one year from date hereof."

NO MONUMENTATION HAS BEEN WAIVED IN ACCORDANCE
WITH A-E 5.01(b) OF THE WISCONSIN ADMINISTRATIVE
CODE.

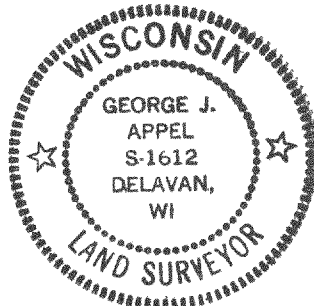

LEGEND

- + CHISEL CUT IN CONCRETE
 o PK NAIL FOUND
 ● FOUND IRON PIPE - 1"
 FOUND IRON PIPE -
 ○ SET IRON PIPE -
 FOUND BRASS CAPPED MONUMENT
 FOUND CONCRETE MONUMENT
 FENCE
 () RECORDED AS
 / EXISTING GROUND ELEVATION

SCALE - 1" = 50'

415-248 ✓

86156

7/2/86

DATE _____

FIELD WORK BY GJA, GS

DRAWN BY GJA

JOB NUMBE