


D.D. COOPER & CO. INC.

Route 4 Box 5088
Elkhorn WI 53121
Phone 414-723-6265

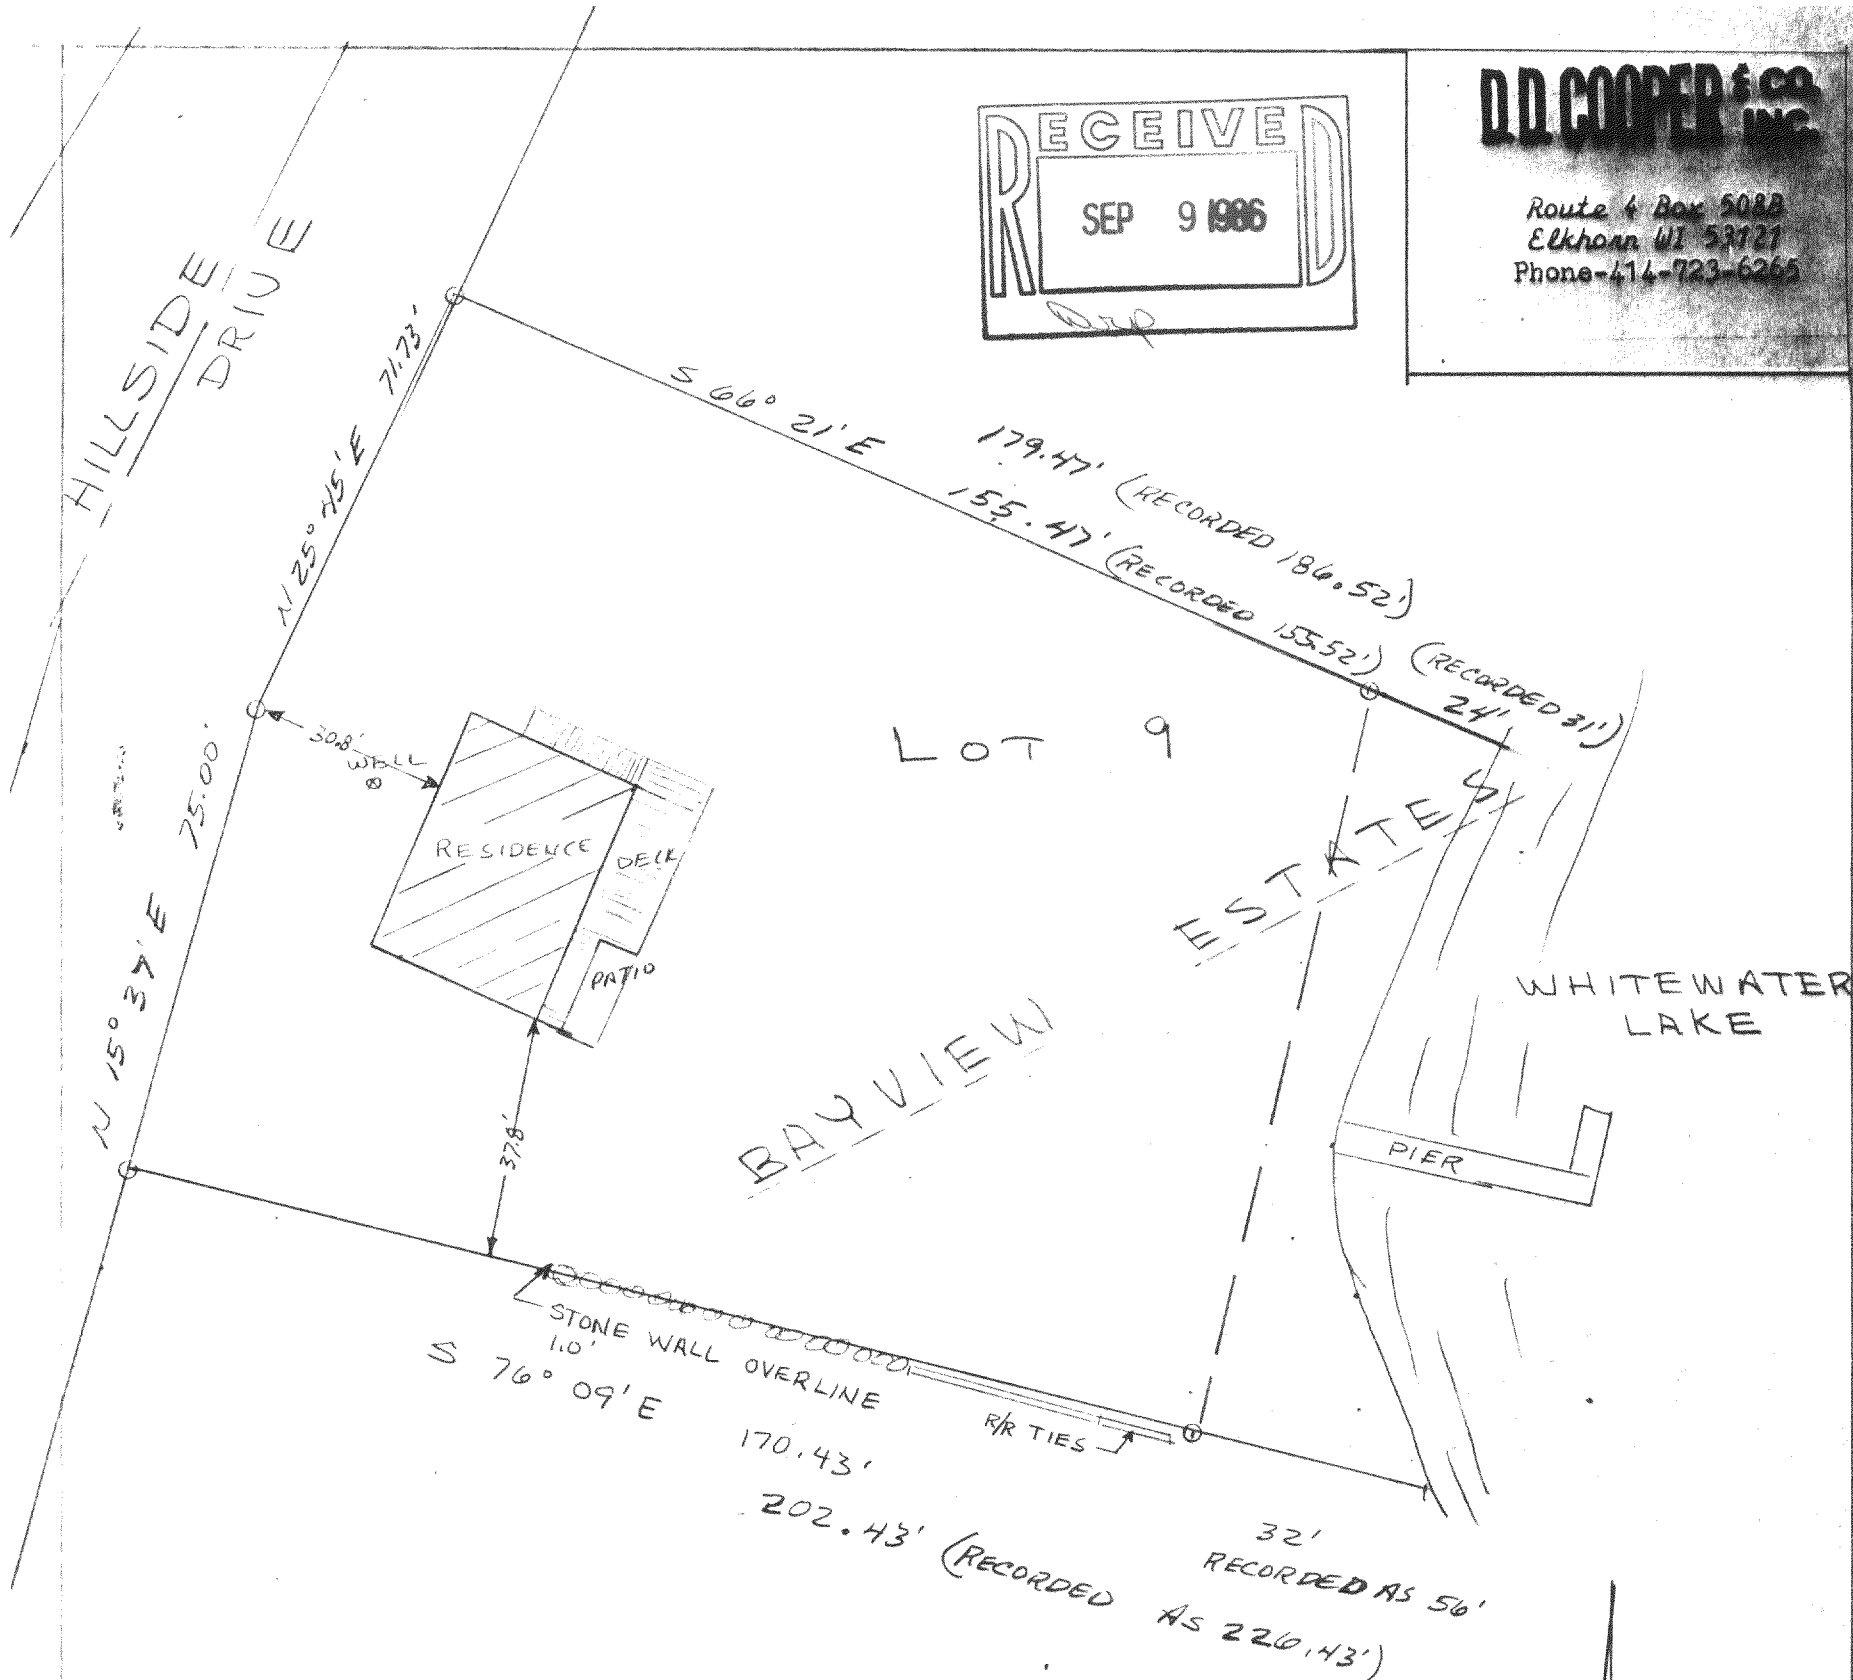

Plat of survey of lot 9 Bayview Estates being located in the Town of Whitewater, Walworth County Wisconsin

Survey ordered by Century 21 - Delavan

SCALE 1"=30'

I, Daniel D. Cooper, Registered Land Surveyor do hereby certify that I have surveyed the property described hereon and that the map shown hereon is a true and accurate representation thereof to the best of my professional knowledge and belief.

Dated this 7th day of July 1986

Daniel D. Cooper

Daniel D. Cooper, RLS NO. S-1464



DRAWING NO. 2260-5-26

DBVE-9

TAX NO. DBVE 00009